


[illegible]

Barrington
CONSULTING GROUP, INC.
9114 TYLER BLVD., MENTOR, OHIO 44060
PHONE 440.205.1260 FAX 440.205.1262
www.BarringtonCGL.com

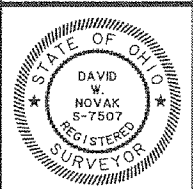


SITE PLAN
6891 BRIDGECREEK DR., CONCORD TWP., OHIO 44077
SIL 5 BRIDGECREEK ESTATES VOL. 50 PG. 3

ENZOCO HOMES

DRAWN WSO
CHECKED DWN
DATE MAY 16, 2014
SCALE 1" = 30'
JOB NO. 14053-005
SHEET 2/3

OF SHEETS

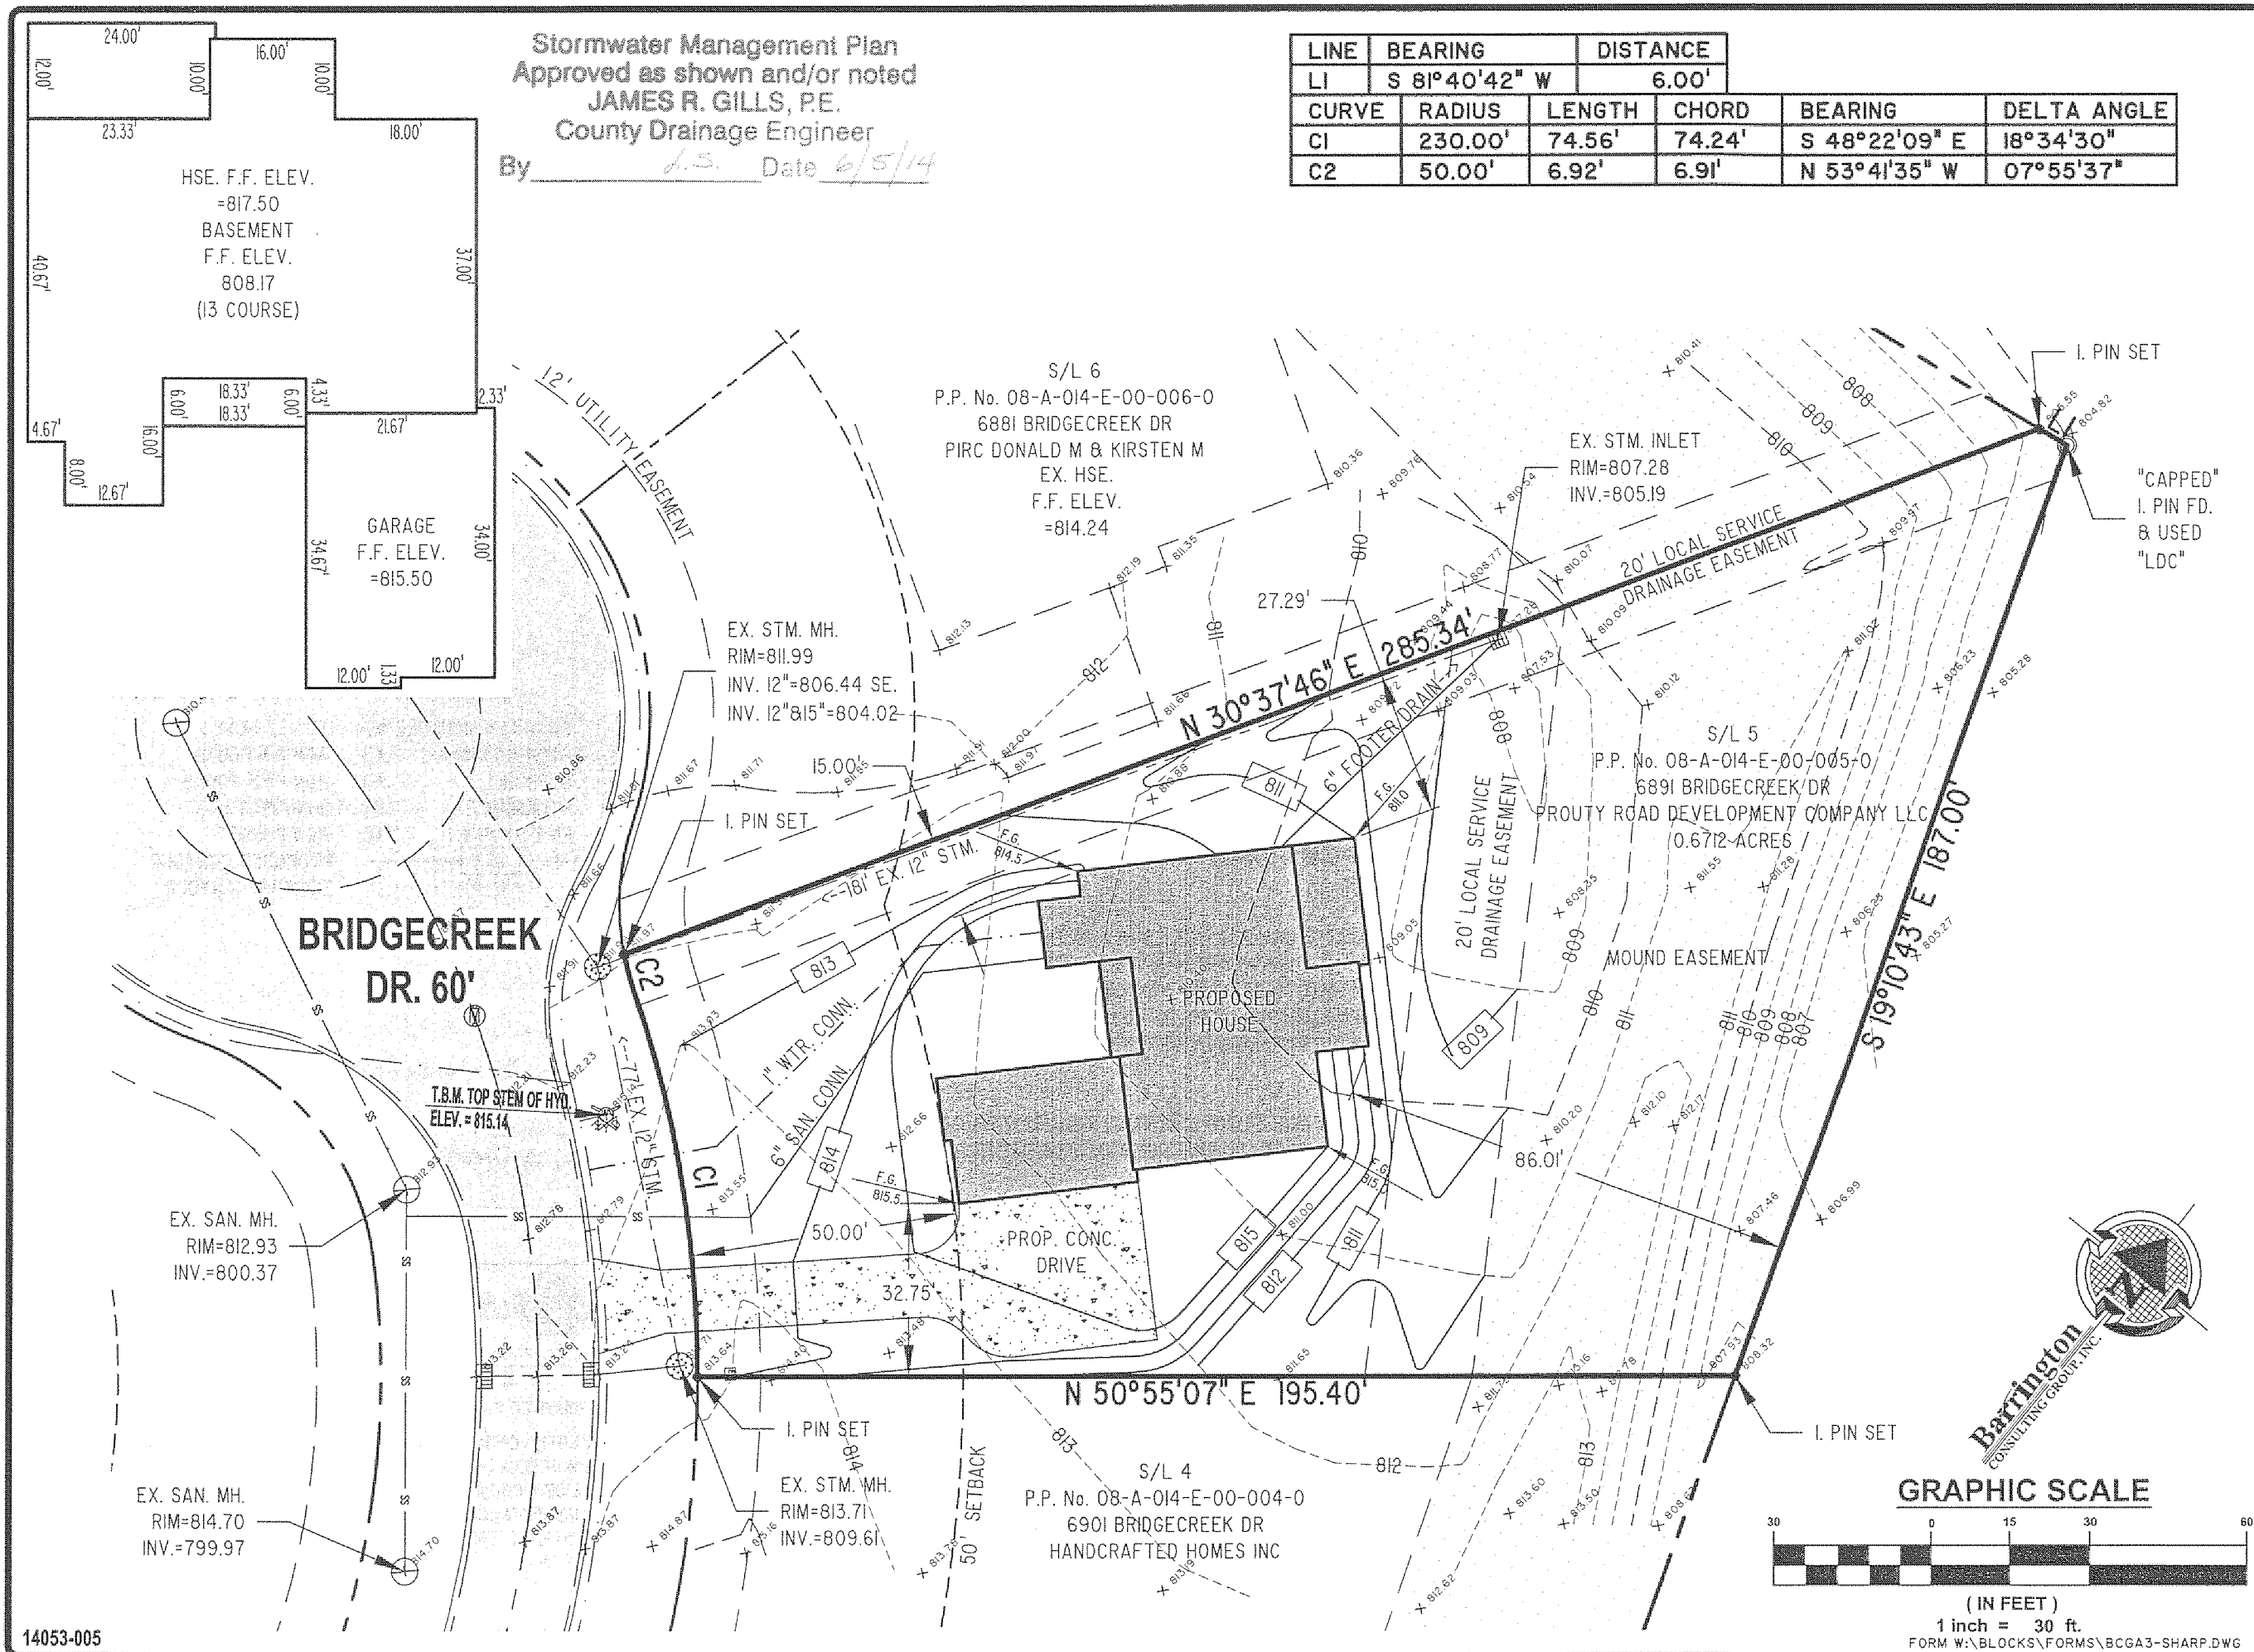

Barrington
CONSULTING GROUP, INC.

Civil Engineers - Surveyors - Land Planners

9114 TYLER BLVD. MENTOR, OHIO 44060
PHONE 440.205.1260 FAX 440.205.1262
www.BarringtonCGI.com