


UNDERGROUND UTILITIES
THE SIZE AND LOCATION OF THE
UTILITIES SHOWN HEREON
HAVE BEEN OBTAINED FROM
RECORDS OF THE
CONTRACTOR. THE
CONTRACTOR SHALL VERIFY
THE DEPTH AND LOCATION
OF ALL UTILITIES
BEFORE CONSTRUCTION.
NOTES: 1-800-362-2164

NOTE:
ALL EROSION AND SEDIMENT CONTROL SPECIFICATIONS
ARE TO BE IN ACCORDANCE WITH THE LAKE COUNTY
EROSION AND SEDIMENT CONTROL RULES AS
ADOPTED DECEMBER 21, 1999

Parcel #
08A014-E
00011-0
SCALE 1"=30'
25 50
APRIL, 2006

CONCORD TOWNSHIP ZONING OFFICE
Zoning Permit # 040612055-0508-134B1
Date Issued 5/14/08
Subject to Approval By:
☒ Lake Co. Engineer/Storm Water Mgmt.
☒ Lake Co. Utilities Dept.
☒ Lake Co. Soil + Water District
☒ Lake Co. Health District
☐ Lake Co. Building Dept.

LAWRENCE DAKIN
DC#2002R044427
NOT PART OF SUB.

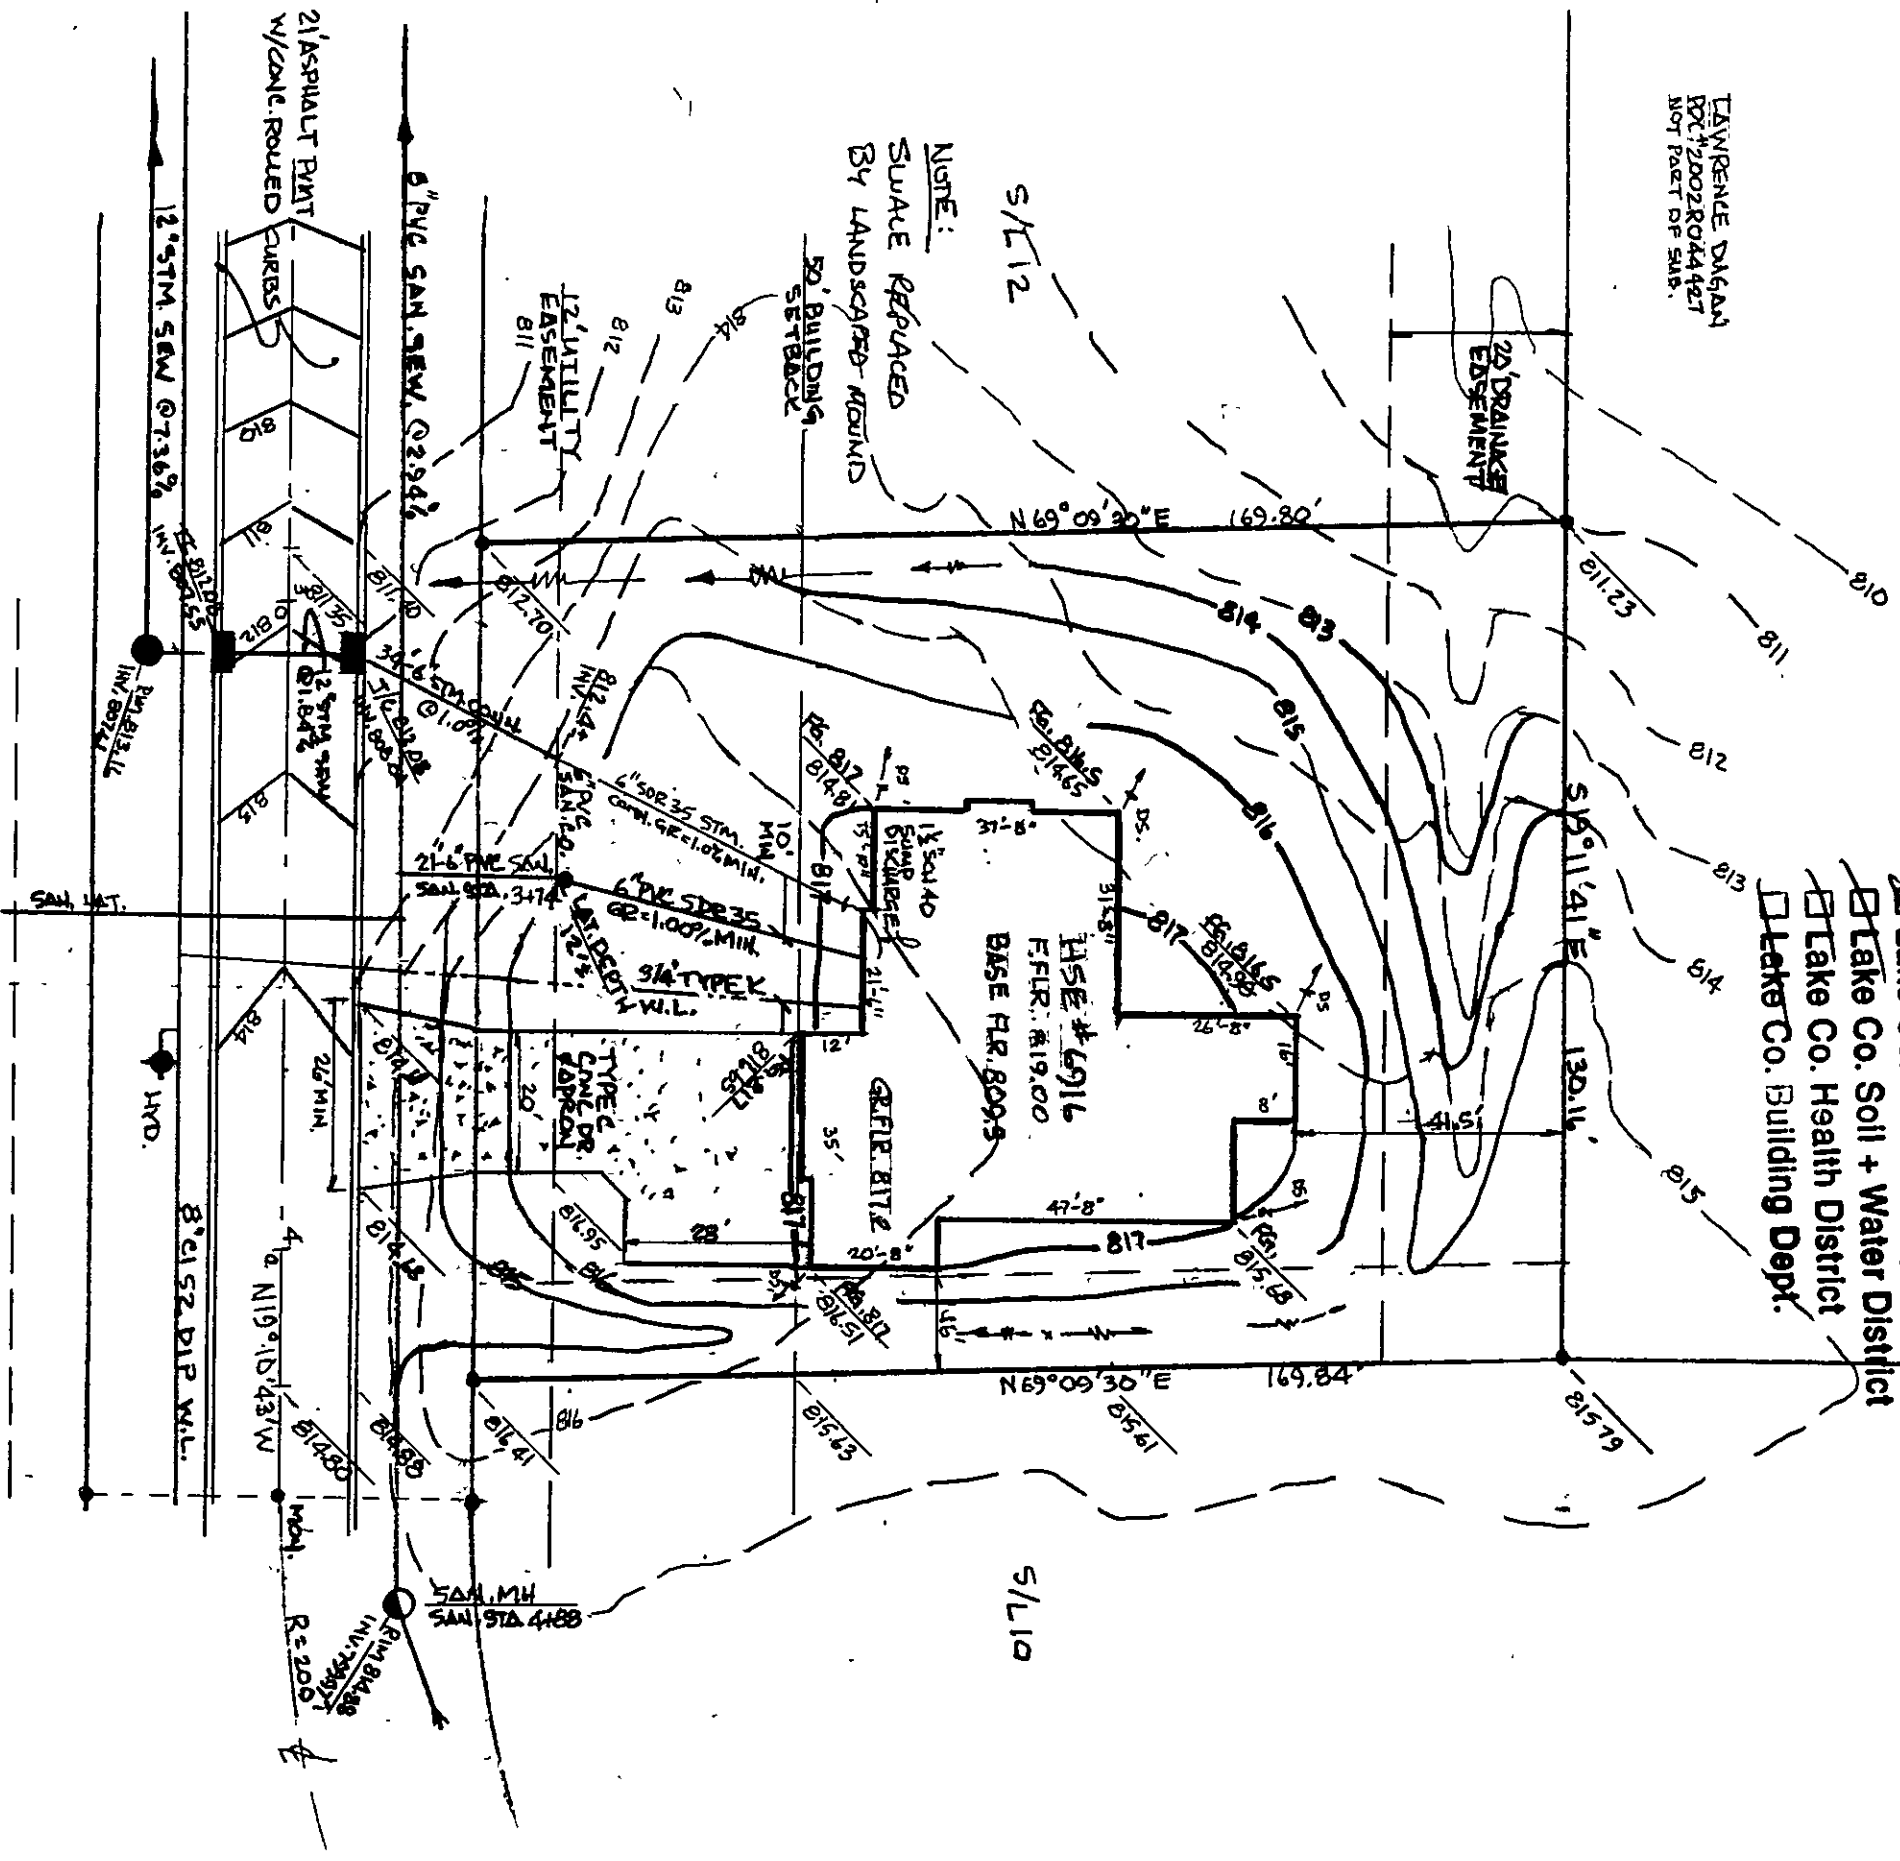

BRIDGE CREEK DRIVE ~ 60'

Stormwater Management Plan
Approved as shown and/or noted
JAMES R. GILLS, P.E.
County Drainage Engineer
By A.S. Date 5/15/08

SITE PLAN

FOR: COUNTRYSIDE HOMES

8236 WESTVIEW NOVELTY, OHIO

11 BRIDGE CREEK ESTATES 50 3

SUBJECT NO. SUBDIVISION VOL Pg.

CITY/TOWNSHIP LAKE OH STATE



SURVEYOR
THIS PLAN WAS PREPARED BY
ME AND IS SUBJECT TO THE BEST
OF MY KNOWLEDGE AND BELIEF
GARY A. PAINE REG. SURVEYOR
NO. 6571

LEGEND
STORM M
SANITARY M
WATERLINE CONN.
EXISTING CONTOURS
PROPOSED CONTOURS
PROPOSED ELEV. 10000
EXISTING ELEV. 10000
DIRECTION OF SURFACE DRAINAGE