



UNDERGROUND UTILITIES
THE SIZE AND LOCATION, HORIZONTAL AND VERTICAL, OF THE UNDERGROUND UTILITIES SHOWN HEREON HAVE BEEN OBTAINED FROM AVAILABLE RECORDS, VERIFICATION BY FIELD OBSERVATION HAS BEEN CONDUCTED WHERE PRACTICABLE. HOWEVER, NEITHER THE COMPLETENESS NOR THE ACCURACY ARE GUARANTEED. THE CONTRACTOR SHALL VERIFY DEPTH AND LOCATION OF UTILITY CONNECTIONS. OUP's: 1-800-362-2764

NOTE:
ALL EROSION AND SEDIMENT CONTROL SPECIFICATIONS ARE TO BE IN ACCORDANCE WITH THE LAKE COUNTY EROSION AND SEDIMENT CONTROL RULES AS ADOPTED DECEMBER 21, 1999
*SEE ATTACHED PLAN.

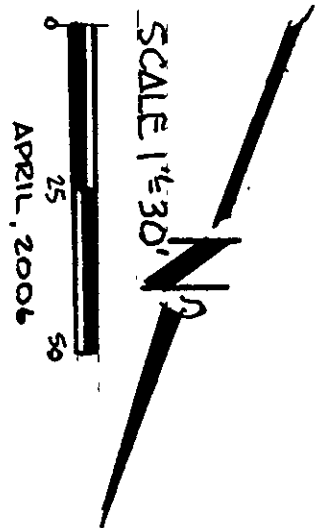


LAWRENCE DIAGAN
PC#2002R044421
NOT PART OF S&B.

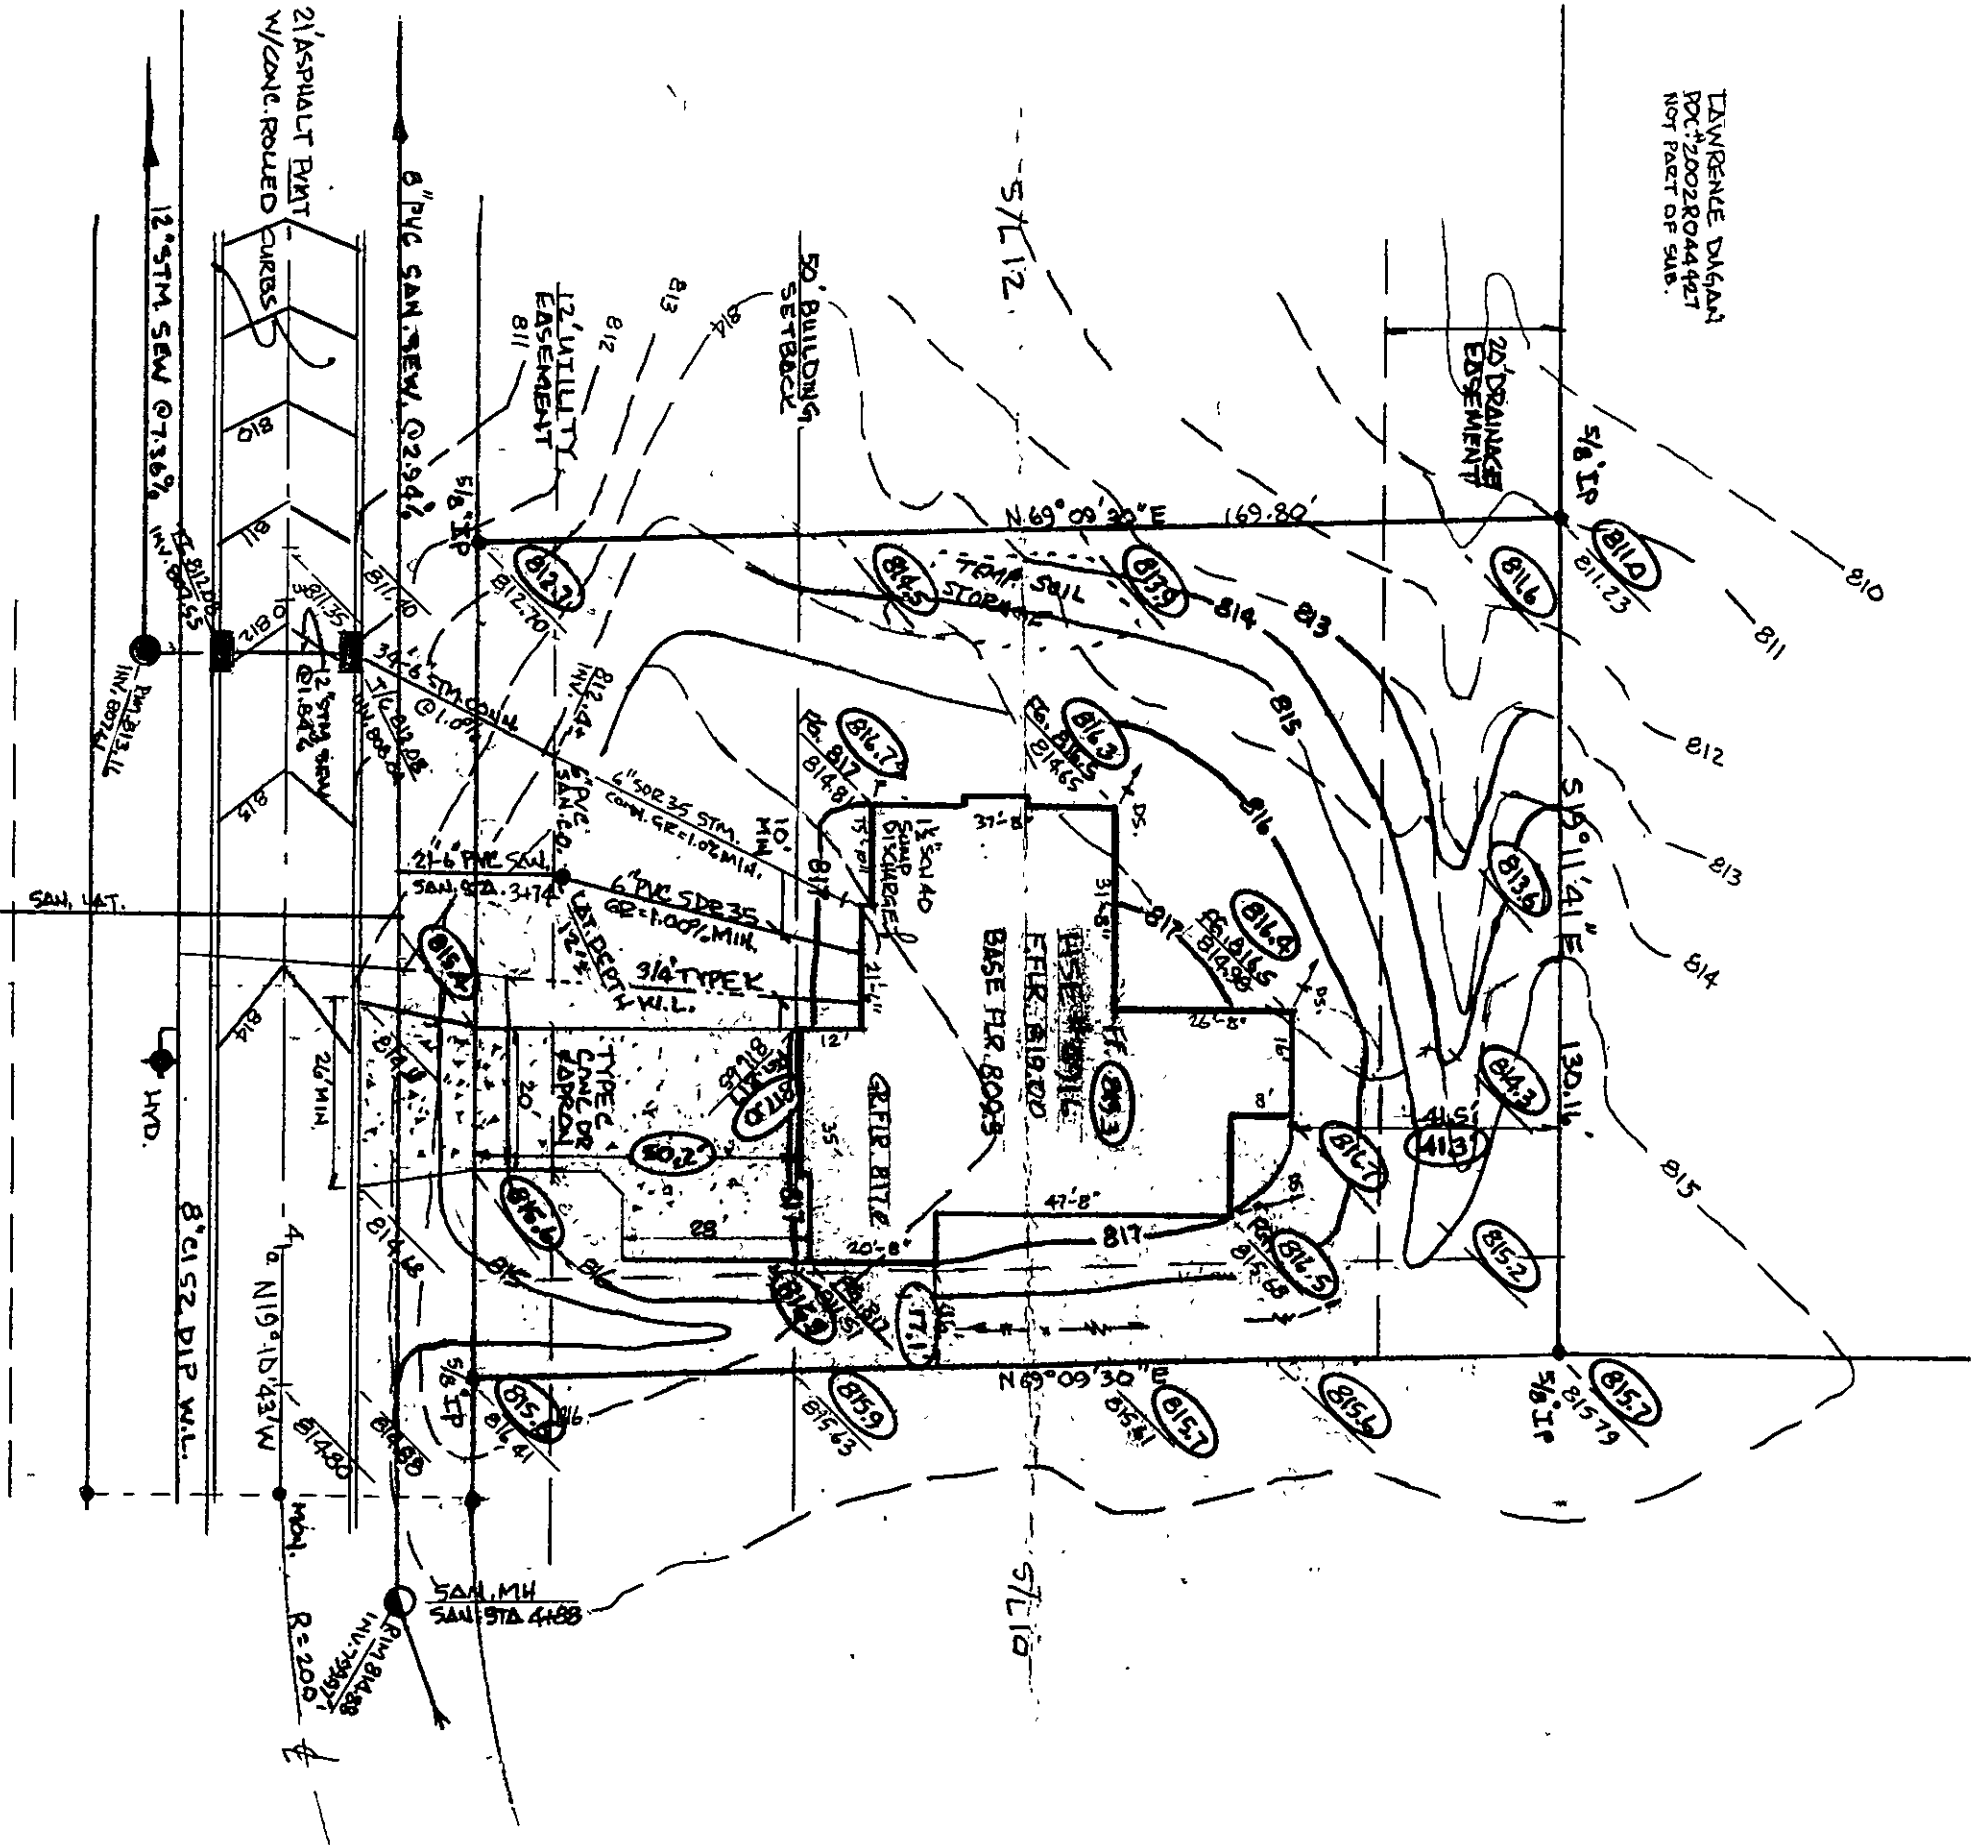

BRIDGE CREEK DRIVE - 60'

LEGEND
STORM M
SANITARY M
WATERLINE CONN.
EXISTING CONTOURS
PROPOSED CONTOURS
PROPOSED ELEV. E.g. 1000.0
EXISTING ELEV. 1000.0
AS-BUILT INFORMATION
DIRECTION OF SURFACE - W

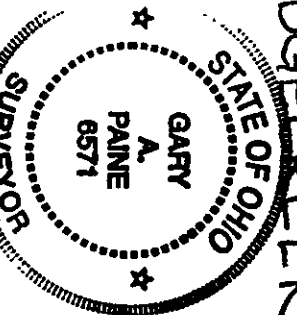

PLAN WAS PREPARED BY
AND IS CORRECT TO THE BEST
OF MY KNOWLEDGE AND BELIEF
GARY A. PAINE REG. SURVEYOR
NO. 6571

"AS BUILT" CERTIFICATION
I HEREBY CERTIFY THAT THE
CIRCLED INFORMATION IS EXISTING
AS OBTAINED ON THE SITE IN 2009
AND IS CORRECT TO THE BEST OF
MY KNOWLEDGE AND BELIEF
NAME: GARY A. PAINE # 6571

SITE PLAN

FOR: COUNTRYSIDE HOMES
8236 WESTRIVER NOVELTY OHIO
SUBDIVISION
BRIDGE CREEK ESTATES SD 3
CONCORD LAKE VOL. 15
CITY/TOWNSHIP COUNTY STATE
P04.08-A-014-E-00-011-0