

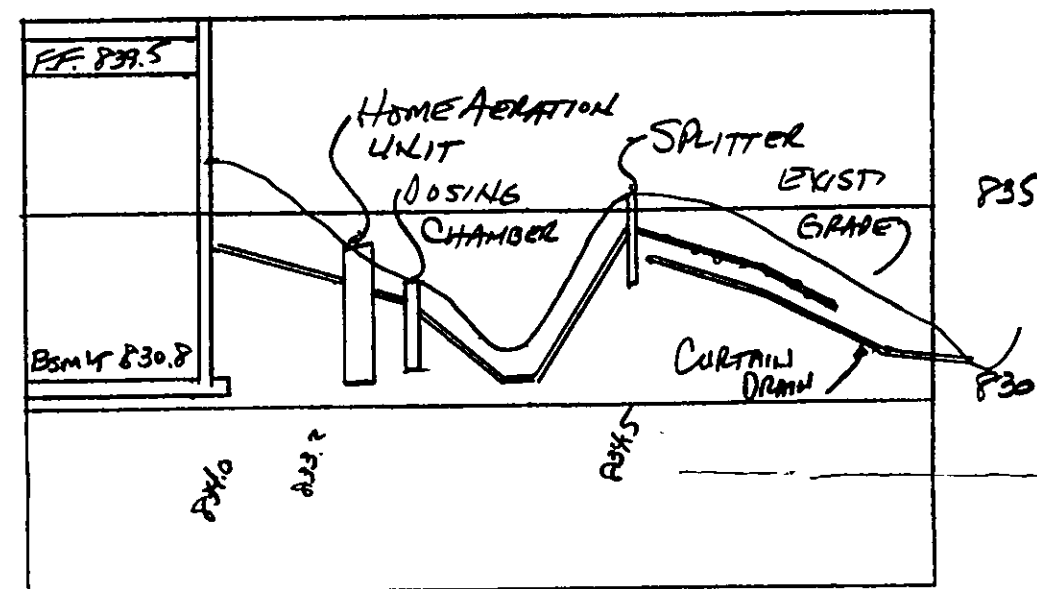
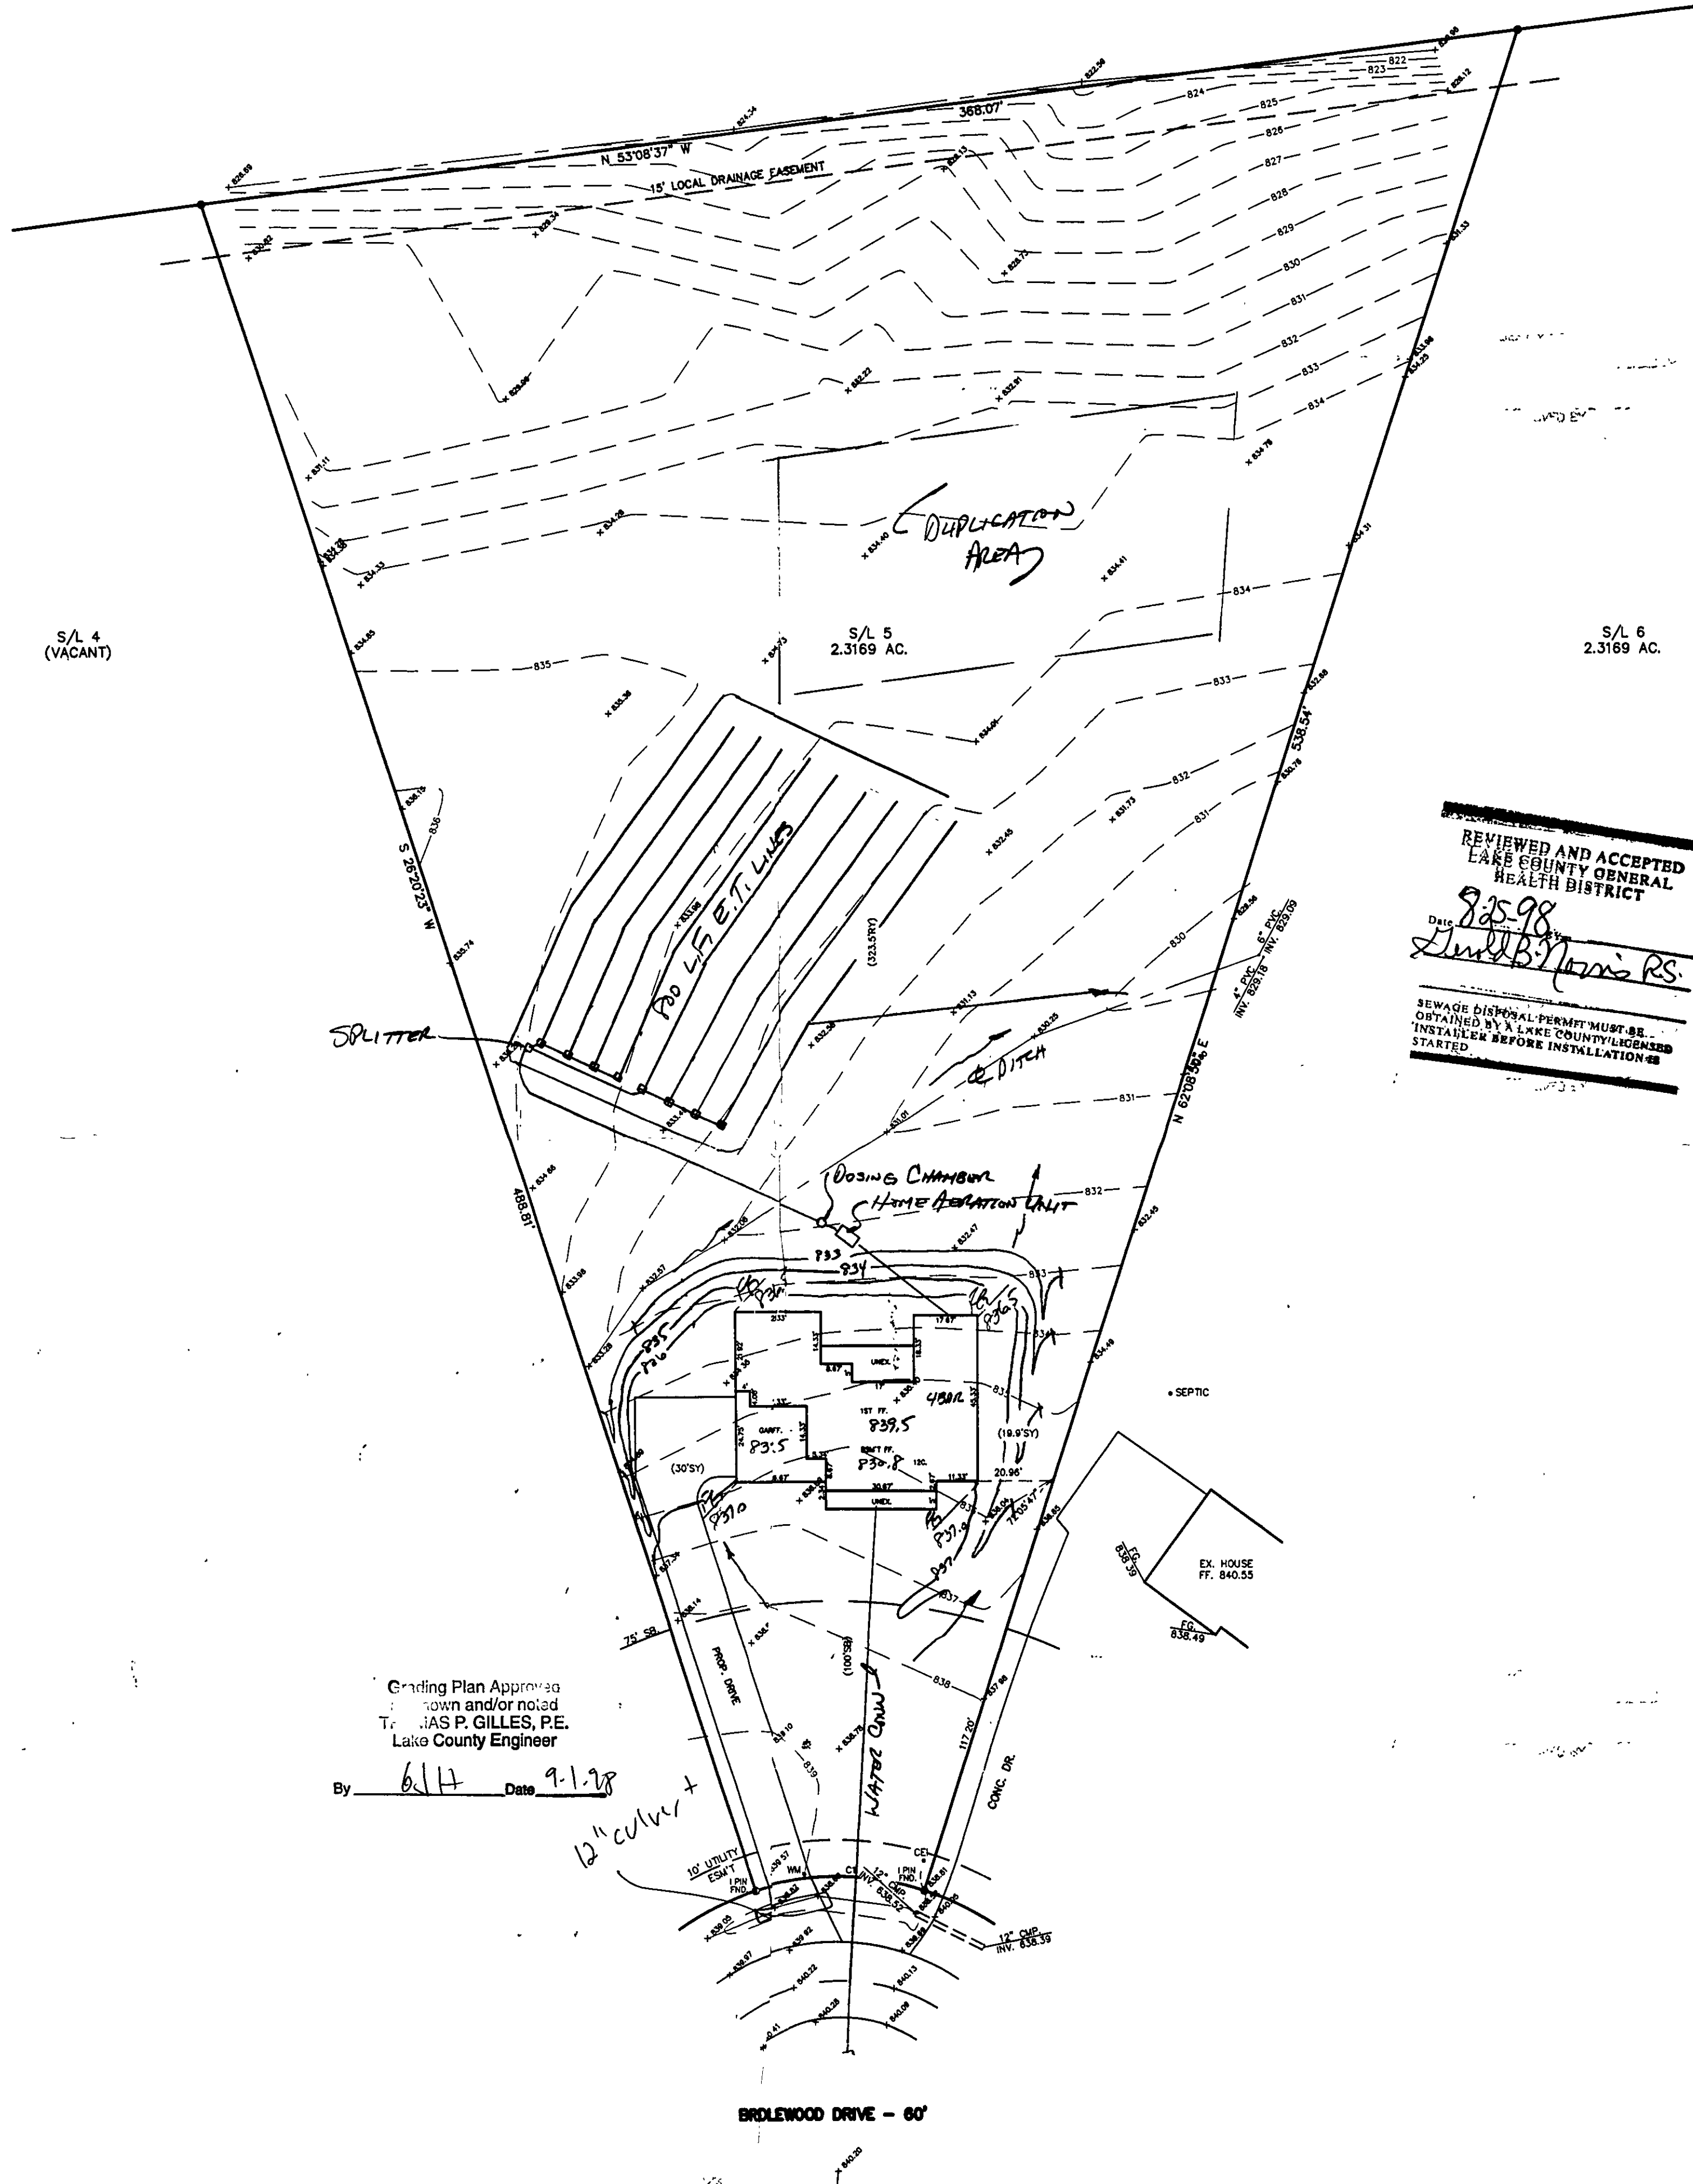


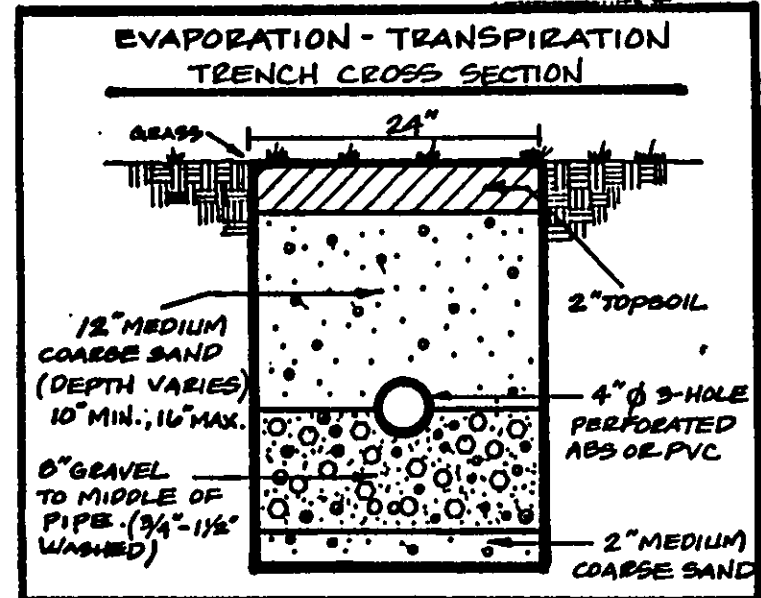

HYDRAULIC PROFILE
HORIZ. 1"=30' VERT. 1"=5'

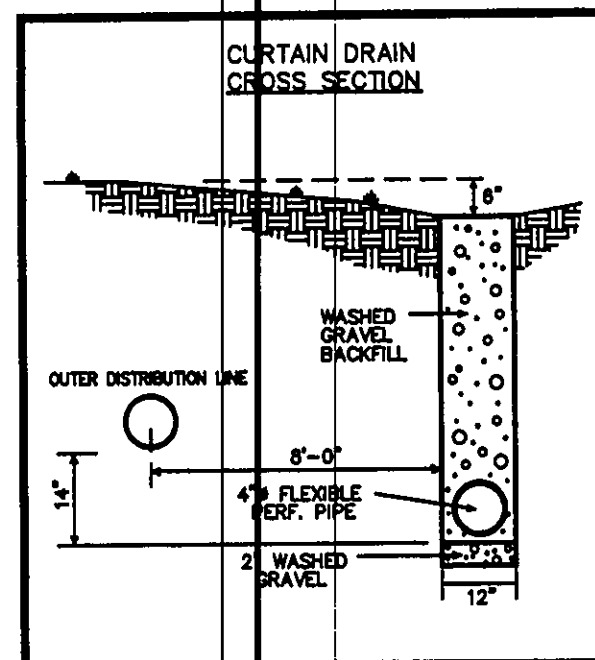

Grading Plan Approved
shown and/or noted
T. JAS P. GILLES, P.E.
Lake County Engineer

By 6/14 Date 9-1-98

12" CULVERT

BROLEWOOD DRIVE - 60'

REVIEWED AND ACCEPTED
LAKE COUNTY GENERAL
HEALTH DISTRICT
DATE 9-5-98
David B. Morris RS.
SEWAGE DISPOSAL PERMIT MUST BE
OBTAINED BY LAKE COUNTY LICENSEE
INSTALLER BEFORE INSTALLATION IS
STARTED.



TBM-TOP HYDRANT S/L 7
ELEV.=841.71

CR: R=80.00'
A=50.00'
C=49.19'
D=35°48'27"
T=25.85'
N45°45'23"W

"I, the undersigned hereby certify that this topography indicated by 6", 1' or 2' contours, and elevations shown hereon represent an actual field survey made by me on the 13th day of Aug, 1998 and that the elevations were taken at appropriate intervals and that as of that date they existed as indicated hereon."

Name Harry Jones + 6343 Reg.No.

REV NO.	DESCRIPTION	DATE	BY	CHK'D

bj BABCOCK, JONES AND ASSOCIATES, INC
CIVIL ENGINEERS - SURVEYORS - LAND PLANNERS
PAINESVILLE OHIO 44077

DATE 8/13/98
DESIGN BY H.J.
DRAWN BY T.R.
APPROVED BY H.J.

SITE PLAN
FOR
KAY HOMES
CONCORD TOWNSHIP
LAKE COUNTY

SCALE: 1"=30'
JOB NO. 98-263-05
SHEET 1 OF 1