
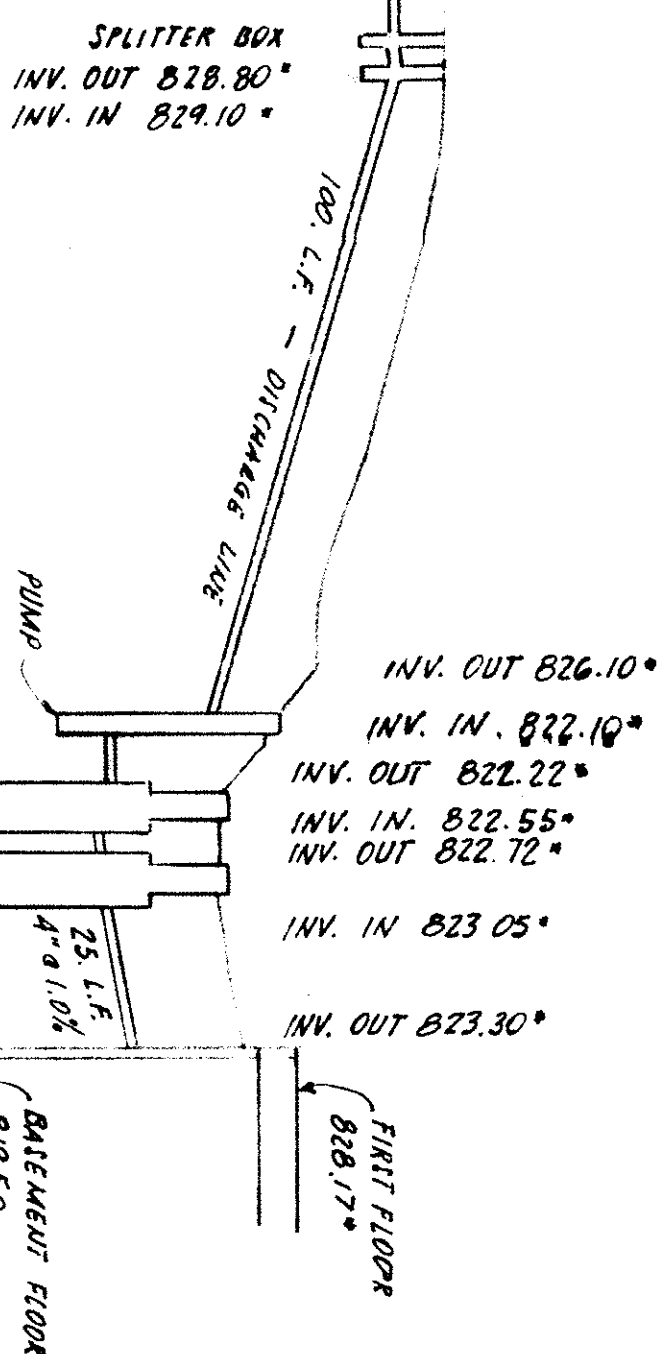
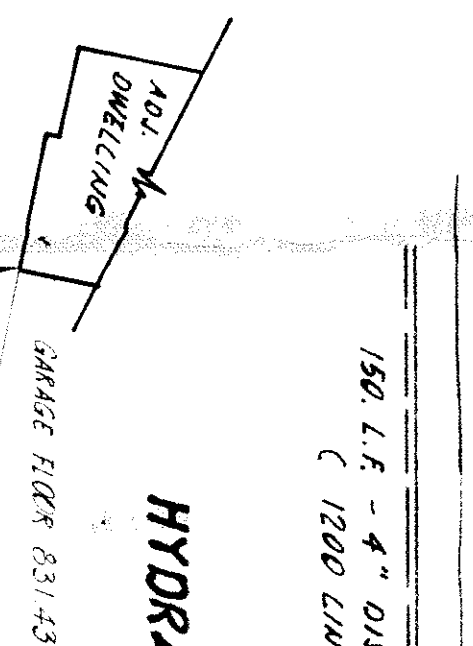
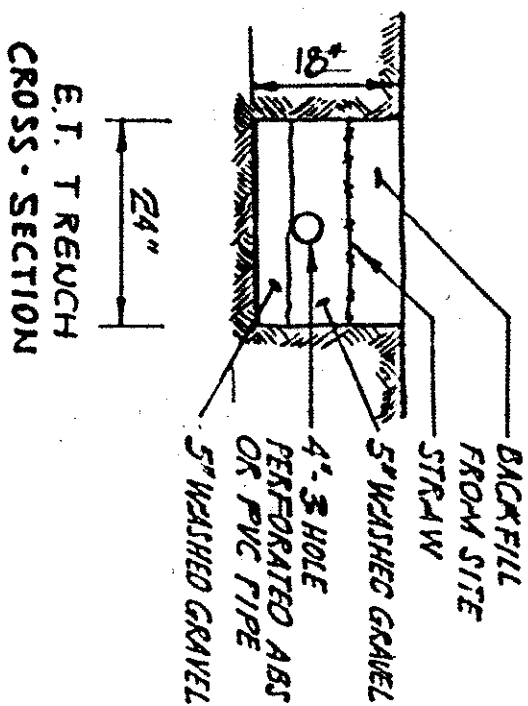


SITE IMPROVEMENT PLAN


SUBLOT NO. 7 IN LEDGEWOOD CROSSING AT THE FALLS SUBDIVISION
TOWNSHIP OF CONCORD, COUNTY OF LAKE, OHIO.

BUILDER: BETTER BUILDERS, INC.

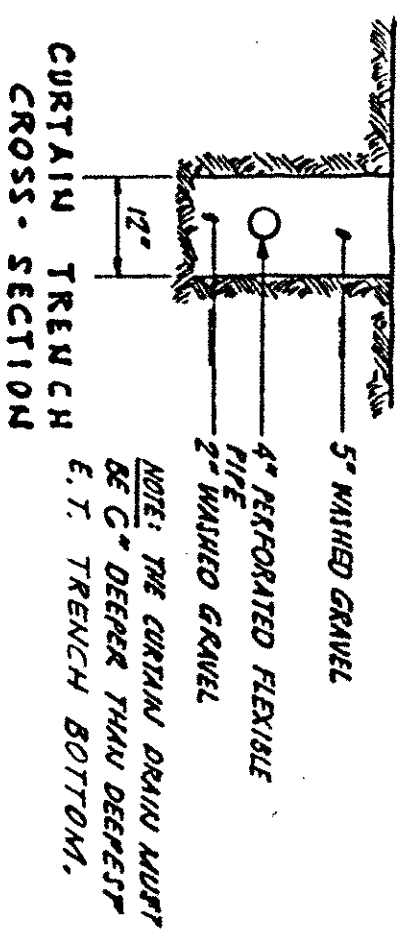

Roof drains shall discharge to splash blocks.

By THOMAS P. GILLES, P.E.
Lake County Engineer
Date 6/11/93

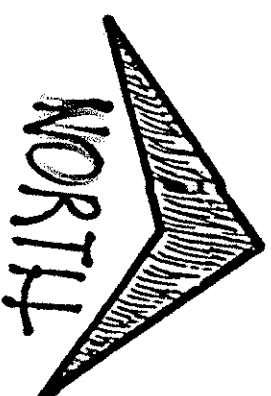

SCALE: 1" = 30'
NOV. 1993

REVISED NOV. 30, 1993
PER BABCOCK, JONES & ASSOCIATES, INC.
REVISU PER BUILDER
DEC. 6, 1993 - MKI
REVISED LOCATION OF HOME,
PROPOSED FINISH GRADE.
DEC. 16, 1993 - MKI
REVISED 12-22-93 MKI

"I, the undersigned hereby certify that the topography shown hereon, indicated by one foot contours and elevations represents an actual field topographic survey made by me on the 15th day of November, 1993 and that the elevations were taken at appropriate intervals and that as of that date they existed as indicated hereon."

REGISTERED SURVEYOR
REG. NO. 5471

HOWARD R. SELEE & ASSOCIATES, INC.

PROFESSIONAL LAND SURVEYORS
9701 BROOKPARK ROAD • SUITE 251 • CLEVELAND, OHIO 44129 • (216)398-0280

