
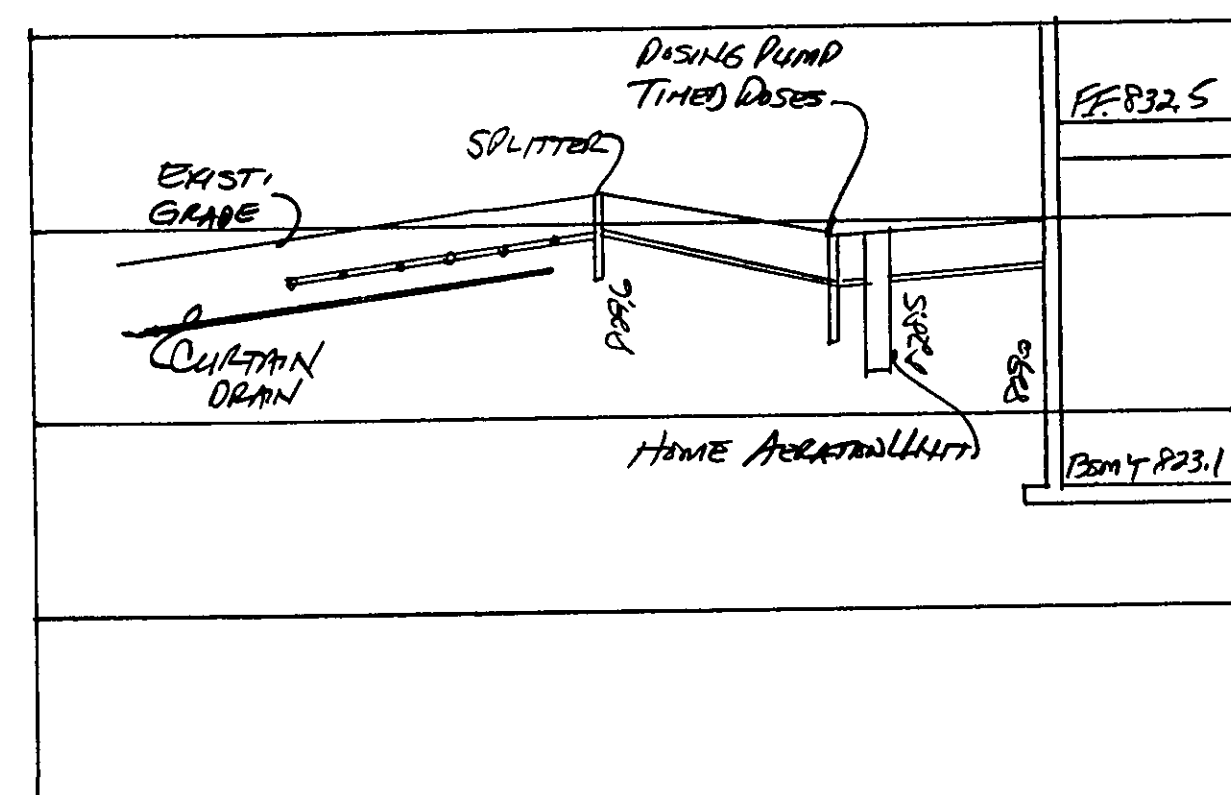
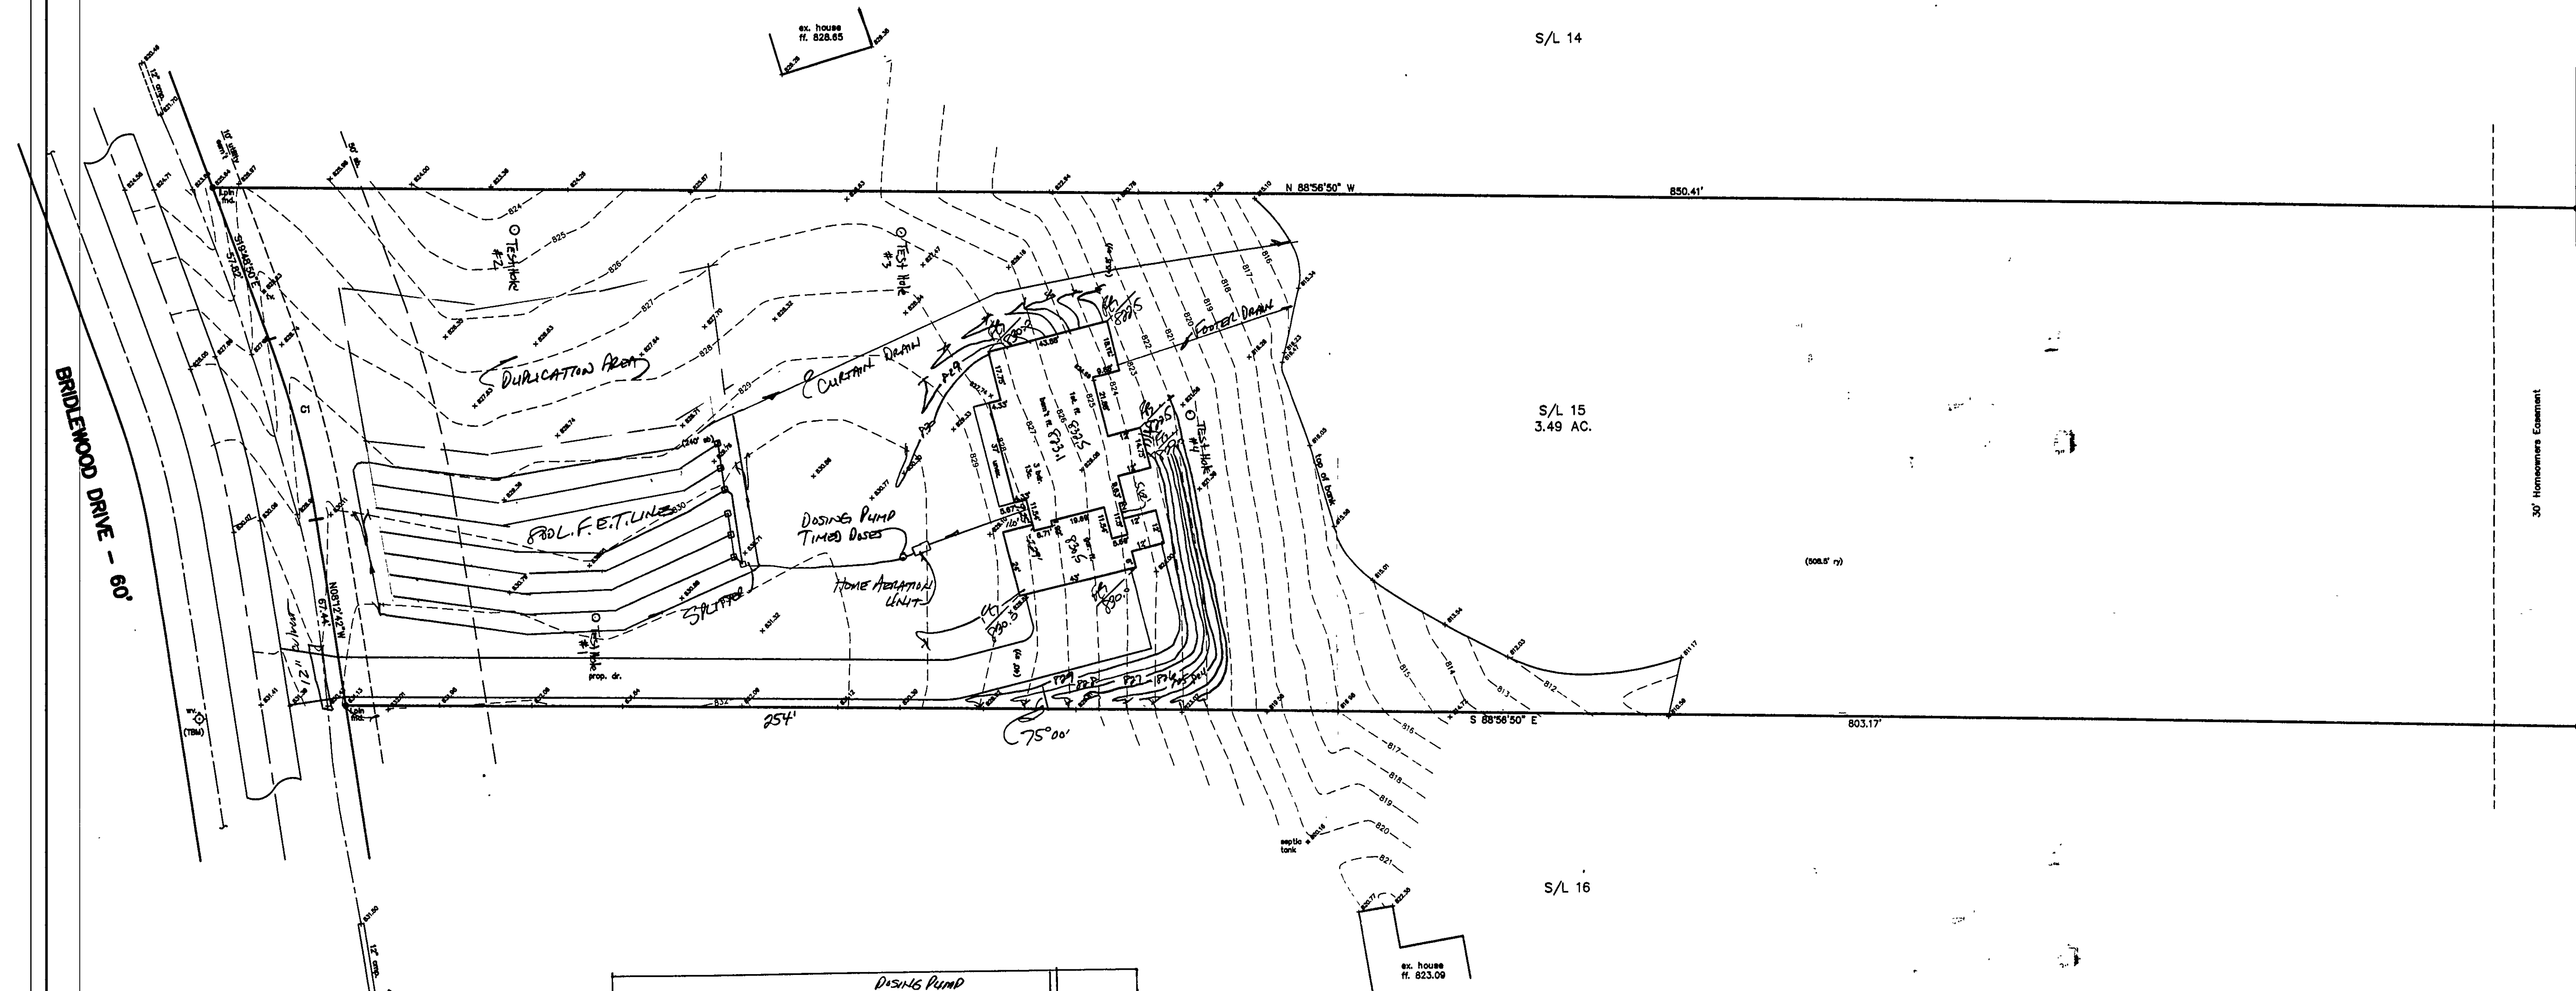
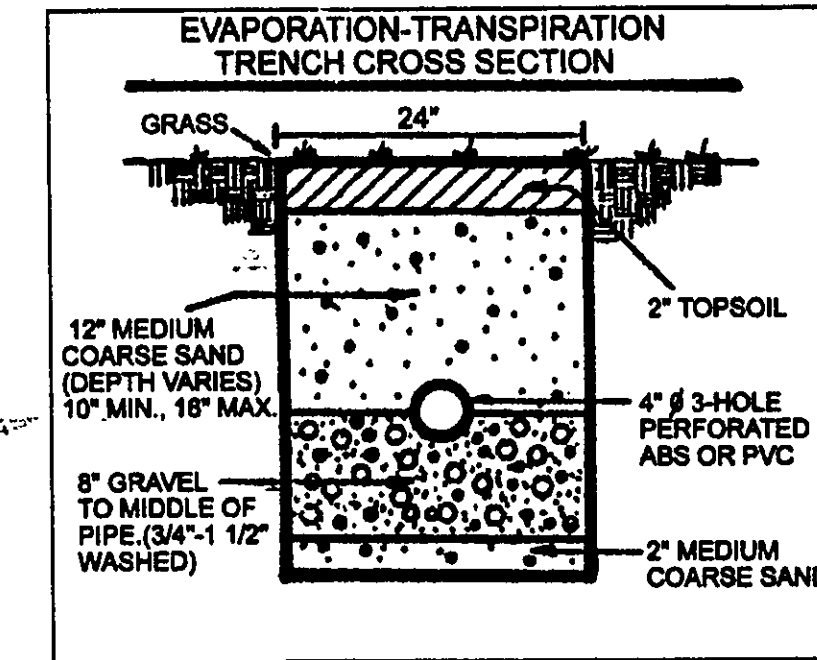
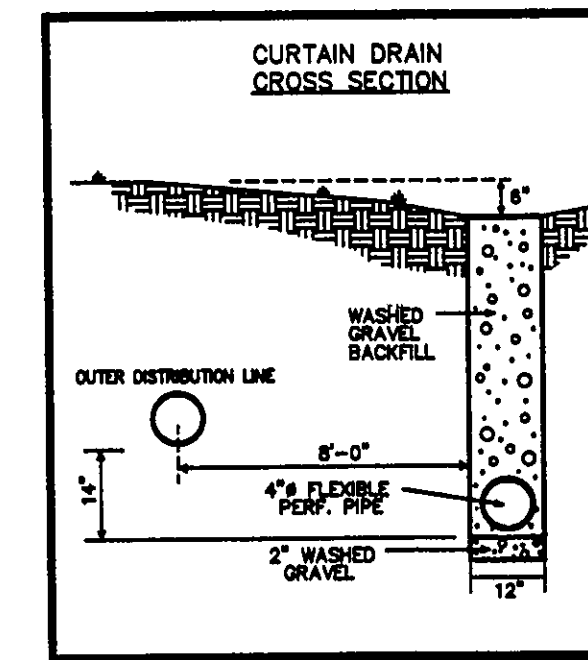


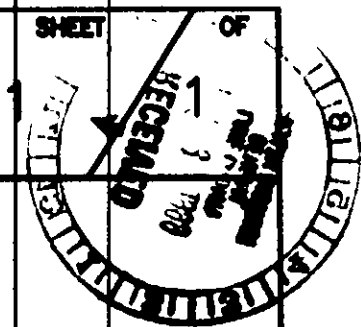

HYDRAULIC PROFILE
HORIZ: 1"=30' VERT: 1"=5'


REVIEWED AND ACCEPTED
LAKE COUNTY GENERAL
HEALTH DISTRICT
Date: 11-12-99 BY: D.L.H.
SEWAGE DISPOSAL PERMIT MUST BE
OBTAINED BY A LAKE COUNTY LICENSED
INSTALLER BEFORE INSTALLATION IS
STARTED

Grading Plan Approved
as shown and/or noted
THOMAS P. GILLES, P.E.
Lake County Engineer
By: T.M. Date: 11/19/99
12" DRIVE CULVERT REQUIRED
REFERENCE ZONING PERMIT # 11029
0623

"I, the undersigned hereby certify that
this topography indicated by 6", 1", or 2"
contours, and elevations shown hereon
represent an actual field survey made by
me on the 12th day of OCT, 1999
and that the elevations were taken at
appropriate intervals and that as of that
date they existed as indicated hereon."
Harry Jones #6343
Notary Reg. No.

TBM-TOP OF HYDRANT
ELEV.=833.58

C1: R=330.00'
L=66.82'
T=33.53'
D=11°36'08"
C=66.71'
N14°00'46"W

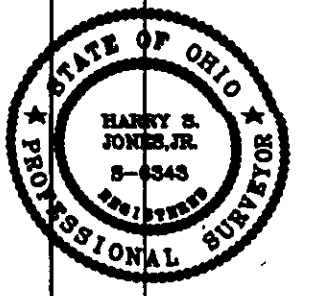

REV. NO.	DESCRIPTION	DATE	BY	CHK'D
1	Added Test Hole Locations	11/8/99	T.R.	T.R.

BABCOCK, JONES AND ASSOCIATES, INC
CIVIL ENGINEERS - SURVEYORS - LAND PLANNERS
PAINESVILLE OHIO 44077

DATE: 10/13/99
DESIGN BY: H.J.
DRAWN BY: T.R.
APPROVED BY: H.J.

SITE PLAN
FOR
KERN BUILDERS
S/L 15 LEDGEWOOD CROSSING
CONCORD TOWNSHIP LAKE COUNTY

SCALE: 1"=30'
JOB NO: 89-034-15
SHEET 1 OF 1