


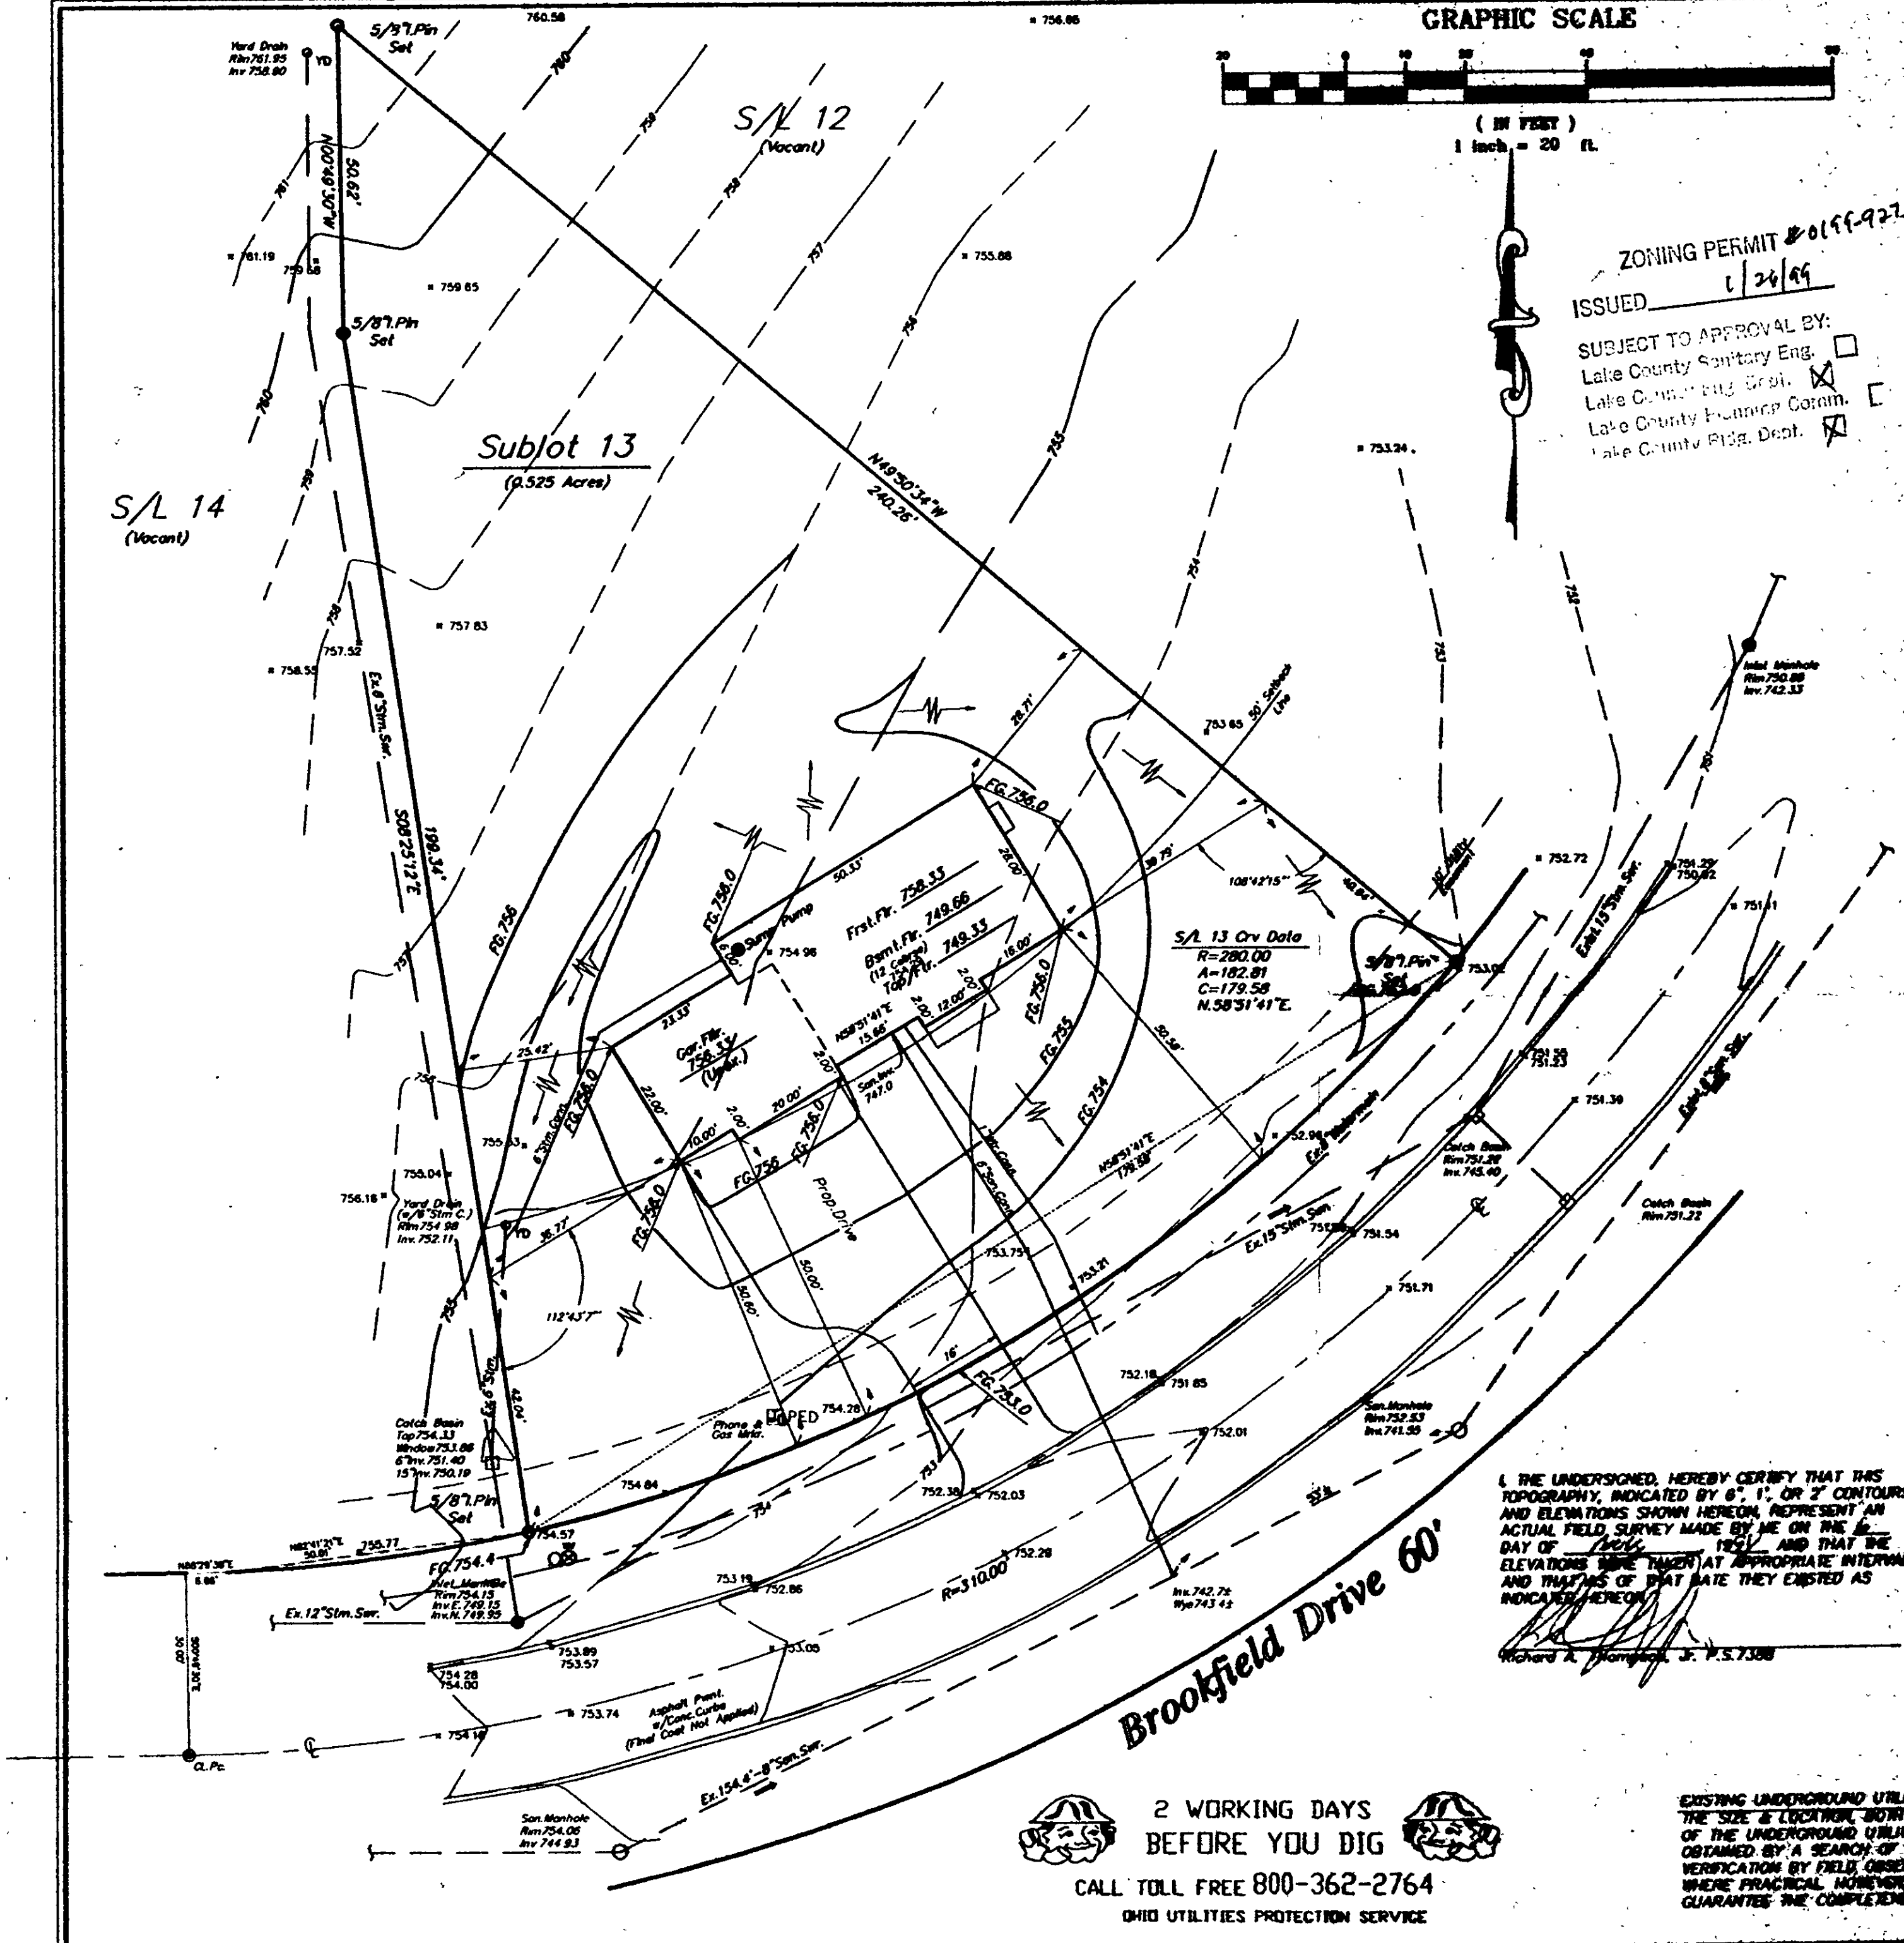

SITE PLAN

for : Johnson & Son Builders

11785 Arbor Glen Dr.

ADDRESS

13 SUBLOT No. 27 LOT

DESIGN CERTIFICATION

THIS PLAN WAS PREPARED BY ME AND I AM A MEMBER OF THE BEST OF MY KNOWLEDGE AND BELIEF.

CHECK LIST

LEGEND

"AS BUILT" CERTIFICATION

I HEREBY CERTIFY THAT THE CHANGES INDICATED BY THE EXISTING AS OBTAINED ON THE SITE 1986 AND IS CORRECT TO THE BEST OF MY KNOWLEDGE AND BELIEF.

BENCHMARK

EXISTING UNDERGROUND UTILITIES NOTE

2 WORKING DAYS BEFORE YOU DIG

CALL TOLL FREE 800-362-2764

OHIO UTILITIES PROTECTION SERVICE