

Erosion and Sediment Control Schedule

<u>Ingress-Egress</u>

A stone access drive complete with under lying geo-textile fabric (20 feet wide and 50 feet long) for ingress and egress at the site shall be installed. This drive shall be the only entrance and exit to the site.

Silt Fence
A silt fence shall be installed prior to any earthwork activities at the site in the locations shown on the site plan as well as along the front of any lot that slopes towards the street.

twenty—one(21) days shall be properly seeded and straw mulched within seven(7) days of completion of intitial grading.

Temporary seeding and mulching as a thirty(30) foot strip of the entire front of the lot shall be maintained on the site once initial grading is complete.

Stabilization of critical areas within fifty(50) feet of any stream or wetland shall be complete within two(2) days of the disturbance if the site is to remain inactive for longer than fourteen(14) days.

Mulching
Straw—mulch shall be applied at a rate of 1 bale per every ten (10) feet of curb, at a width of thirty(30) feet to the entire length of the lot. Wood chips may also be used but must be spread at a minimum depth of four inches over the thirty—foot width and must be accompanied by a properly installed silt

Erosion and sediment controls shall be inspected every seven(7) days or within 24 hours of a 0.5" or greater rainfall event.


Necessary repairs shall be made at this time.


CONCORD TOWNSHIP ZONING OFFICE Zoning Permit #\_0205 = 12316

Date Issued \_\_\_\_\_ 7/15/05 Subject to Approval By: Lake Co. Engineer/Storm Water Mgmt. Lake Co. Utilities Dept. Lake Co. Soil + Water District


Lake Co. Health District

Lake Co. Building Dept.

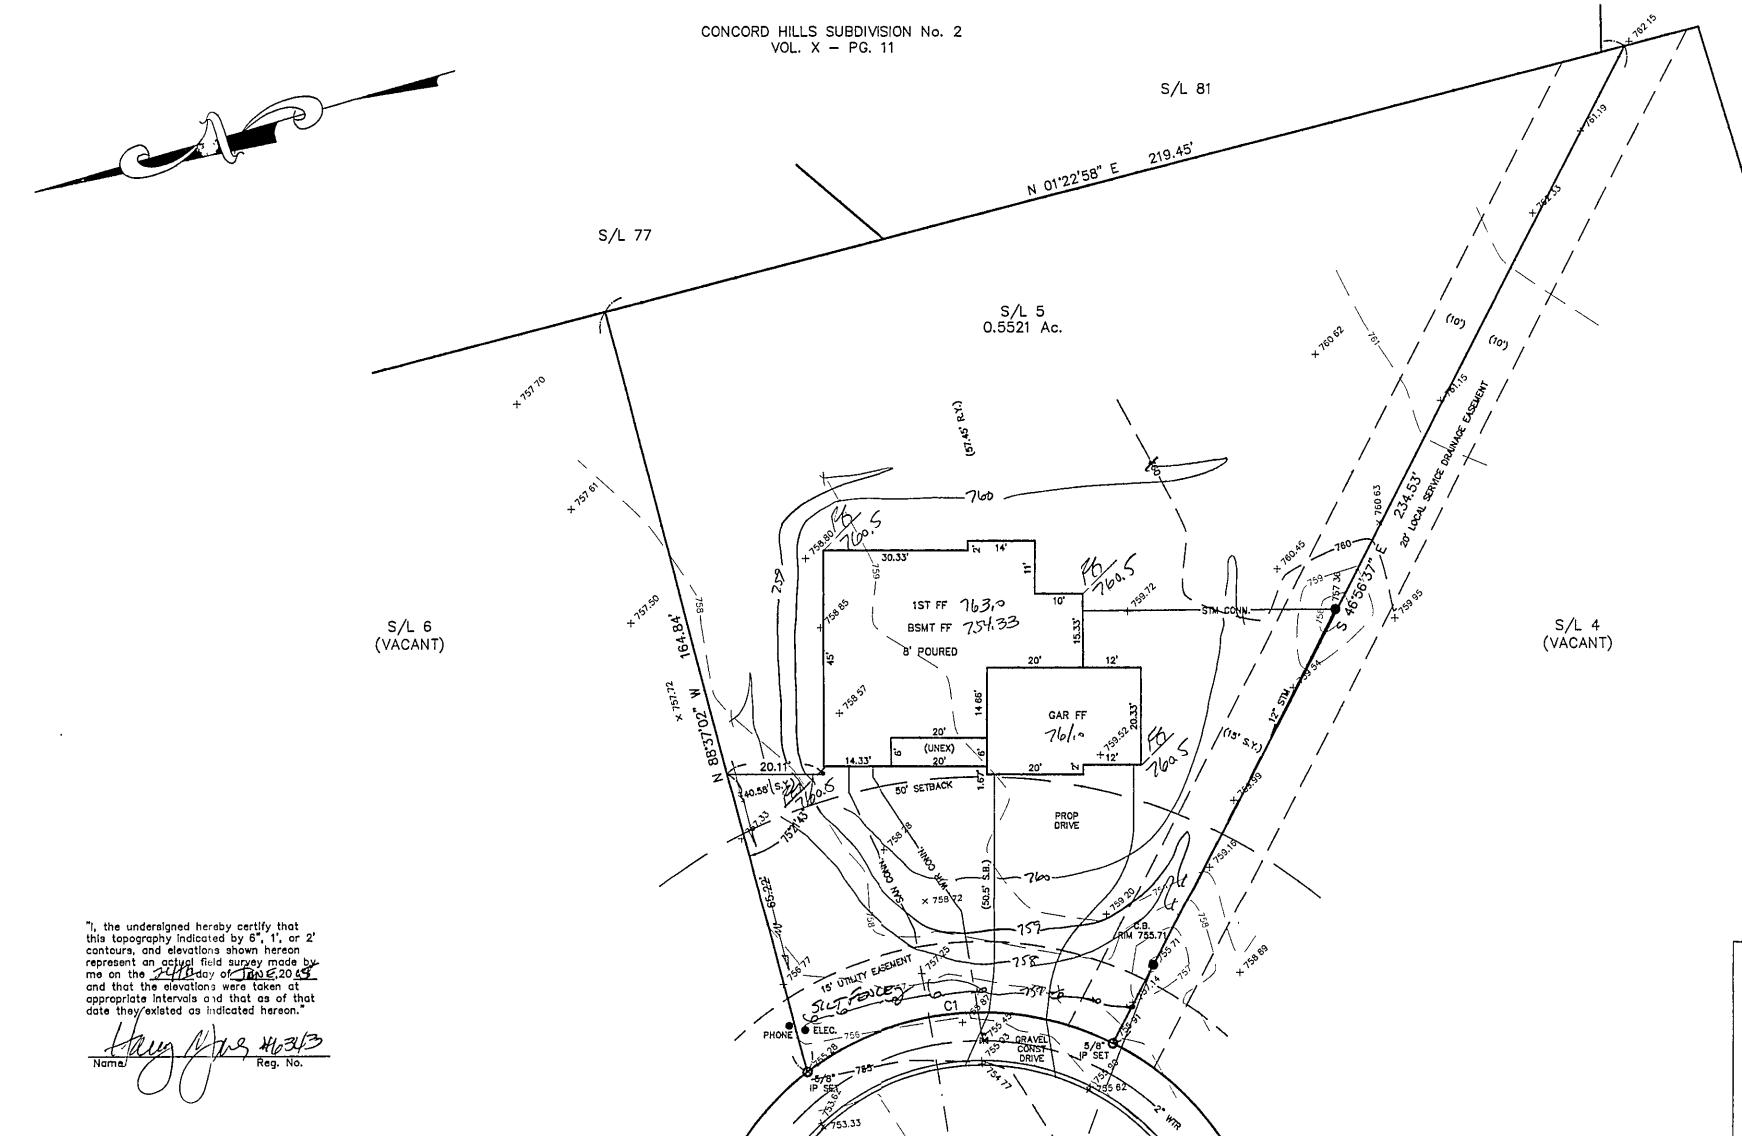

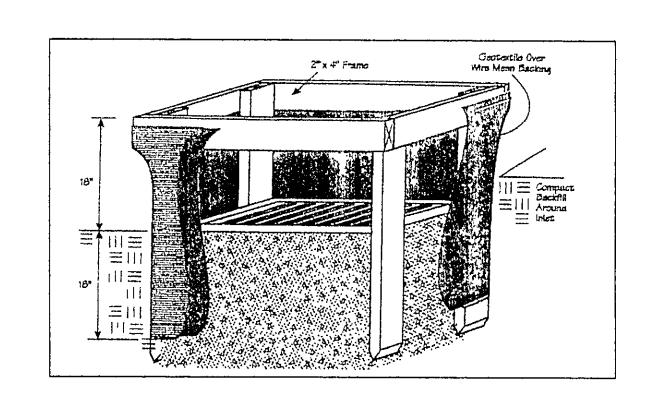

Seeding Dates	Species	Lb./1,000 ft. <sup>2</sup>	Per Ac
March 1 to August 15	Oats Tall Fescue Annual Ryegrass	3 · 1 1	4 bushel 40 lb. 40 lb.
	Perennial Ryegrass Tall Fescue Annual Ryegrass	1 1 1	40 lb. 40 lb. 40 lb.
August 16 to November 1	Rye Tall Fescue Annual Ryegrass	3 1 1	2 bushel 40 lb. 40 lb.
	Wheat Tall Fescue Annual Ryegrass	3 1 1	2 bushel 40 lb. 40 lb.
	Perennial Ryegrass Tell Fescue Annual Ryegrass	1 1 1	40 lb. 40 lb. 40 lb.

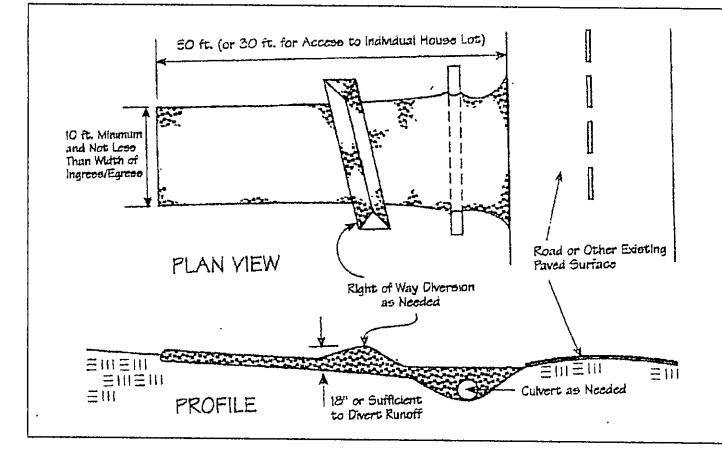

 CURVE TABLE

 CURVE
 LENGTH
 RADIUS
 TANGENT
 CHORD
 BEARING
 DELTA

 C1
 67.92
 60.00
 38.12
 64.35
 N10'37'48"E
 64'51'29"

6/28/05

B.P.

BM - SANITARY MANHOLE ELEV - 754.95

NOTE: ALL IRON PINS SET ARE 5/8" X 30" AND ARE CAPPED BABCOCK, JONES & ASSOC.

Stamwater Management Plan Approved as shown and/or noted JAMES R. GILLS, P.E. County Drainage Engineer, By d.S. : pate 7/27/05

EXISTING UTILITIES NOTE:
THE SIZE AND LOCATION, BOTH HORIZONTAL AND VERTICAL
OF THE UNDERGROUND UTILITIES SHOWN HEREON, HAVE BEEN
OBTAINED BY A SEARCH OF AVAILABLE RECORDS.
VERIFICATION BY FIELD OBSERVATION HAS BEEN CONDUCTED
WHERE PRACTICAL, HOWEVER, BABCOCK, JONES AND ASSOCIATES
INC. DOES NOT GUARANTEE THE COMPLETENESS NOR ACCURACY
THEREOF.



REV NO.	DESCRIPTION	DATE	BY	CHK'D
1	CHANGED HOUSE	7/11/05	B.P.	H.J.
				1
		<del></del>	<del></del>	<del>                                     </del>



BABCOCK, JONES AND ASSOCIATES, INC CIVIL ENGINEERS - SURVEYORS - LAND PLANNE

PAINESVILLE OHIO 44077

	11 10	DRAWN
ERS		APPROV
		CREW C

SITE PLAN FOR PRO BUILT

S/L 5 BROOKRIDGE LANE (BROOKFIELD III. SUB) CONCORD TOWNSHIP LAKE COUNTY STATE OF OHIO

1"=20' **ЈОВ NO** 05-097-5 SHEET