

Colcord Township, Lake County, Ohio

CLIENT CARRIER

[illegible]

LOT	PAGE
VOLUME	PAGE
SHEET	STREET
STREET NO.	STREET

CHARGE 1745 Sub
 DIVISION 13-7 NAME _____
45 NO. 10 100-10
 SUBLOT NO. 100-10 STREET _____

LOT	TRACT
VOLUME	PAGE
SEAL, PARCEL NO.	STREET

LEGEND

SANITARY MANHOLE	WATER VALVE (GAS)
STORM MANHOLE	WATER METER (GAS)
INLET OR CATCH BASIN	AS BUILT ELEVATION
HYDRANT	INDICATES DIRECTION OF SURFACE DRAINAGE
EXISTING CONTOURS	
PROMOTED CONTOURS	
EXIST. ELEV. 100.0	
PROP. ELEV. 100.0	

REMARKS

ALL BOUNDARY DATA SHOWN WAS OBTAINED FROM IDEBS, RECORDED SUBDIVISION PLAT OR OTHER PUBLIC RECORDS

DESIGN CERTIFICATION

THIS PLAY WAS PREPARED BY ME, AND IS CORRECT TO THE BEST OF MY KNOWLEDGE AND BELIEF.

NAME	SURVEYOR	REGISTRATION	NO.

CHECK LIST

[illegible]

PLAN PREPARED BY:

BABCOCK • JONES & ASSOCIATES, INC.

PAINESVILLE, OHIO

DESIGNED BY	SCALE	PHONE NO.
1/2"	1" = 20'	357-1811

CHK'D.	DATE	DRAINING NO.
	2/2/20	

CHIEF	174	8/23/70	89-194-65
CLERK	175	APRD. 177	

"AS BUILT" CERTIFICATION

I, HEREBY CERTIFY THAT THE CIRCLED GRADES ARE EXISTING
FINISH GRADES CHECKED IN THE FIELD ON _____, 19____
AND ARE CORRECT TO THE BEST OF MY KNOWLEDGE AND BELIEF.

REGISTERED SURVEYOR REG. NO.

T64-14M SAR MTH

755,05

#6592



ZONING PERMIT
ISSUED 9-5-90

SUBJECT TO APPROVAL BY:

Lake County Cemetery Eng. ☐Lake County Eng. Dept.

Lake County Planning Comm. ☐
Lake County Bldg. Dept. ☒

Devo J. Marlene

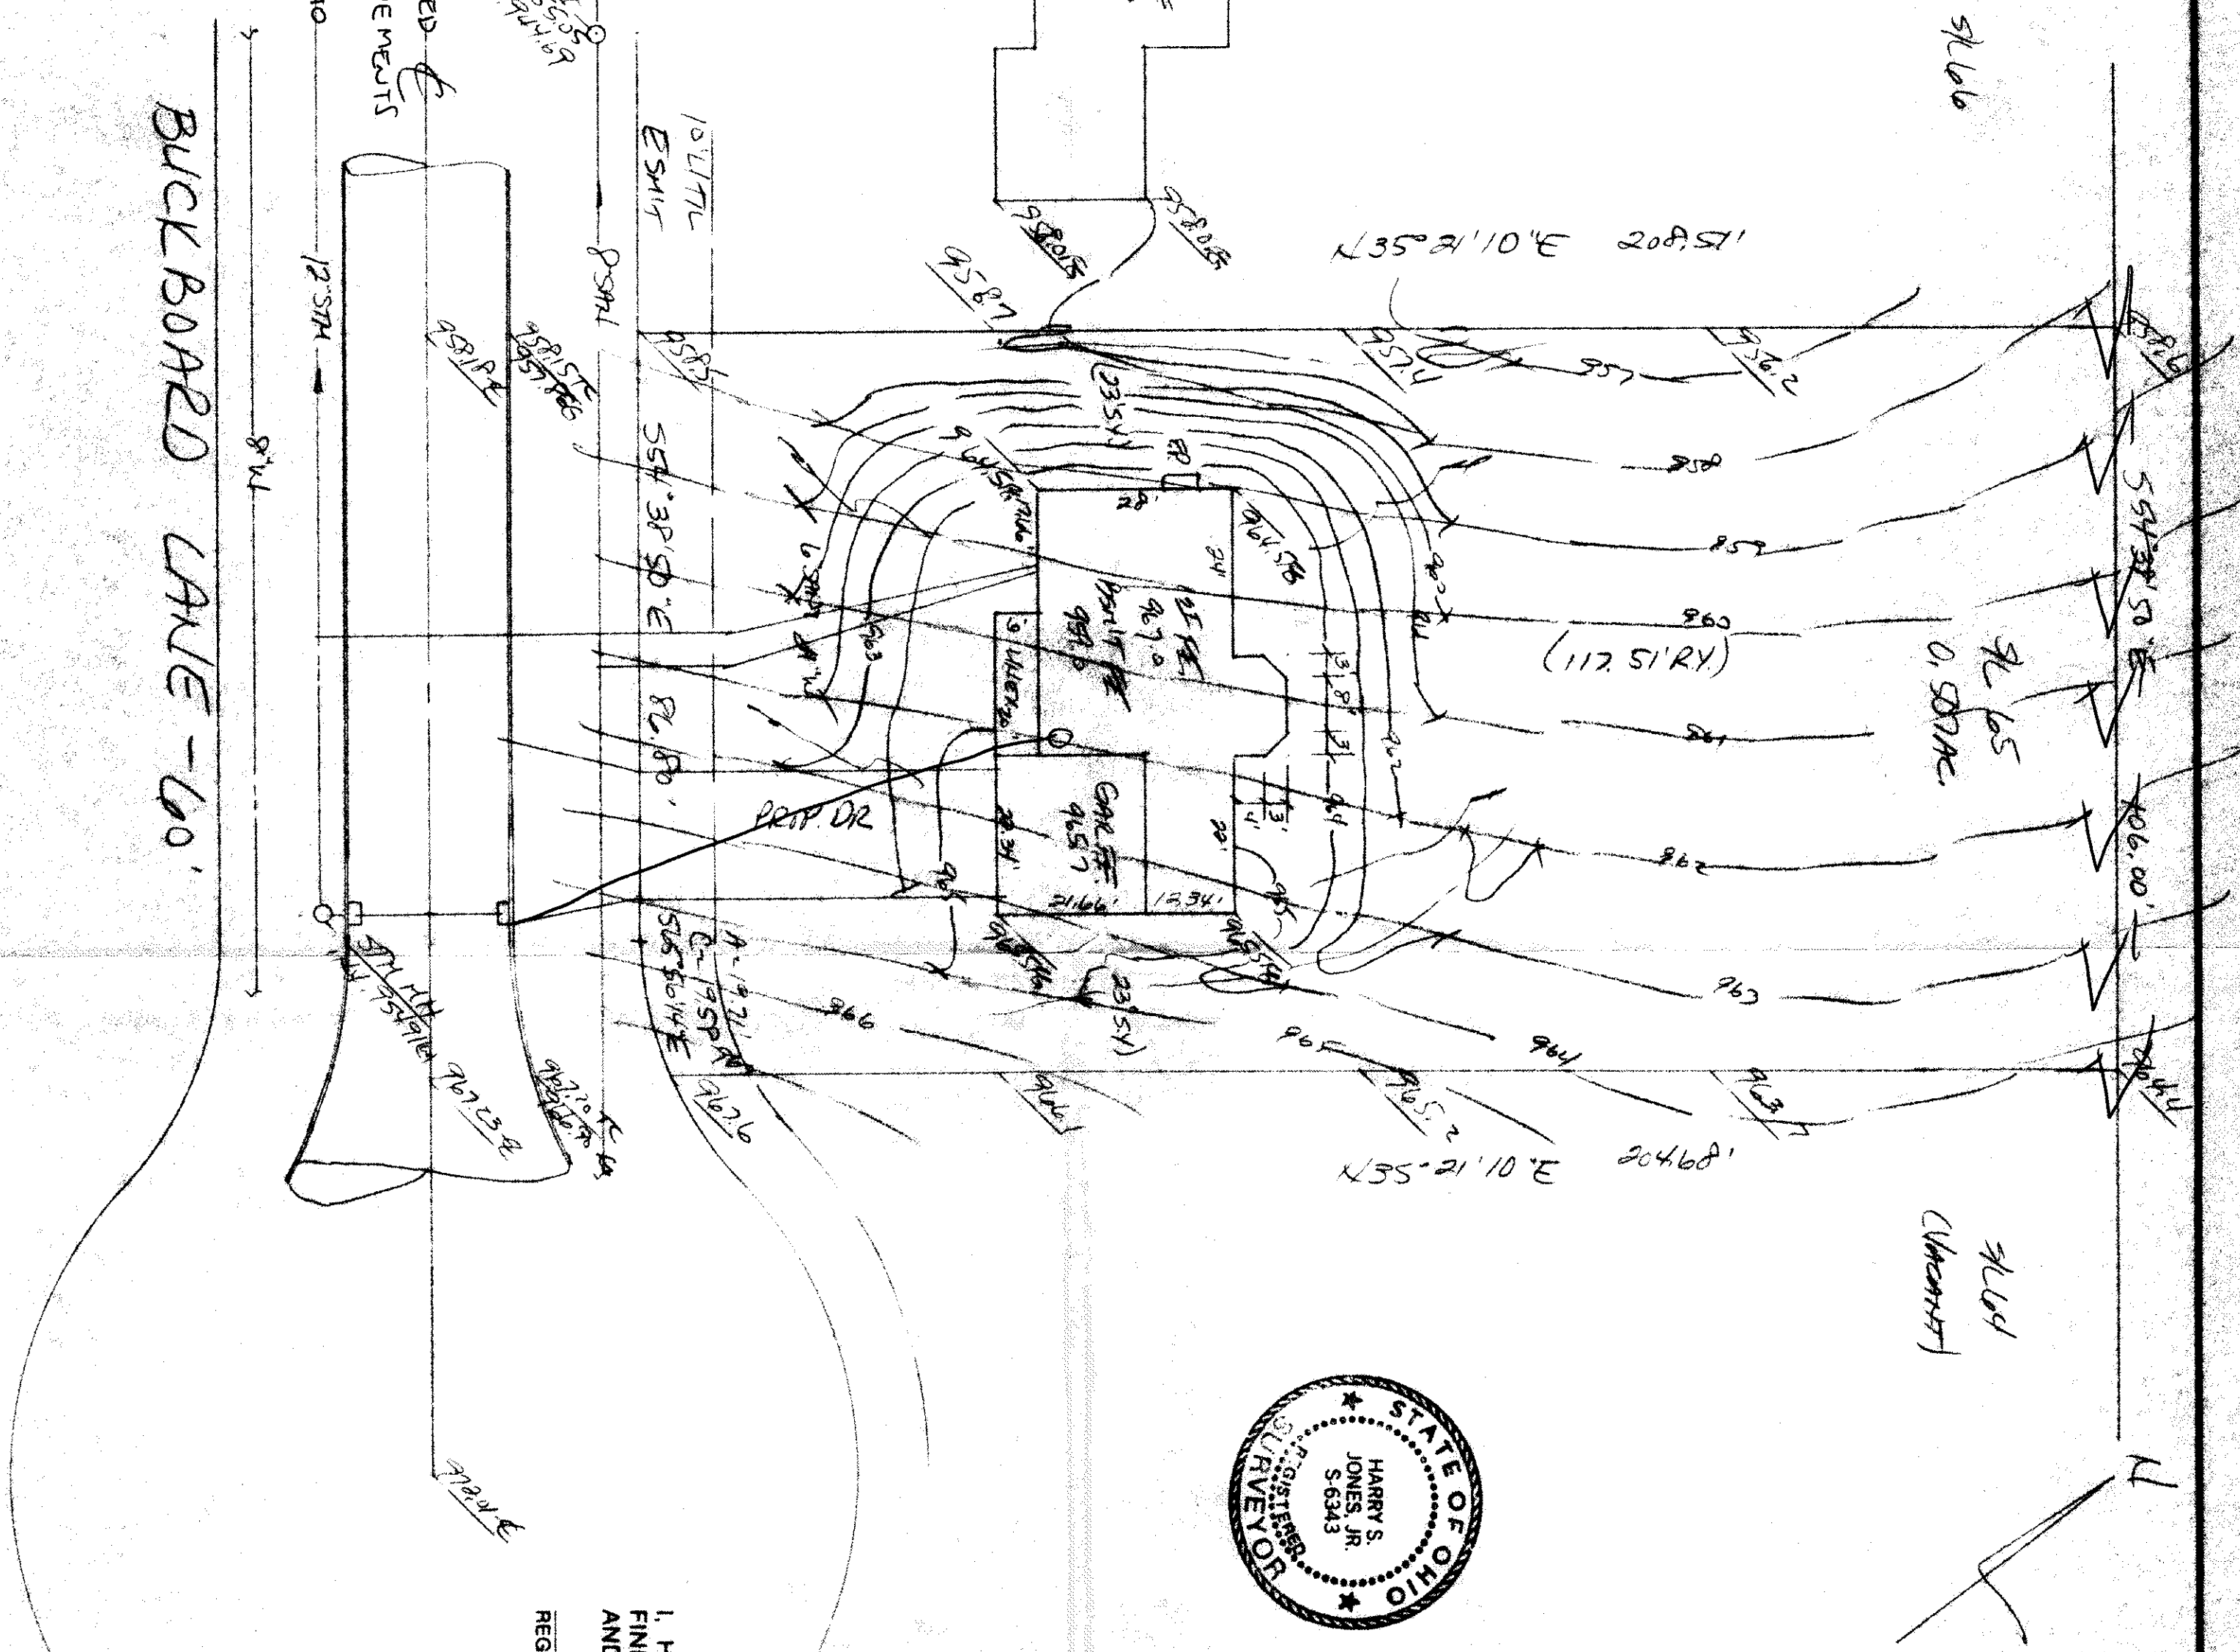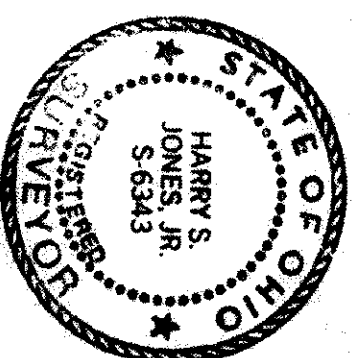

Grading Plan Approved
as shown and/or noted
THOMAS P. GILLES, P.E.
Lake County Engineer

By GTH Date 2/16/00

1. REAR SWALE TO BE COMPLETED &
AS PER SUBDIVISION IMPROVEMENTS

2. CONNECT SUMP PUMP TO
STORM SEWER

BUCK BOARD CABLE - 600