


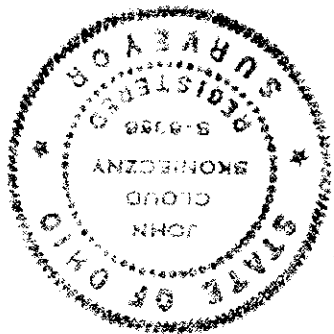

JOHN C. SKONECZNY
7739 VIEWMOUNT DR.
PAINESVILLE, OHIO 44077
PH 952-7742

John C. Skonieczny
REG. SURVEYOR #6356

I CERTIFY THAT THIS PLAN
WAS PREPARED BY ME AND
IS CORRECT TO THE BEST OF
MY KNOWLEDGE AND BELIEF

EXISTING
PROPOSED
SWALE

SITE PLAN FOR: MR & MRS. CARL WOLF	
SCALE: 1" = 20'	APPROVED BY
DATE: MAY 90	DRAWN BY F.J.H.
BEING SUBLOT 59 IN THE CARRIAGE HILLS SUBDIVISION CONCORD TOWNSHIP, LAKE COUNTY, STATE OF OHIO	
JOB # 90-1037	
DRAWING NUMBER 50-788	

Rev. 8. March

ISSUED 5-14-90
#6465

ZONING PERMIT

SUBJECT TO APPROVAL BY:

☐ Lake County Sanitary Eng.
☒ Lake County Eng. Dept.
☐ Lake County Planning Comm.
☒ Lake County Bldg. Dept.

BUCKBOARD LANE

60' SUBDIVISION IMPROVEMENT

By *G.H.*
THOMAS P. GILLES, P.E.
Lake County Engineer

Grading Plan Approved
as shown and/or noted

San. M.H.
Rim 954.50
Inv. 944.69

1. REAR SWALE TO BE
CONSTRUCTED AS PER
Date 5/14/90

