

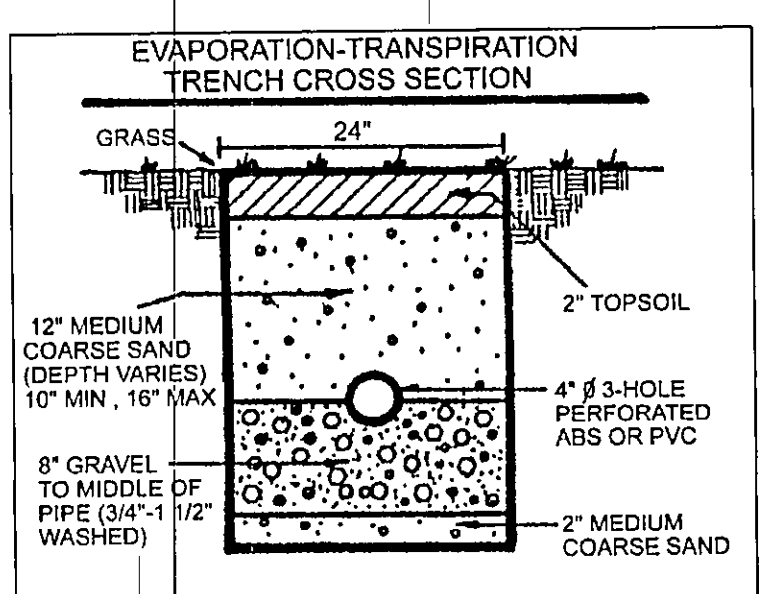
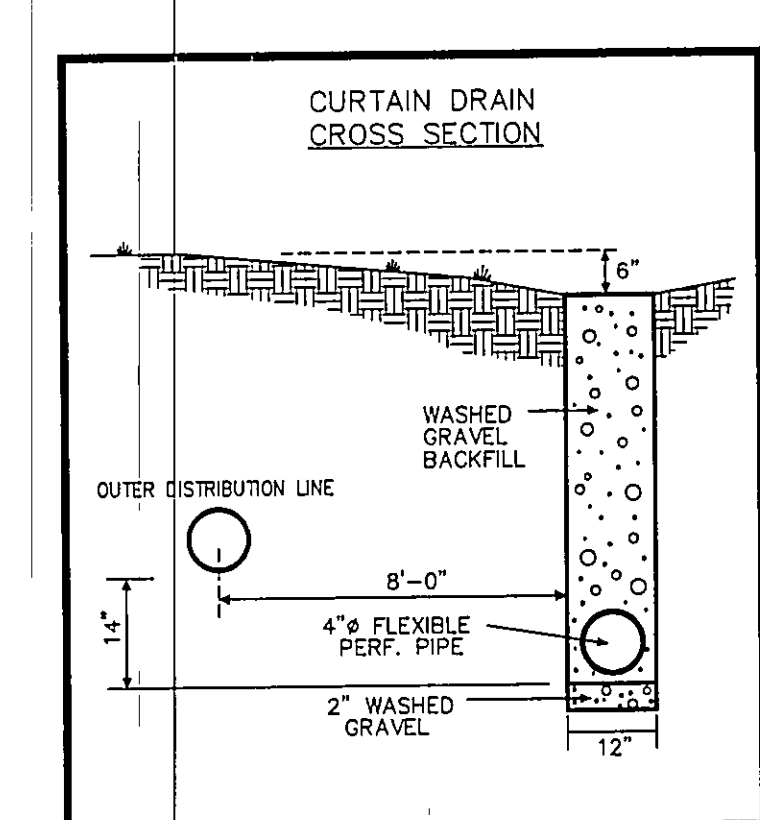


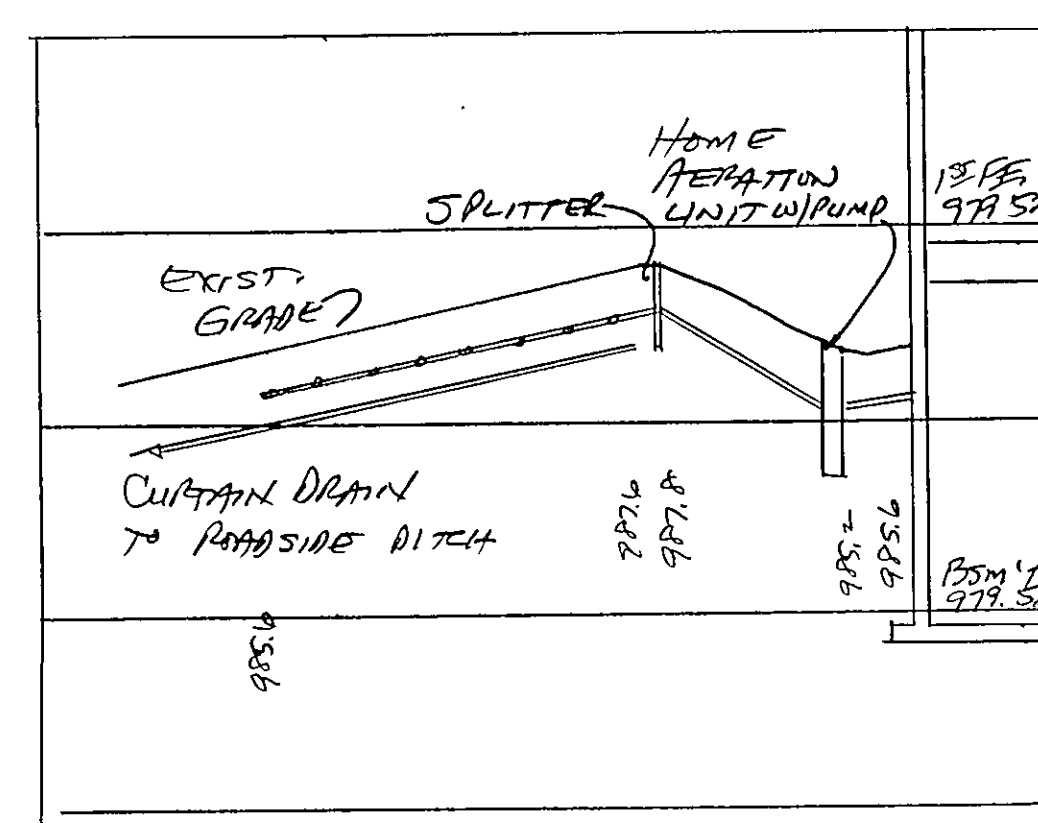

REVIEWED AND ACCEPTED
LAKE COUNTY GENERAL
HEALTH DISTRICT
DATE 10-14-02 BY NS
SEWAGE DISPOSAL PERMIT MUST BE
OBTAINED BY LAKE COUNTY ENGINEER
AND FILED WITH INSPECTION
STATION

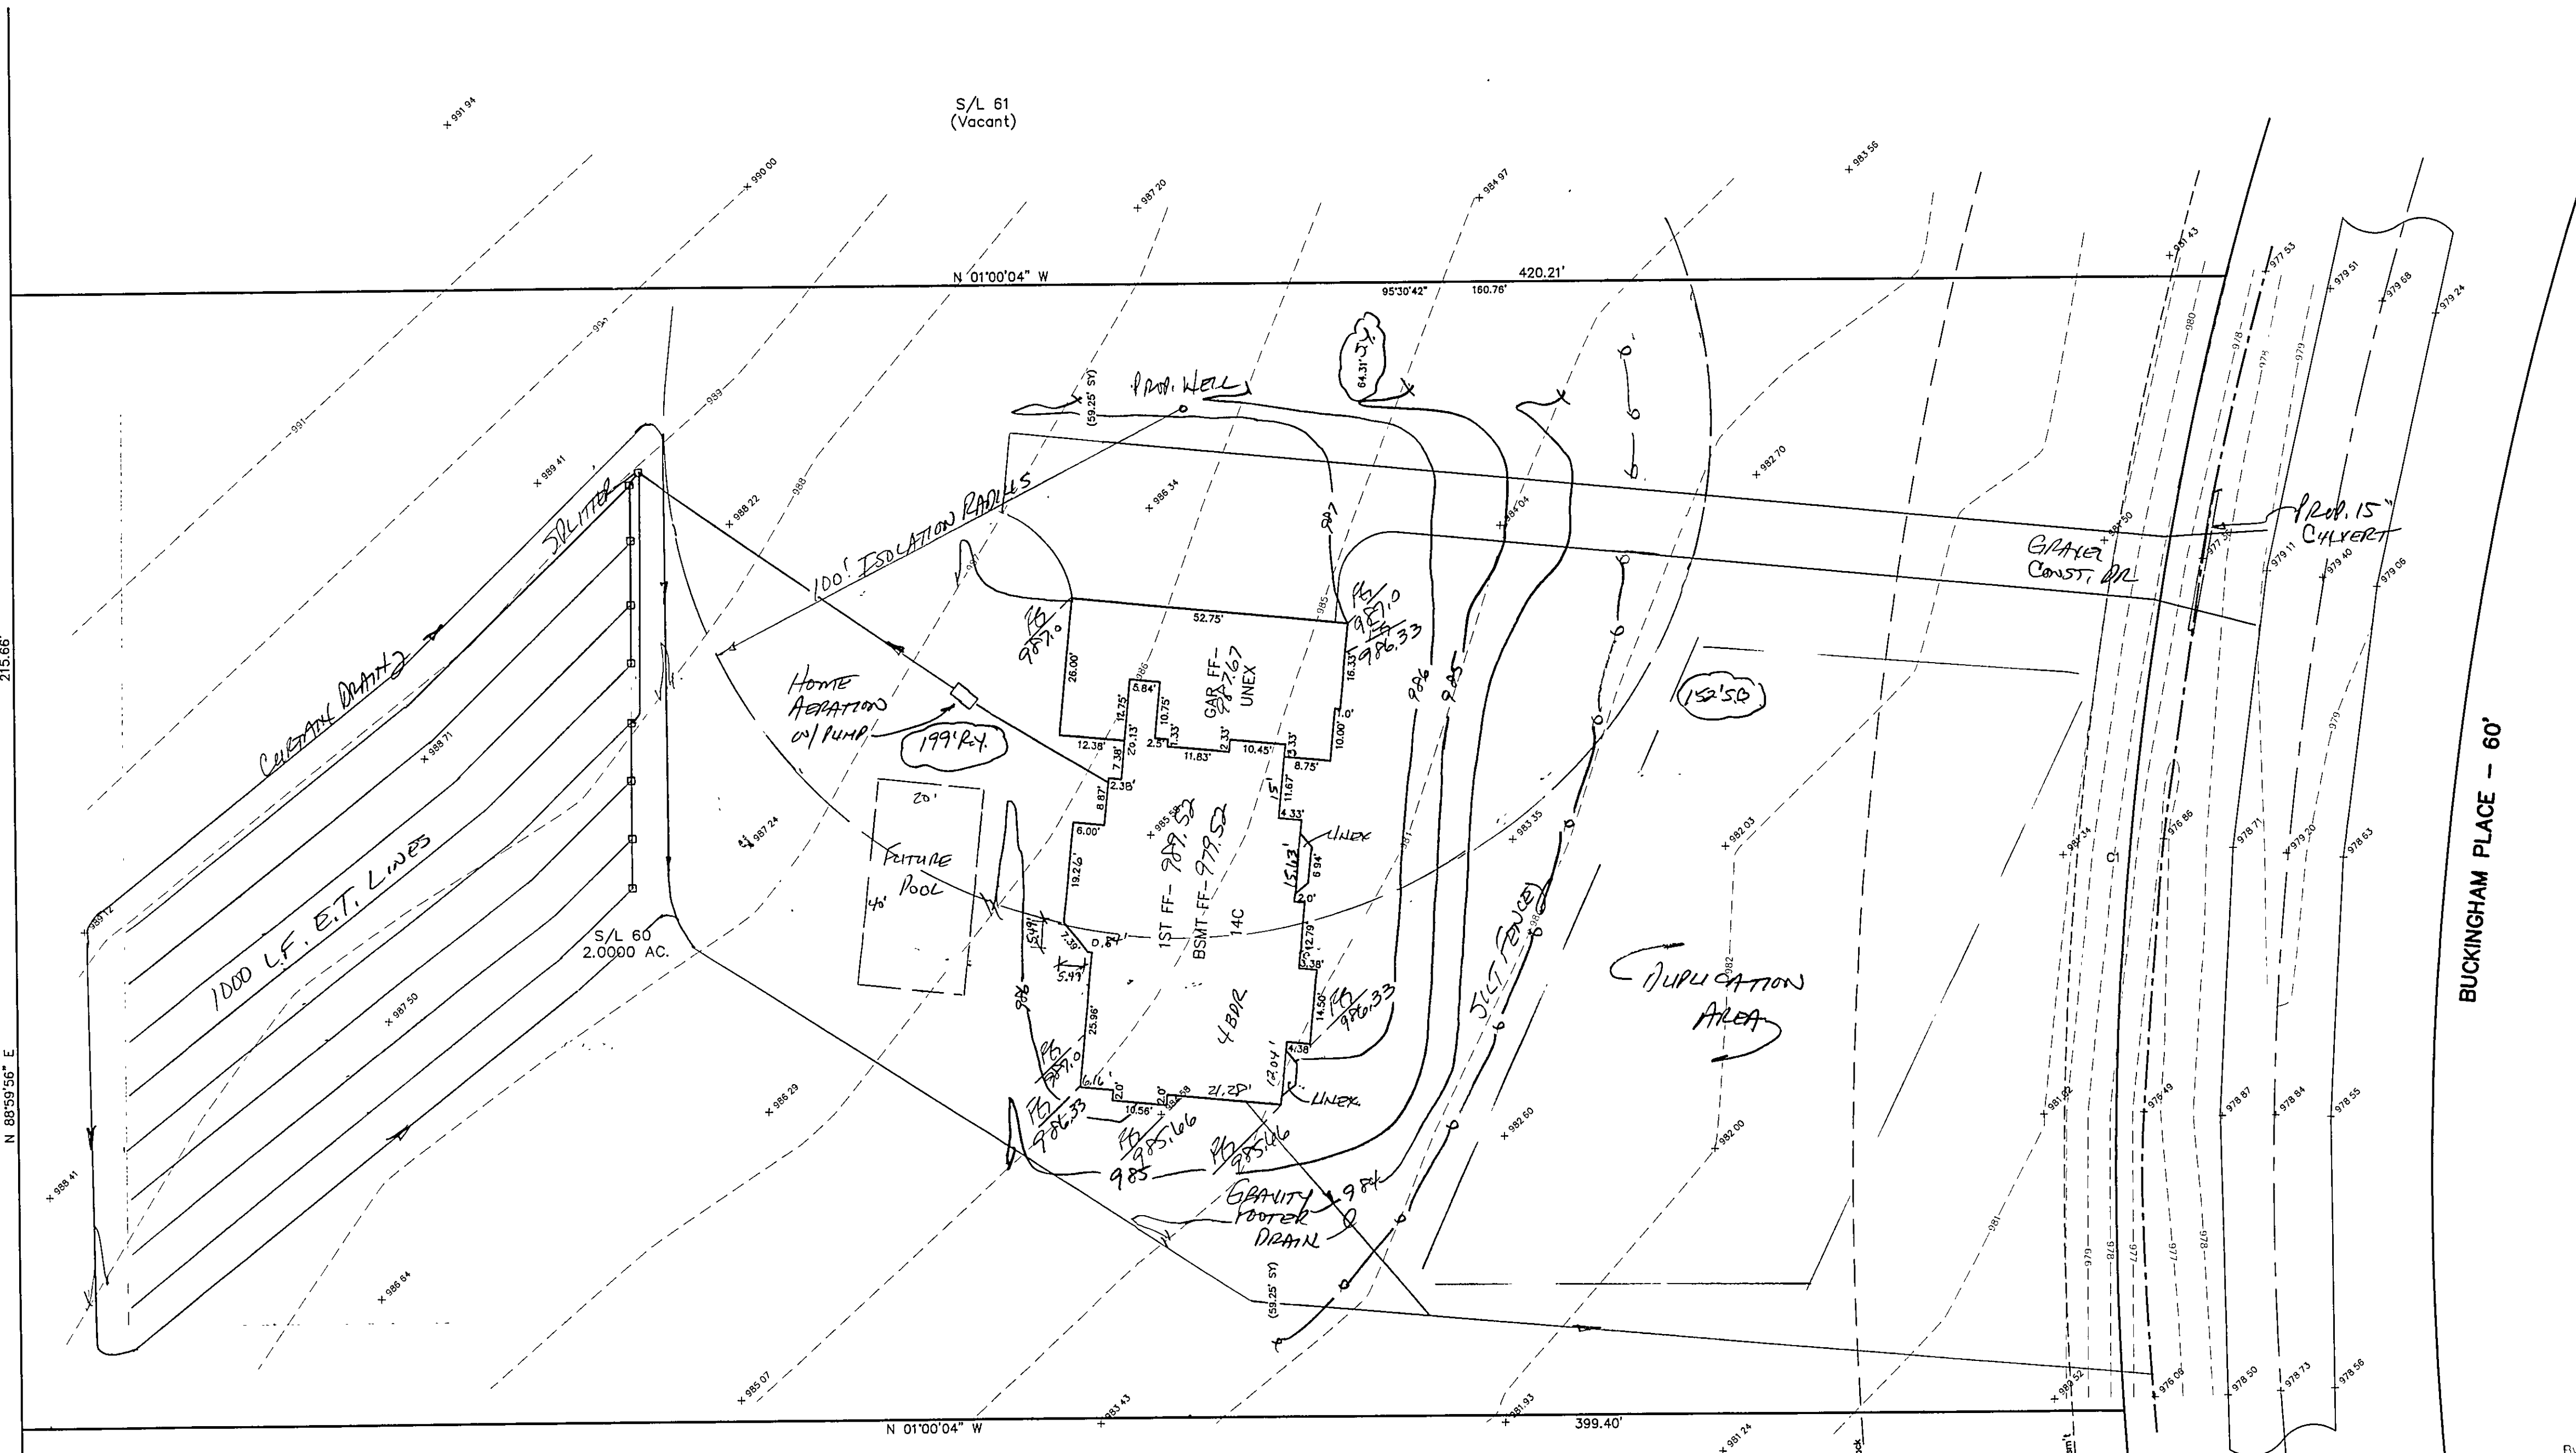

HYDRAULIC PROFILE
HORIZ: 1"=20' VERT: 1"=5'

"I, the undersigned hereby certify that this topography indicated by 6", 1", or 2" contours, and elevations shown hereon represent an actual field survey made by me on the 24th day of JUNE, 2000 and that the elevations were taken at appropriate intervals and that as of that date they existed as indicated hereon."


Harry S. Jones #6343
Name Reg. No.

NOTE: TEMPORARY SEEDING REQUIRED IN DISTURBED AREAS.

BM-NAIL IN TREE @ RAD. PT.
ELEV.=978.46

CONCORD TOWNSHIP ZONING OFFICE
ZONING PERMIT # 1002-10306
ISSUED 10-17-2002
SUBJECT TO APPROVAL BY:

- ☐ Lake Co. Planning Comm.
- ☐ Lake Co. Building Dept.
- ☐ Lake Co. Soil & Water Cons. Dist.

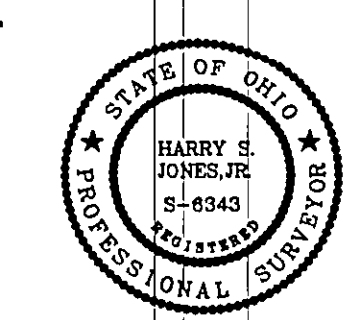

REV NO.	DESCRIPTION	DATE	BY	CHK'D
1	REVISED HOUSE #5497C	10-14-02	NS	LE



BABCOCK, JONES AND ASSOCIATES, INC
CIVIL ENGINEERS - SURVEYORS - LAND PLANNERS
PAINESVILLE OHIO 44077

DATE	6/29/00
DESIGN BY	H.J.
DRAWN BY	T.R.
APPROVED BY	H.J.

SITE PLAN
FOR
KERN BUILDING
CONCORD TOWNSHIP
LAKE COUNTY

SCALE:	1"=20'
JOB NO.	00-092-60
SHEET	1
OF	1