

Abbreviated Site Plan - Erosion and Sediment Control Notes (Individual Homesites) (5-13-05)

Ingress-Egress

A stone access drive complete with under lying geo-textile fabric (20 feet wide and 50 feet long) for ingress and egress at the site shall be installed. This drive shall be the only entrance and exit to the site.

Silt Fence

All silt fence shall be installed prior to any earthwork activities at the site in the locations shown on the site plan as well as along the front of any lot that slopes towards the street.

Temporary Seeding

Disturbed areas of the site that are to remain idle for more than Twenty-one (21) days shall be properly seeded and straw mulched within seven (7) days of completion of initial grading. Temporary seeding and mulching of a thirty (30) foot strip of the entire front of the lot shall be maintained on the site once initial grading is complete.

Stabilization of critical areas within fifty (50) feet of any stream or wetland shall be complete within two (2) days of the disturbance if the site is to remain inactive for longer than fourteen (14) days.

Mulching

Straw-mulch shall be applied at a rate of 1 bale per every ten (10) feet of curb, at a width of thirty (30) feet of the entire length of the lot. Wood chips may also be used but must be spread at a minimum depth of four inches over the thirty-foot width and must be accompanied by a properly installed silt fence.

Maintenance


Erosion and sediment controls shall be inspected every seven (7) days or within 24 hours of a 0.5" or greater rainfall event. Necessary repairs shall be made at this time.

Note:

All erosion and sediment control specifications, applications, and timetables are based of the descriptions and standards of The Ohio Department of Natural Resources "Rainwater and Land Development Manual" and can be found in the Lake County Erosion and Sediment Control Rules as adopted December 21, 1999.

The specified erosion and sediment control standards are general guidelines and shall not limit the right of the county to impose, at any time, additional, more stringent requirements. Nor shall the standards limit the right of the county to

Specifications for Construction Entrance

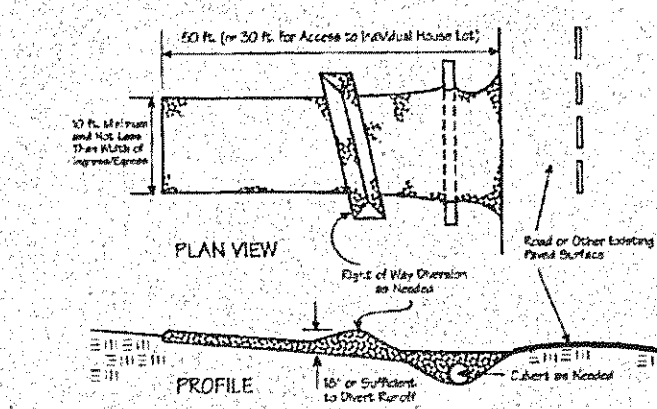

1. Stone Size-Two-inch stone shall be used, or recycled concrete equivalent.
2. Length-The construction entrance shall be as long as required to stabilize high traffic areas but not less than 50 ft. (except on single-lane roads for where a 30 ft. minimum length applies).
3. Thickness-The stone layer shall be at least 6 in. thick.
4. Width-The entrance shall be at least 10 ft. wide, but not less than the full width at points where ingress or egress occurs.
5. Bedding-A geotextile shall be placed over the entire area prior to placing stone. It shall have a Grab Tensile Strength of at least 200 lb. and a Modulus Tensile Strength of at least 180 lb.
6. Culvert-A pipe or culvert shall be constructed under the entrance if needed to prevent surface water flowing across the entrance from being directed out onto paved surfaces.
7. Water Bar-A water bar shall be constructed as part of the construction entrance if needed to prevent surface runoff from flowing the length of the construction entrance and onto paved surfaces.
8. Maintenance-Top dressing of additional stone shall be applied as conditions demand. Must be applied, dropped, washed or tracked onto public roads, or any surface where runoff is not checked by sediment controls, shall be removed immediately. Removal shall be accomplished by scraping or sweeping.
9. Construction entrance shall not be relied upon to remove mud from vehicles and prevent off-site tracking. Vehicles that enter and leave the construction site shall be restricted from muddy areas.

CONSTRUCTION ENTRANCE - PG 158


Specifications for Temporary Seeding

Seeding Dates	Species	Lb./1,000 ft. ²	Per Ac.
March 1 to August 15	Oats	1	40 lb.
	Red Fescue	1	40 lb.
	Annual Ryegrass	1	40 lb.
August 16 to November 1	Red Fescue	2	80 lb.
	Annual Ryegrass	2	80 lb.
	Winter Rye	2	80 lb.
	Red Fescue	1	40 lb.
	Annual Ryegrass	1	40 lb.
November 1 to Spring Seeding	Use mulch only, seeding practices or dormant seeding.		

1. Erosion control and sediment control practices such as diversions and sediment traps shall be installed and silt fence with temporary seeding prior to grading the rest of the construction site.
2. Temporary seed shall be applied between construction operations on soil that will not be graded or reworked for 45 days or more. These life areas should be seeded as soon as possible after grading or shall be seeded within 7 days. Several applications of temporary seeding are necessary on typical construction projects.
3. The seedbed should be protected and kept to ensure the success of establishing vegetation. However, temporary seeding shall not be postponed if ideal seeded preparation is not possible.
4. Soil Amendment-Applications of temporary vegetation shall establish a dense stand of vegetation which may require the use of soil amendments. Soil tests should be taken on the site to predict the need for lime and fertilizer.
5. Seeding Method-Seed shall be applied uniformly with a cyclone seeder, roller, or hydroseeder. When feasible, seed that has been broadcasted shall be covered by rolling or dragging and then lightly tamped into place using a roller or compactor. If hydroseeding is used, the seed and fertilizer will be mixed on site and the seeding shall be done immediately and without interruption.


TEMPORARY SEEDING - PAGE 174

Specifications for Silt Fence

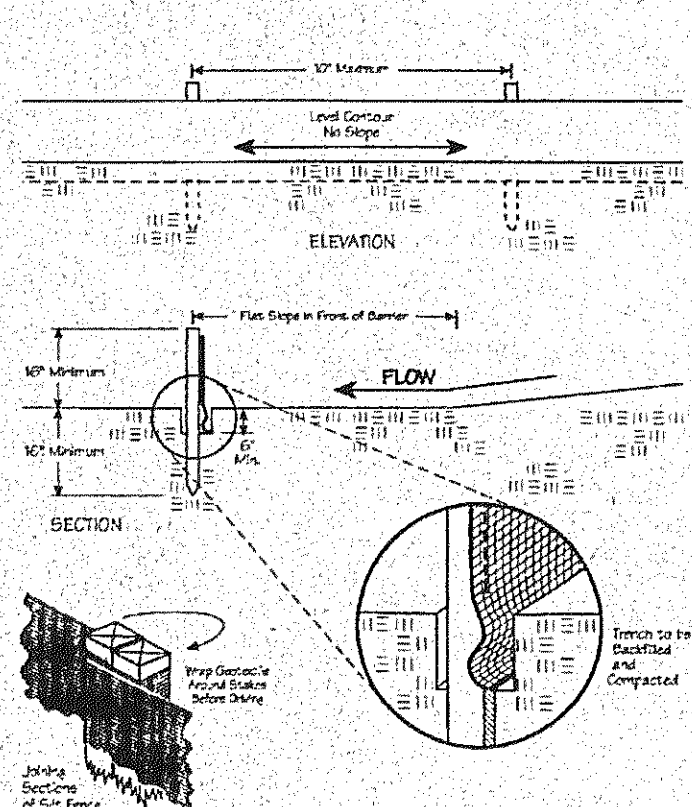

SILT FENCE - PAGE 130

GRAPHIC SCALE

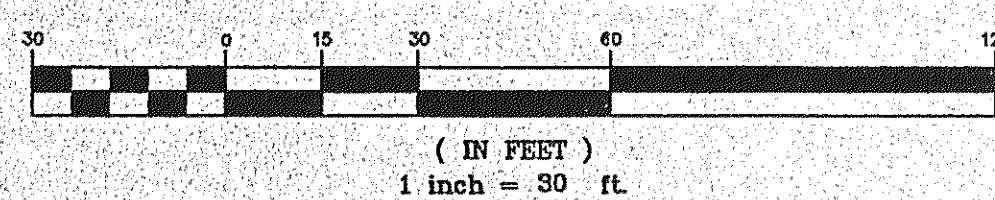


Buckingham Place 60'

CONCORD TOWNSHIP ZONING OFFICE
Zoning Permit # 205-1283
Date Issued 7/3/05

- Subject to Approval By:
- ☐ Lake Co. Engineer/Storm Water Mgmt.
 - ☐ Lake Co. Utilities Dept.
 - ☐ Lake Co. Soil & Water District
 - ☐ Lake Co. Health District
 - ☐ Lake Co. Building Dept.

2 WORKING DAYS
BEFORE YOU DIG
CALL TOLL FREE 800-362-2764
OHIO UTILITIES PROTECTION SERVICE

EXISTING UNDERGROUND UTILITIES NOTE:
THE SIZE & LOCATION, BOTH HORIZONTAL AND VERTICAL, OF THE UNDERGROUND UTILITIES SHOWN HEREON, HAVE BEEN OBTAINED BY A SEARCH OF AVAILABLE RECORDS. VERIFICATION BY FIELD OBSERVATION HAS BEEN CONDUCTED WHERE PRACTICAL. HOWEVER, LEO INC. DOES NOT GUARANTEE THE COMPLETENESS NOR ACCURACY THEREOF.

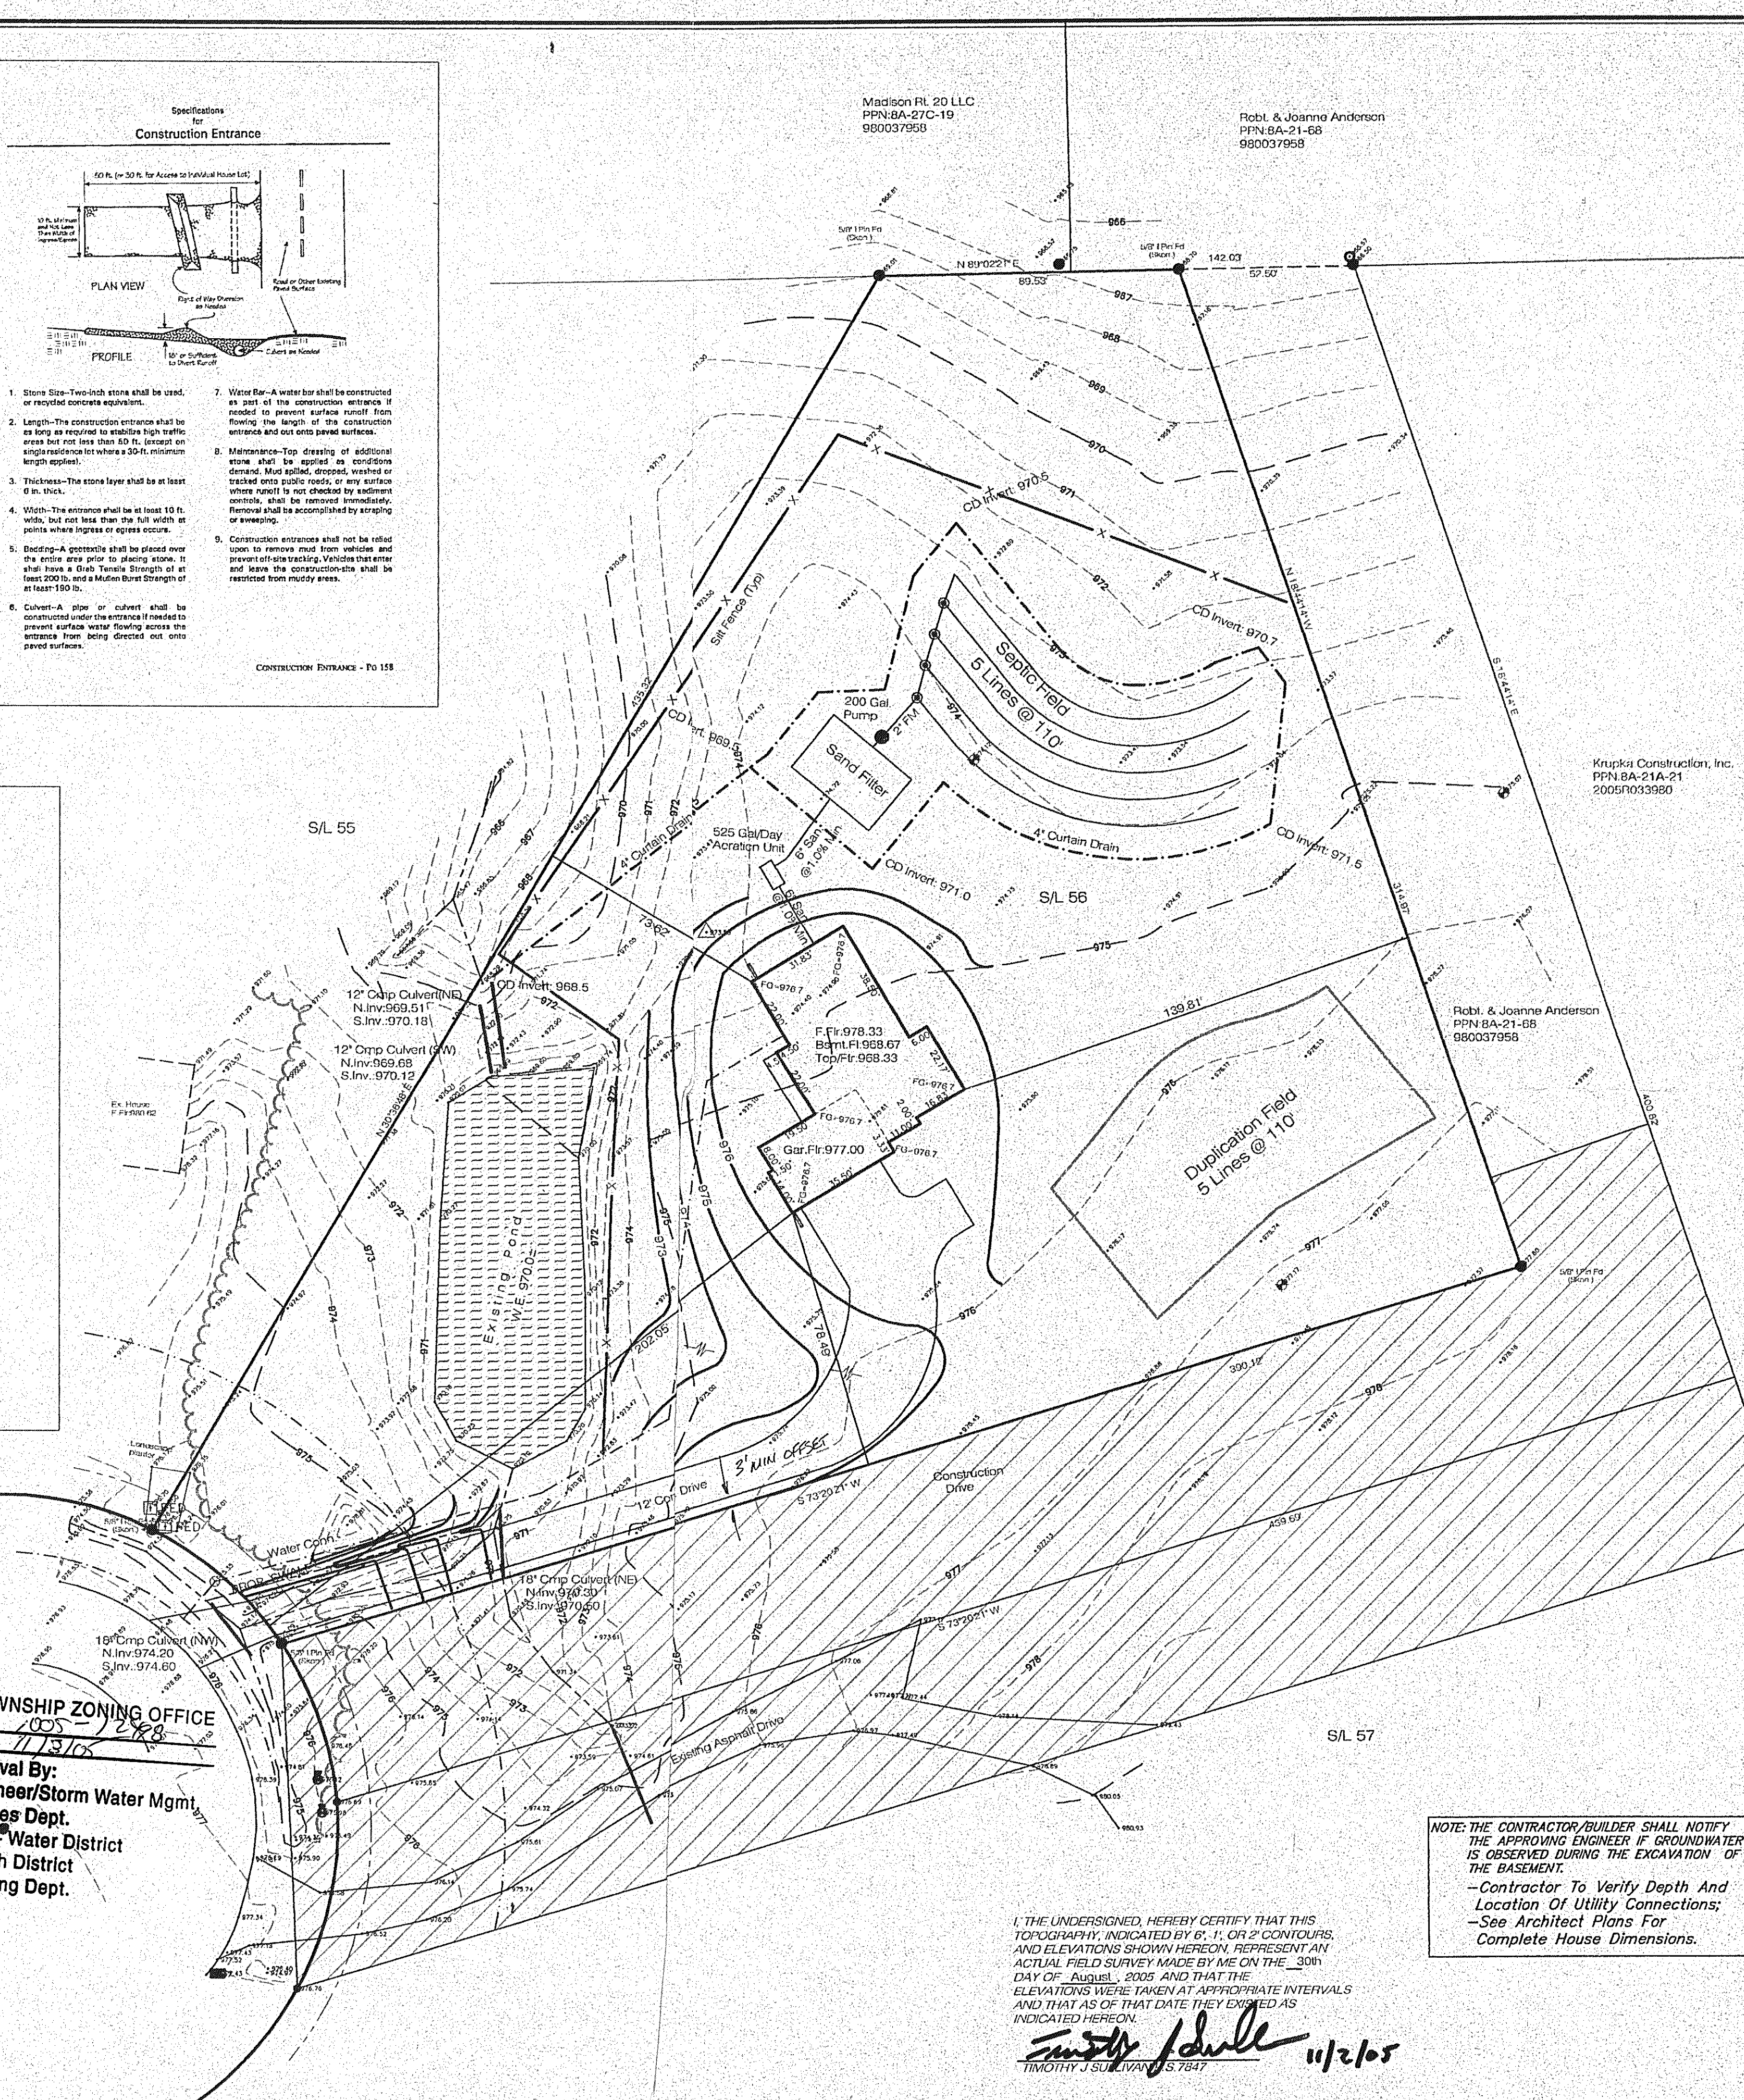

SITE PLAN

For: Vintago Homes
7395 Ravenna Road, Concord, OH 44022
SUBLOT No. 56, Mount Royal Blvd #3, Concord, OH 44022
LOT 12/13, TRACT 4, CITY/TOWNSHIP CONCORD TWP., OHIO

Prepared by
LAND DESIGN consultants
Civil Engineers and Surveyors
695 EAST ARLING - MIDDLETOWN, OHIO 44660
TELEPHONE: 256-0463 FAX 256-0460


DESIGN CERTIFICATION

THIS PLAN WAS PREPARED BY ME, AND IS CORRECT TO THE BEST OF MY KNOWLEDGE AND BELIEF.

Timothy J. Sullivan 11/2/05
NAME

CHECK LIST

LOT DIMENSIONS & BEARINGS
TIE TO NEAREST STREET
SUBLOT NO. (PARCELS, E.A.)
SURROUNDING OWNERS
BUILDING FOOTPRINTS
SETBACK, SIDEYARD, REARYARD
FINISHED GRADES
DRIVE & APRON TYPE, WIDTH, THICKNESS
SIDEWALK TYPE, WIDTH, THICKNESS
CURB TYPE, DIA., LENGTH
WATER MAIN SIZE, LOCATION
SAN. SEWER SIZE, % GRADE, LOC.
SAN. MAN. CAST. ELEV., INV. ELEV.
SAN. CONVE. SIZE, % GRADE, LOC.
STORM SEWER SIZE, % GRADE, LOC.
STORM MAN. CAST. ELEV., INV. ELEV.
PAV'T. TYPE, GRADE, CURBS
GAS LINE LOC., SIZE
SEPTIC SYSTEM & DUCTILATION
WELL LOCATION & ISOLATION RADII

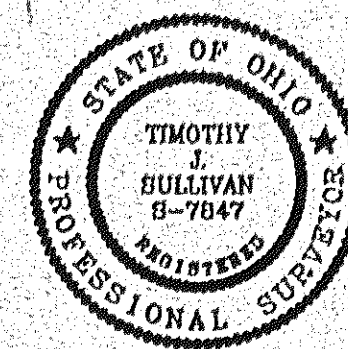

"AS BUILT" CERTIFICATION

I HEREBY CERTIFY THAT THE CIRCLED INFORMATION IS EXISTING AS OBTAINED ON THE SITE, AND IS CORRECT TO THE BEST OF MY KNOWLEDGE AND BELIEF.

NAME


LEGEND

STORM MANHOLE
SANITARY MANHOLE
EXISTING CONTOURS
PROPOSED CONTOURS
EXIST. ELEV. 100.0
F.G. 100.0 = PROP. ELEV.

DRAWN BY	JRP	SCALE	1"=30'
CHKD BY/FIELD		DATE	Sept/05
1	Site/Grade 10/17/05		
2	NEW DRIVE 11-02-05		

BENCHMARK:

TBM: Top/Hyd as shown

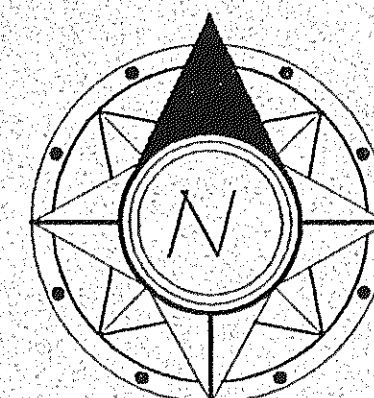

NOTE: THE CONTRACTOR/BUILDER SHALL NOTIFY THE APPROVING ENGINEER IF GROUNDWATER IS OBSERVED DURING THE EXCAVATION OF THE BASEMENT.
-Contractor To Verify Depth And Location Of Utility Connections;
-See Architect Plans For Complete House Dimensions.

I, THE UNDERSIGNED, HEREBY CERTIFY THAT THIS TOPOGRAPHY, INDICATED BY 6", 1", OR 2" CONTOURS, AND ELEVATIONS SHOWN HEREON, REPRESENT AN ACTUAL FIELD SURVEY MADE BY ME ON THE 30th DAY OF August, 2005 AND THAT THE ELEVATIONS WERE TAKEN AT APPROPRIATE INTERVALS AND THAT AS OF THAT DATE THEY EXISTED AS INDICATED HEREON.

Timothy J. Sullivan 11/2/05
TIMOTHY J. SULLIVAN 67847

Sheet 1 of 2
DWG. NAME
VINTH1-0512

Stormwater Management Plan
Approved as shown, or noted
JAMES R. GILLIS, PE
County Drainage Engineer
By: *[Signature]* Date: 11/2/05