


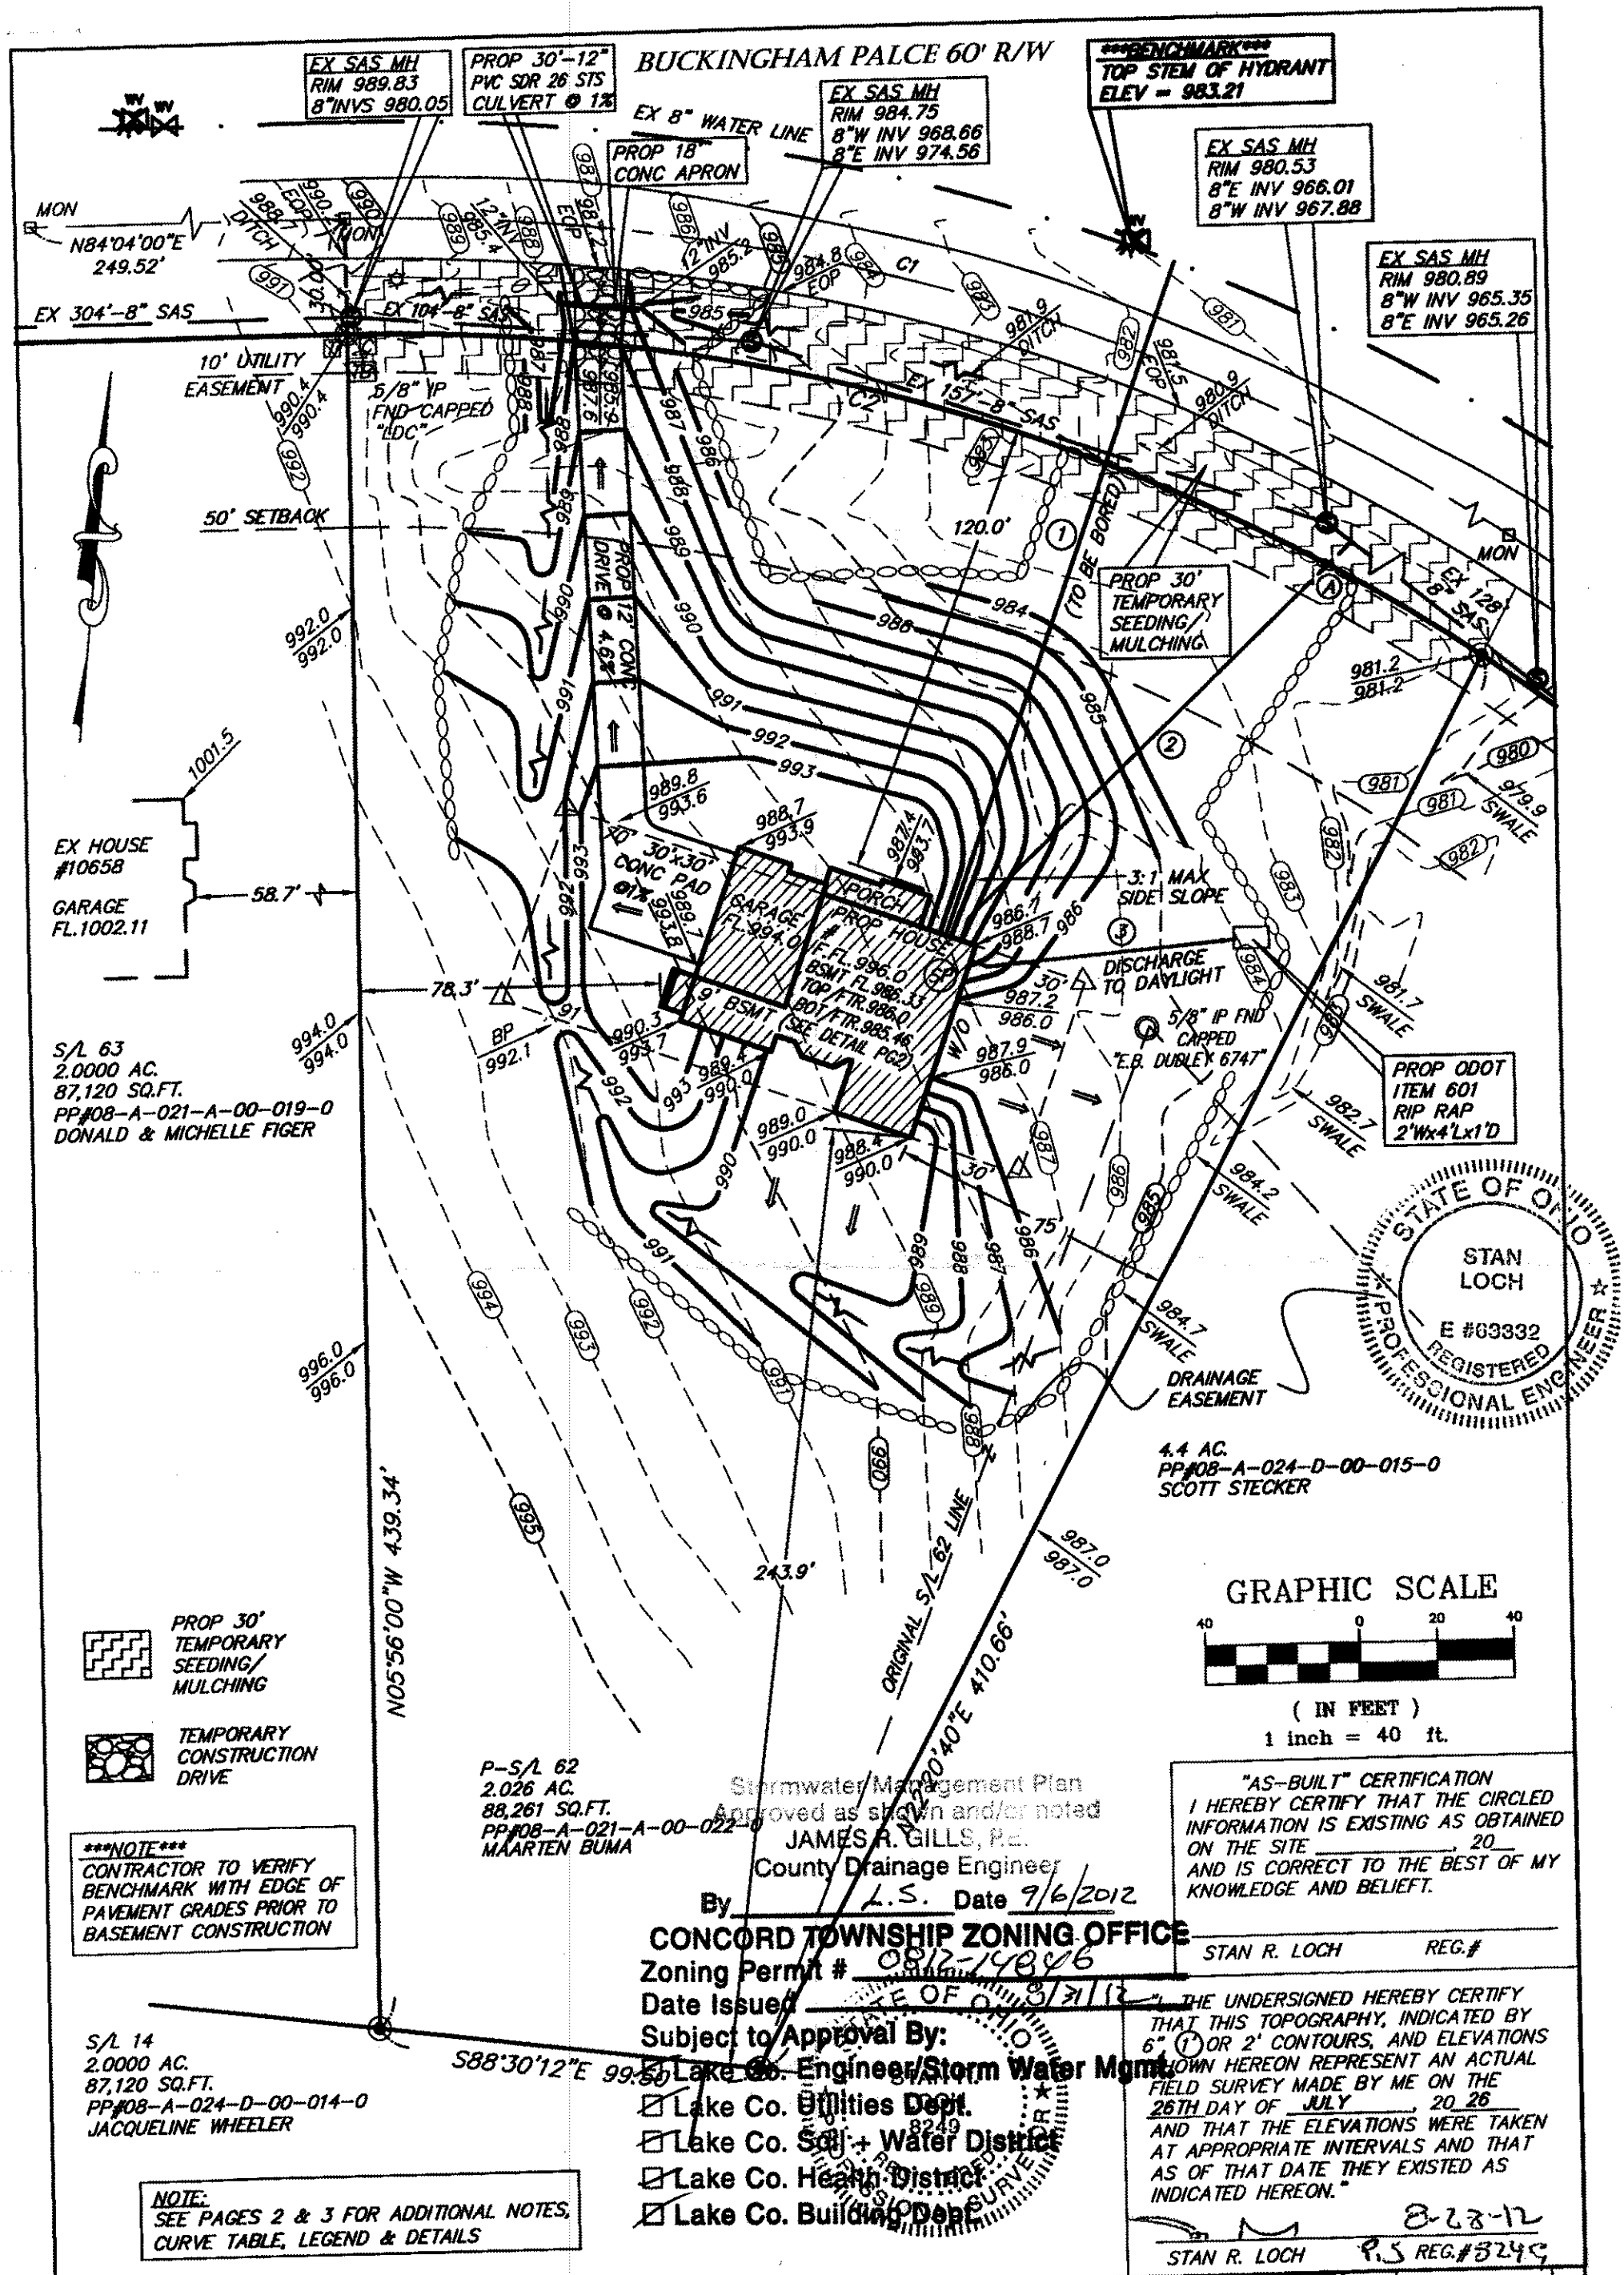

HORIZ. SCALE: 1"=40'		VERT. SCALE:		5425 WARNER ROAD - SUITE 12 VALLEY VIEW, OHIO 44125 440-602-9071 FAX 216-369-0250		SITE PLAN FOR B.R. KNEZ CONSTRUCTION, INC. BUCKINGHAM PLACE S/L 62 IN THE MOUNT ROYAL NO. 3 SUBDIVISION PLAT VOLUME 31, PAGE 9 CONCORD TOWNSHIP LAKE COUNTY, OHIO			
DRAWN BY: CL	DATE: 8/9/12	 ENGINEERING + SURVEYING Civil Engineering + Land Surveying							
CHECKED BY: SRL	DRAWING NO.: 99689								
JOB NO.: 99689	SHEET: 1 OF 3								

2	8/12	ADDED W/O BSMT	CL
1	8/12	REV BORDER	CL
NO.	DATE	DESCRIPTION	BY