
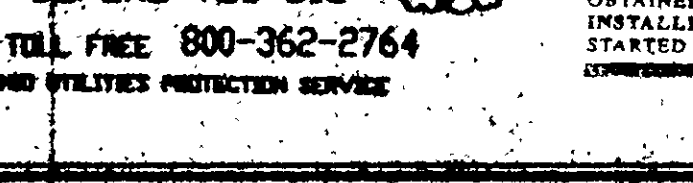



ALL INFORMATION STATED HEREIN HAS BEEN
OBTAINED FROM A SOURCE OF AVAILABLE RECORDS.
WHILE OBSERVATION HAS BEEN CONDUCTED
BY SPECIAL AGENT IN CHARGE, MR. MCC. DOES NOT
WARRANT THE COMPLETENESS AND ACCURACY THEREOF.

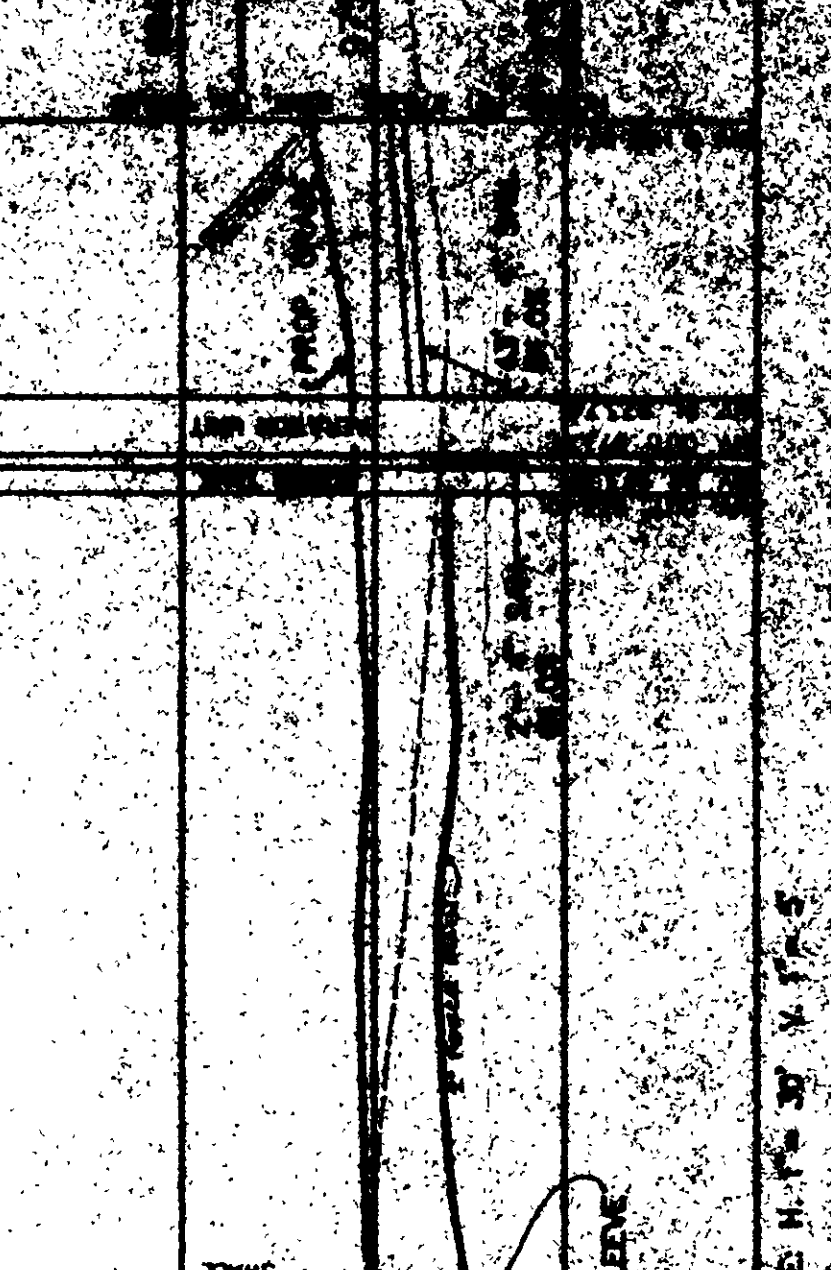

177

[illegible]

[Handwritten signature]

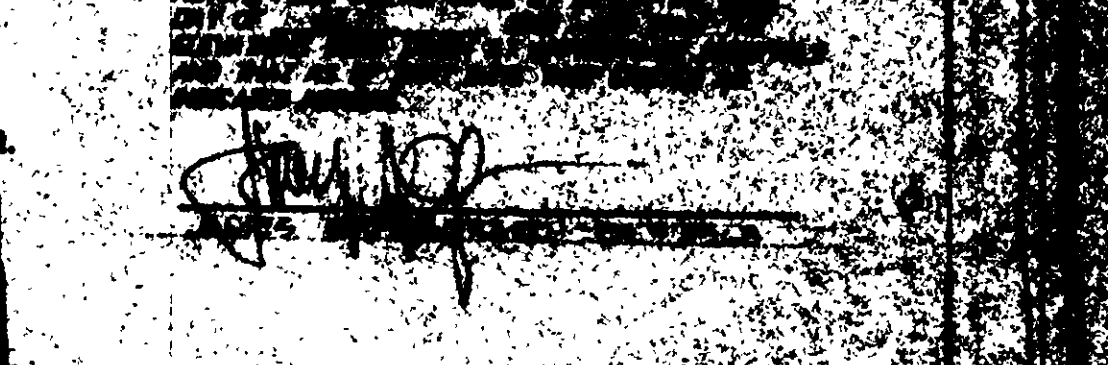[illegible]

Grading Plan Approved
as shown and/or noted
JAMES R. GILLS, P.E.
Lake County Engineer

By JRM Date 8/29/91

**ROOF DRAINS
SHALL DISCHARGE
TO SPLASH BLOCKS.**

CONCORD TOWNSHIP ZONING OFFICE
 ZONING PERMIT # 0801-1633
 ISSUED 8-20-01
 SUBJECT TO APPROVAL BY:
☒ Town Co. Sanitary Engineer
☒ Lake Co. Eng. Dept.
☐ Lake Co. Planning Comm.
☐ Lake Co. Building Dept.
☐ Lake Co. Soil & Water Cons. Dist.
 (3000)