
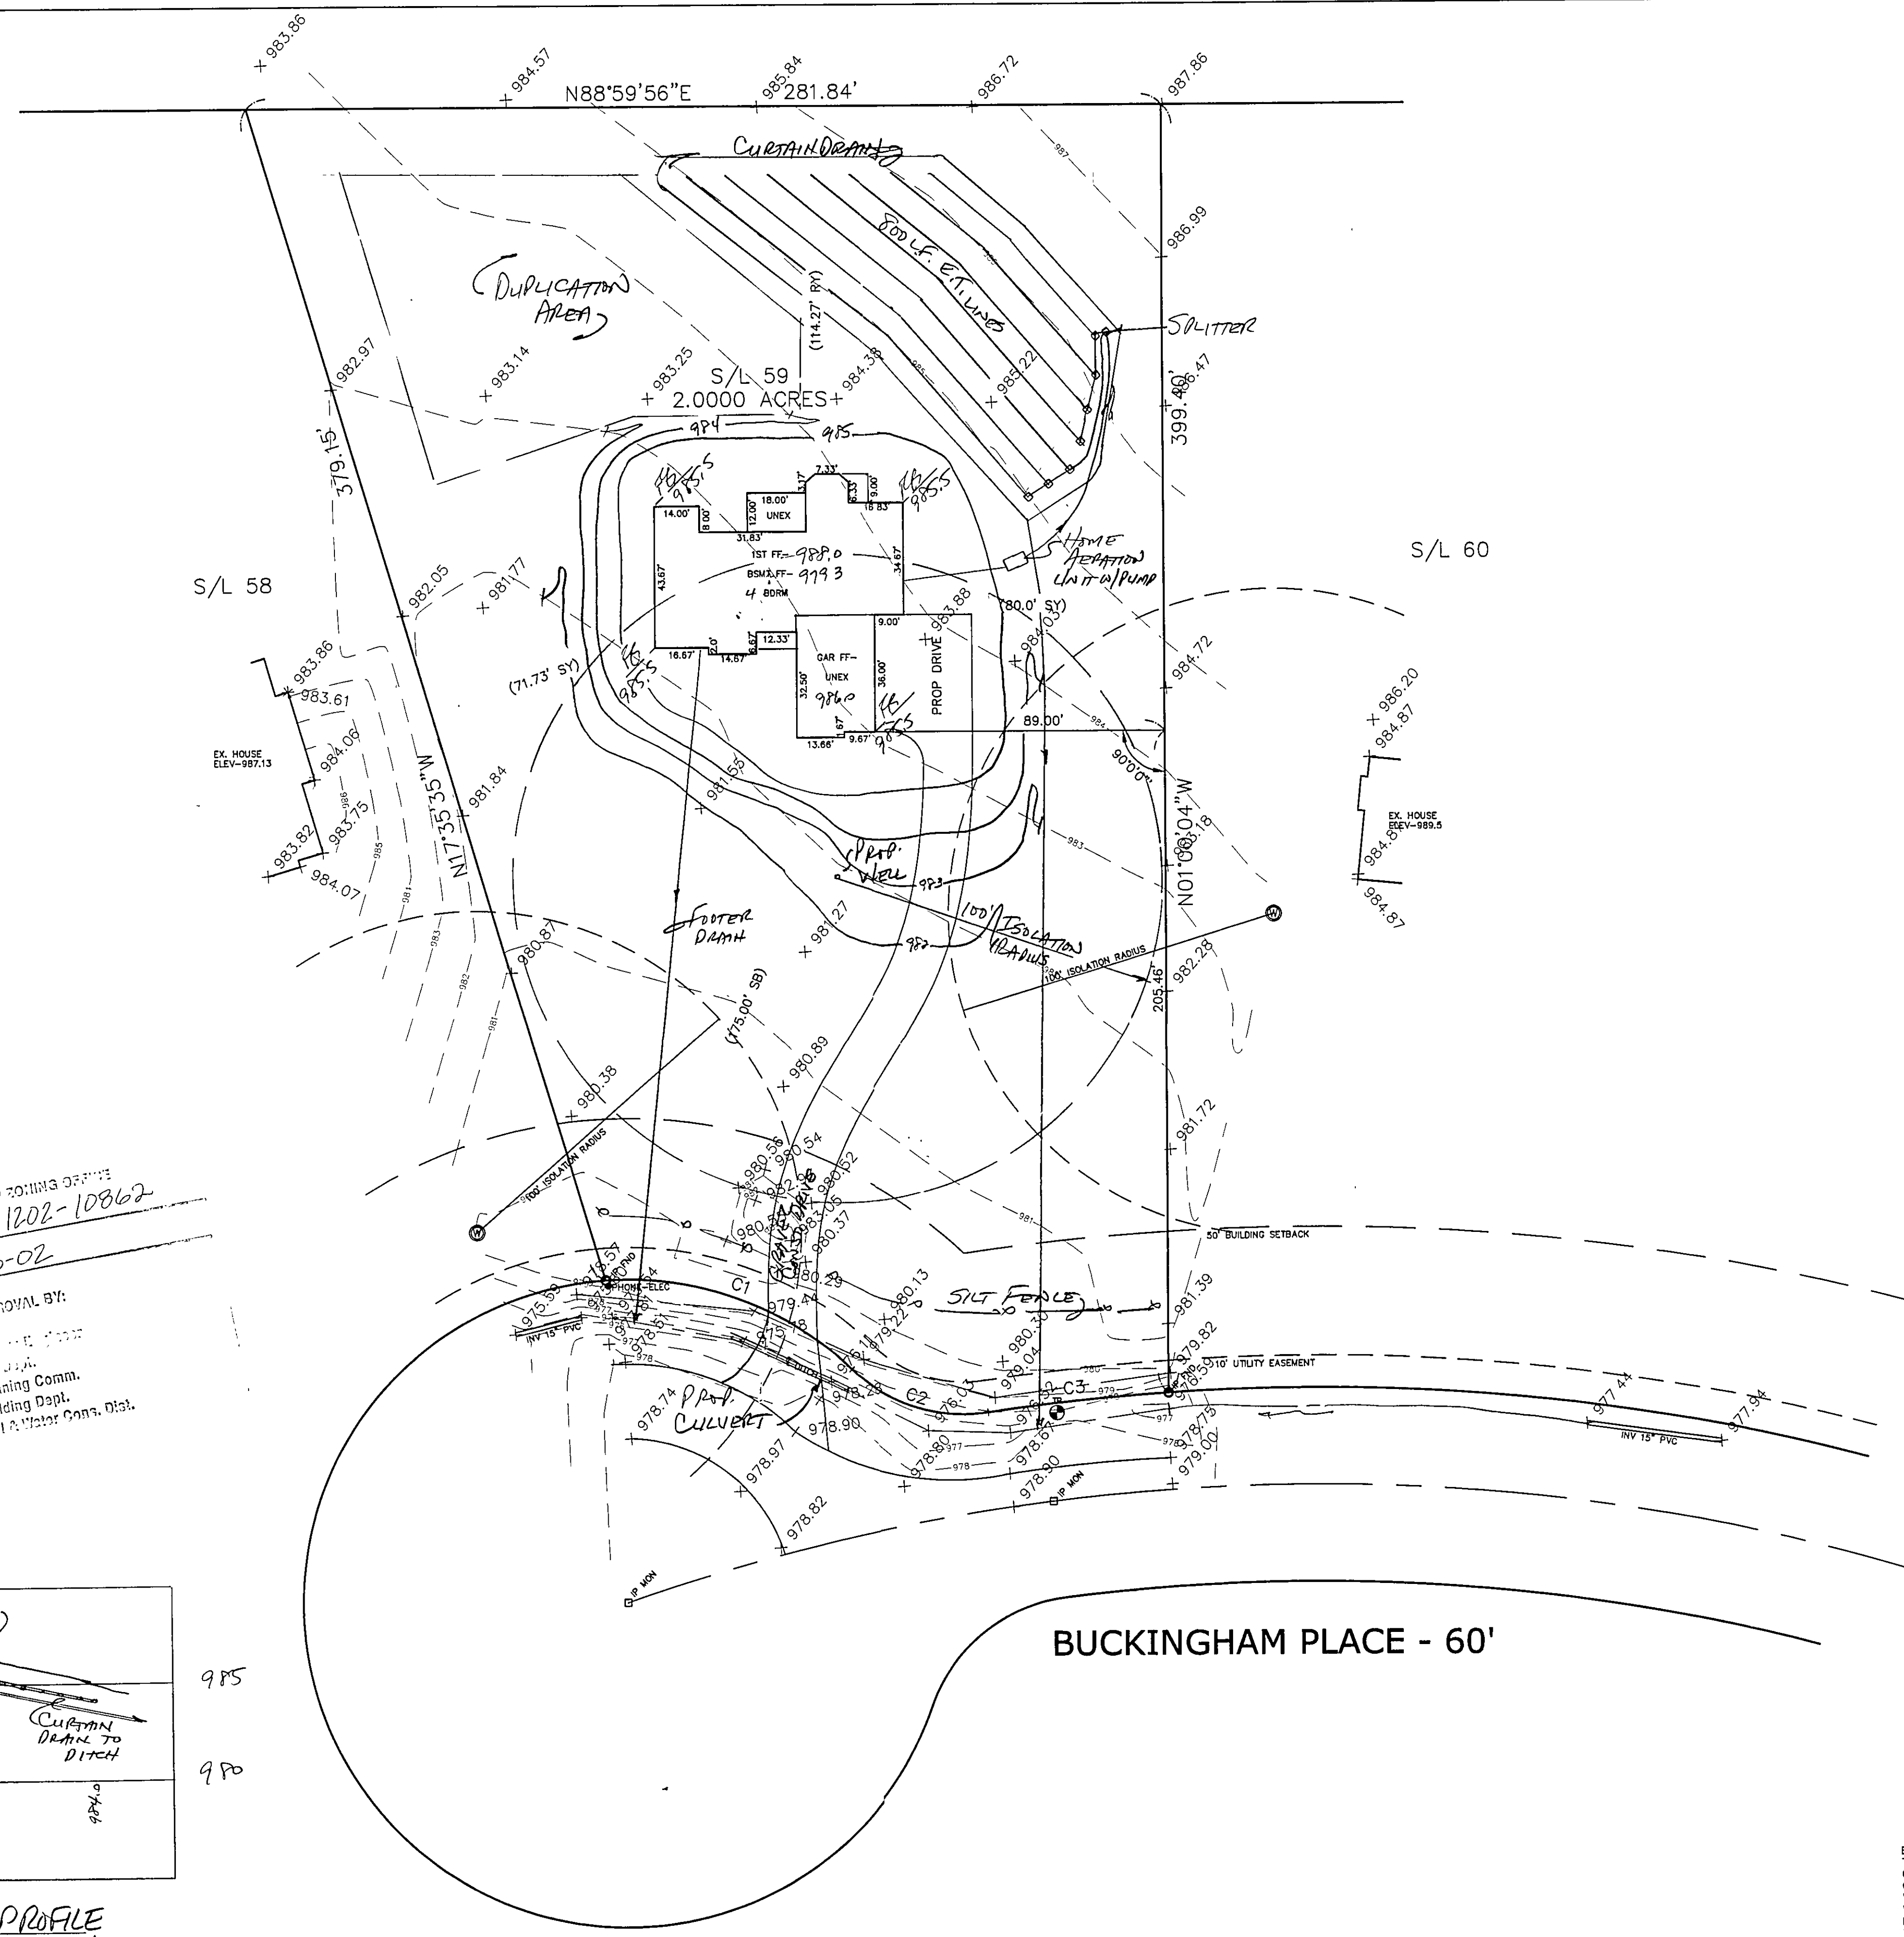
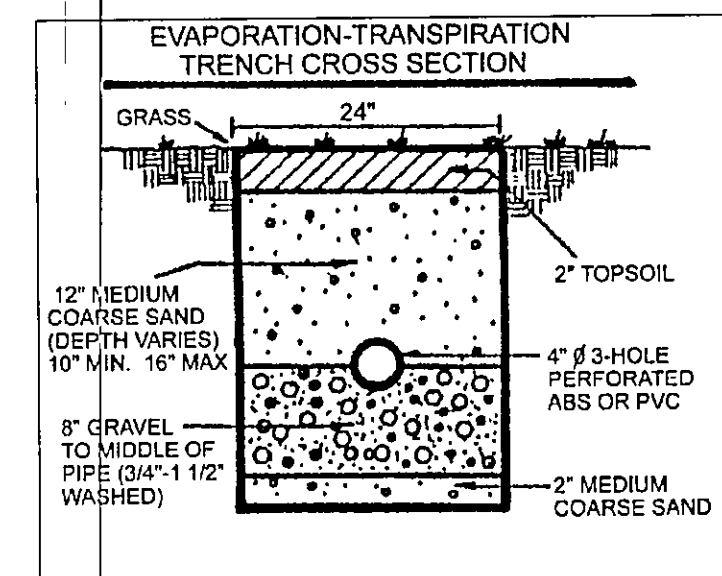


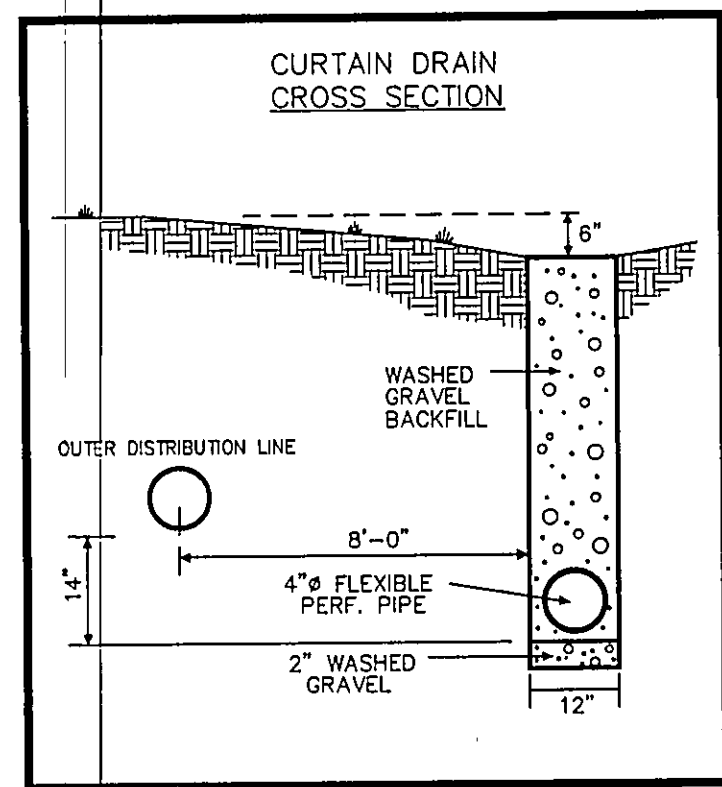

LAKE COUNTY DEPARTMENT OF UTILITIES
NO L.C.D.U. SANITARY SEWERS AVAILABLE
NO L.C.D.U. WATERLINE AVAILABLE

Forrest Bradley DATE 12-16-02

"I, the undersigned hereby certify that this topography indicated by 6", 1", or 2" contours, and elevations shown hereon represent an actual field survey made by me on the 4th day of Dec 20 02 and that the elevations were taken at appropriate intervals and that as of that date they existed as indicated hereon."


Harry Jones #6343
Name Reg. No.

CURVE	LENGTH	RADIUS	TANGENT	CHORD	BEARING	DELTA
C1	83.30	100.00	44.24	80.92	S70°35'29"E	47°43'47"
C2	45.94	50.00	24.73	44.34	N73°02'43"W	52°38'17"
C3	55.88	680.00	27.95	55.88	N82°59'23"E	04°42'29"


ROOF DRAINS SHALL DISCHARGE TO SPLASH BLOCKS.

Grading Plan Approved as shown and/or noted
JAMES R. GILLS, P.E.
Lake County Engineer
By Date 12/26/02

EXISTING UTILITIES NOTE:
THE SIZE AND LOCATION, BOTH HORIZONTAL AND VERTICAL OF THE UNDERGROUND UTILITIES SHOWN HEREON, HAVE BEEN OBTAINED BY A SEARCH OF AVAILABLE RECORDS. VERIFICATION BY FIELD OBSERVATION HAS BEEN CONDUCTED WHERE PRACTICAL. HOWEVER, BABCOCK, JONES AND ASSOCIATES, INC. DOES NOT GUARANTEE THE COMPLETENESS NOR ACCURACY THEREOF.

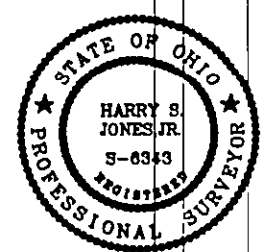

REVIEWED AND APPROVED
LAKE COUNTY ENGINEER
DATE 12-17-02 Daniel Hall

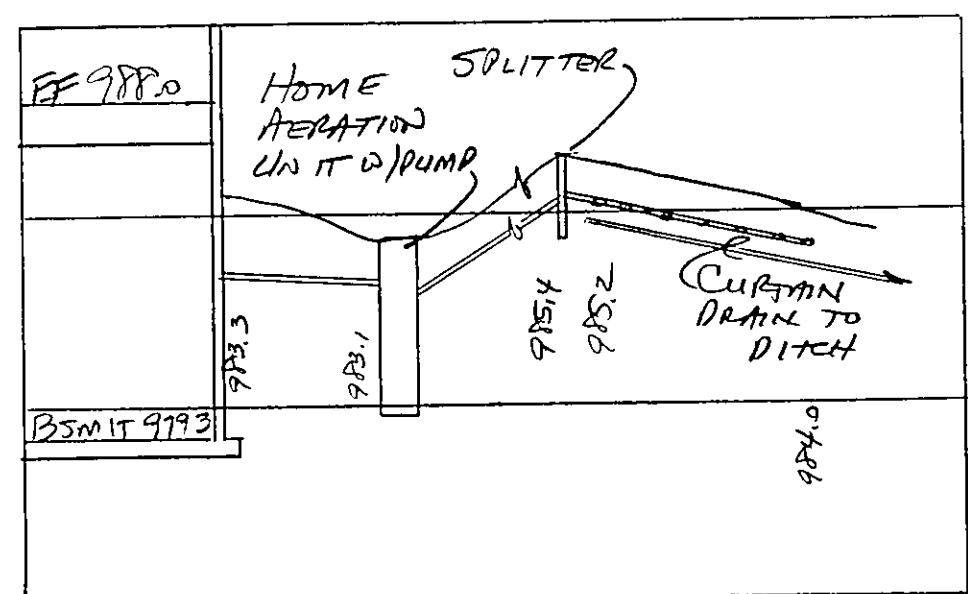

HYDRAULIC PROFILE
HORIZ 1"=30' VERT 1"=5'

REV NO.	DESCRIPTION	DATE	BY	CHK'D

bj BABCOCK, JONES AND ASSOCIATES, INC
CIVIL ENGINEERS - SURVEYORS - LAND PLANNERS
PAINESVILLE OHIO 44077

DATE	12/05/02
DESIGN BY	HJ
DRAWN BY	NS
APPROVED BY	HJ

SITE PLAN FOR SULLIVAN
CONCORD TOWNSHIP LAKE COUNTY STATE OF OHIO

SCALE	1"=30'
JOB NO.	93-163-59
SHEET	1 OF 1