

— x — SILT FENCE

NOTE: SEEDING OR MULCHING SHALL BE COMPLETED WITHIN 30 DAYS OF COMPLETION OF HOUSE.

LIMIT OF DISTURBANCE: ALL OF LOT.

 = TEMP. SEEDING & MULCHING

Erosion and Sediment Control Schedule

Ingress-Egress
A stone access drive complete with under lying geo-textile fabric (20 feet wide and 50 feet long) for ingress and egress at the site shall be installed. This drive shall be the only entrance and exit to the site.

Silt Fence
All silt fences shall be installed prior to any earthwork activities at the site in the locations shown on the site plan as well as along the front of any lot that slopes towards the street.


Temporary Seeding
Disturbed areas of the site that are to remain idle for more than Twenty-one (21) days shall be properly seeded and sown mulched within seven (7) days of completion of initial grading. Temporary seeding and mulching of a thirty (30) foot strip of the entire front of the lot shall be maintained on the site once initial grading is complete.

Stabilization of critical areas within fifty (50) feet of any stream or wetland shall be complete within two (2) days of the disturbance if the site is to remain inactive for longer than fourteen (14) days.


Mulching
Stream banks shall be applied at a rate of 1 bale per every ten (10) feet of curb, or a width of thirty (30) feet of the entire length of the lot. Wood chips may also be used but must be spread at a minimum depth of four inches over the thirty-foot width and must be accompanied by a properly installed silt fence.

Maintenance
Erosion and sediment controls shall be inspected every seven (7) days or within 24 hours of a 0.5" or greater rainfall event. Necessary repairs shall be made at this time.

Construction Entrance Detail

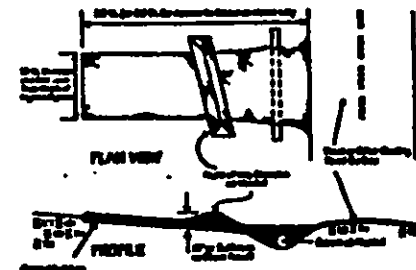

Silt Fence Detail

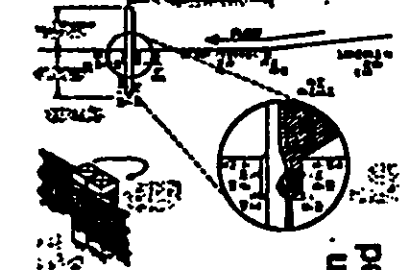

Stormwater Management Plan
Approved as shown and/or noted
JAMES R. GILLS, P.E.
County Drainage Engineer,
By J.S. Date 9/6/05


SITE PLAN

for: **DAVEN BUILDERS**
16011 WASHINGTON ST. CHAGRIN FALLS
ADDRESS STREET CITY
58 MOUNTAINSIDE FARMS
SUBLOT No. SUBDIVISION NAME VOL. PAGE
9-10, 4 CONCORD OHIO
LOT, TRACT TOWNSHIP/CITY/VILLAGE

GUTOSKEY & ASSOCIATES INC.
Civil Engineers, Surveyors & Land Planners
17078 Munn Road, Suite 3 Tel (440) 543-6900
Chagrin Falls, Ohio 44023 Fax (440) 543-7176

CHECK LIST

LOT DIMENSIONS & BEARINGS
TIE TO NEAREST STREET
SUBLOT No. (PARCEL No.)
SURROUNDING OWNERS
BUILDING DIMENSIONS
SETBACK, SIDEYARD, REARYARD
FINISHED GRADES
DRIVE & APRON TYPE, WIDTH, THICKNESS
SIDEWALK TYPE, WIDTH, THICKNESS
CULVERT TYPE, DIAM., LENGTH
WATER MAIN SIZE, LOCATION
SAN. M.H. CAST. ELEV., INV. ELEV.
SAN. M.H. SIZE, GRADE, LOCATION
STORM SEWER SIZE, GRADE, LOCATION
STORM M.H. CAST. ELEV., INV. ELEV.
PAV'T. TYPE, GRADE, CURBS
GAS LINE LOC. SIZE
SEPTIC SYSTEM & DUPLICATION
WELL LOCATION & ISOLATION RADIUS

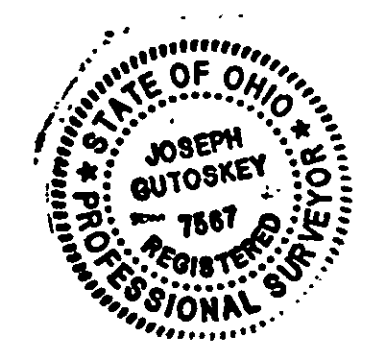

STATE SEAL

DESIGN CERTIFICATION

THIS PLAT WAS PREPARED BY ME, AND IS CORRECT TO THE BEST OF MY KNOWLEDGE.

Joseph Gutoskey P.S. #7567 DATE 8/22/05

"AS-BUILT" CERTIFICATION

I HEREBY CERTIFY THAT THE CIRCLED INFORMATION IS EXISTING AS OBTAINED ON THE SITE 20 AND IS CORRECT TO THE BEST OF MY KNOWLEDGE AND BELIEF.

JOSEPH GUTOSKEY P.S. #7567

LEGEND

STORM MANHOLE 
SANITARY MANHOLE 
EXISTING CONTOURS  100
PROPOSED CONTOURS  100
EXIST. ELEV. 100.0
100.0 PROP. ELEV.
DIRECTION OF SURFACE DRAINAGE 

DRAWN BY	SK	SCALE	1"=20'
CHK'D BY	JG	DATE	8/2005
REV.			
REV.			
REV.			

BENCHMARK: TOP NUT OF HYDRANT AS SHOWN
ELEV. 954.93


* DRIVE APRON SHALL BE
6" THICK CONCRETE.

2 WORKING DAYS BEFORE YOU DIG
CALL TOLL FREE 800-362-2764
OHIO UTILITIES PROTECTION SERVICE


CONTRACTOR SHALL VERIFY ELEVATIONS,
OF LATERAL INVERTS IN THE FIELD AT
THE TIME OF FOUNDATION EXCAVATION.

○ 5/8" IRON PIN FOUND, ID. GUTOSKEY 7567

GRAPHIC SCALE

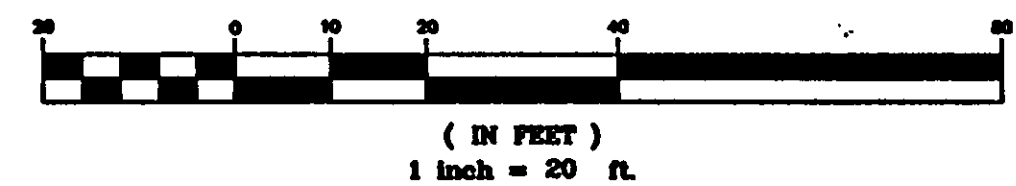

CONTRACT NO.
05-2027-58

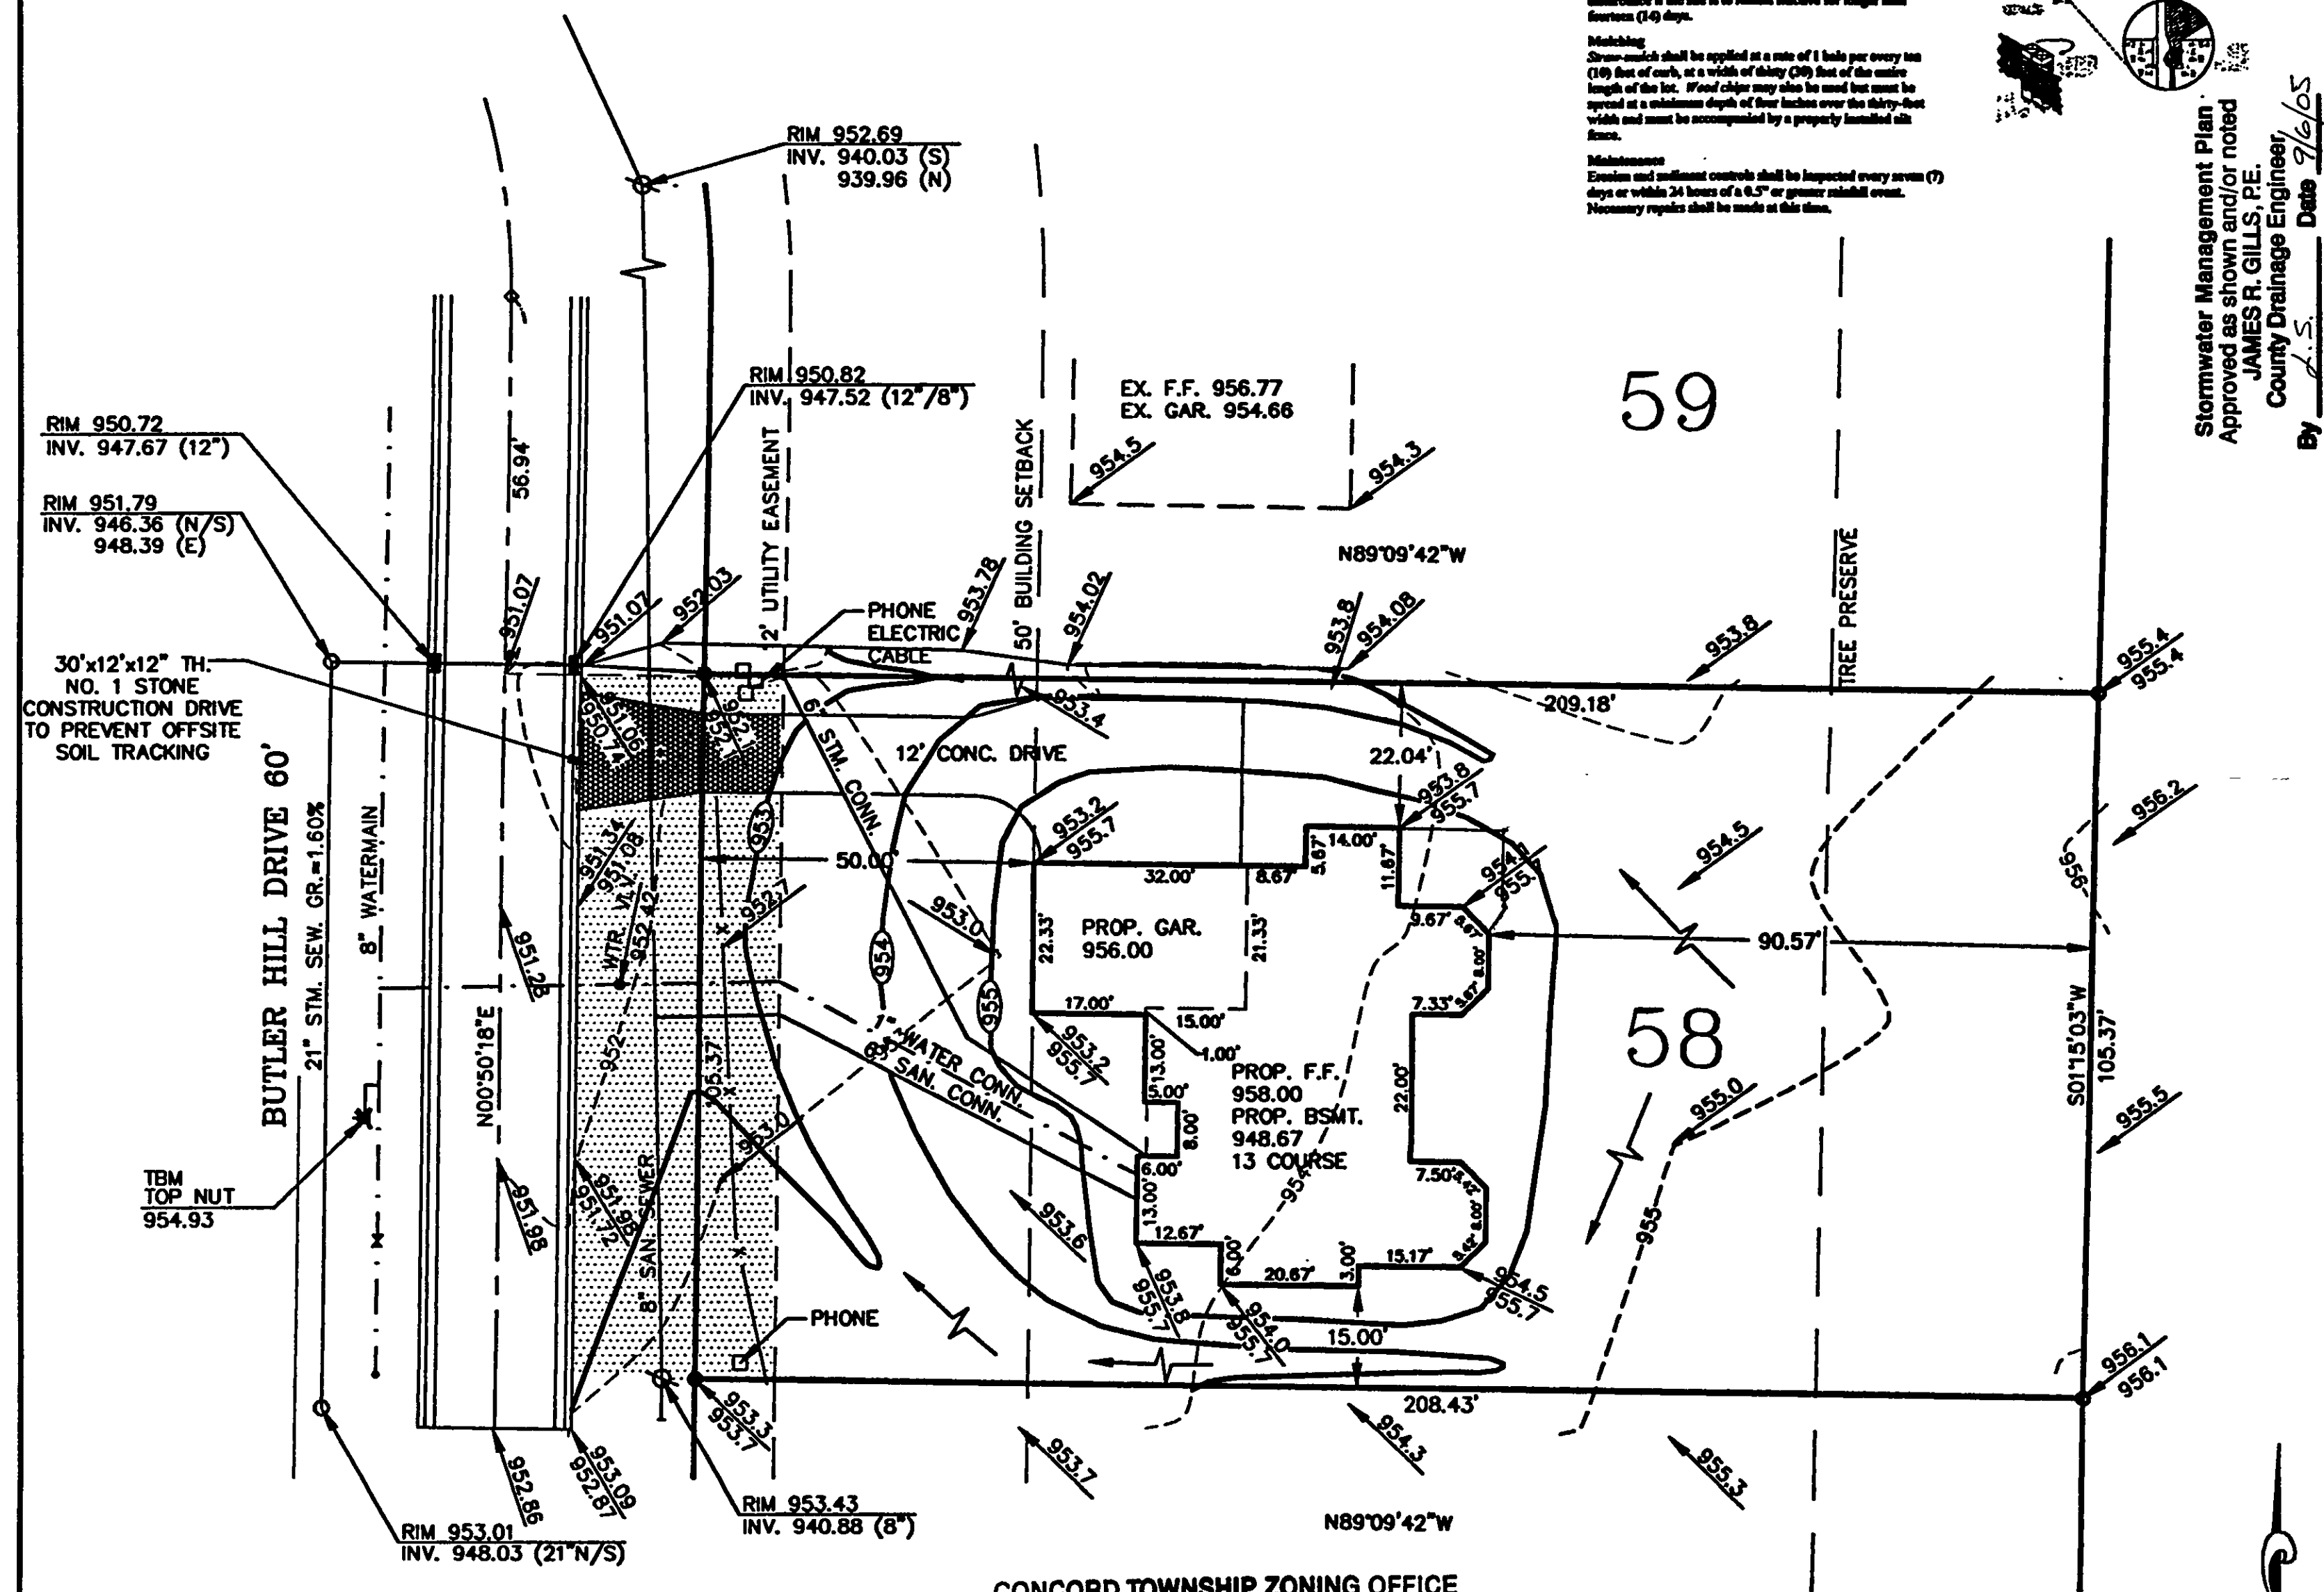

CONCORD TOWNSHIP ZONING OFFICE
Zoning Permit # 0805-12388
Date Issued 9/2/05
Subject to Approval By:
☒ Lake Co. Engineer/Storm Water Mgmt.
☒ Lake Co. Utilities Dept.
☒ Lake Co. Soil + Water District
☒ Lake Co. Health District
☒ Lake Co. Building Dept.