

"I, THE UNDERSIGNED HEREBY CERTIFIES THAT THIS TOPOGRAPHY INDICATED BY 1 FOOT CONTOURS AND ELEVATION SHOWN HEREON REPRESENTS AN ACTUAL SURVEY MADE BY ME ON THE 5TH DAY OF DECEMBER, 2013 AND THE ELEVATIONS WERE TAKEN AT AN APPROPRIATE INTERVAL AND AS OF THAT DAY THEY EXISTED AS INDICATED HEREON.

"I HEREBY CERTIFY THAT THIS PLAN WAS PREPARED BY ME AND IS
CORRECT TO THE BEST OF MY KNOWLEDGE AND BELIEF"

DAVID W. NOVAK, P.S. No. 7507
CERT-1.DWG

Y
Improved as shown.
JAMES R. GILL
County Drainage Engineer
By *L.S.* Date *12/13/13*
EX. STM. MH.
RIM=953.10
INV. 948.12

S/L 70
P.P. No. 08-A-023-F-00-029-0
7978 BUTLER HILL DR
MOUNTAINSIDE FARMS LLC

Builder and all subcontractors shall review this plan to verify house dimensions and all site improvements for any discrepancies, omissions and/or changes and notify Barrington Consulting Group, Inc. prior to any site work.

GENERAL NOTES:

1. BENCHMARK - TOP STEM OF EXISTING FIRE HYDRANT LOCATED IN FRONT SUBLOT 73, ELEVATION = 970.56.
2. DRIVEWAY APRON TO BE 6" THICK CONCRETE.
3. ALL DOWNSPOUTS TO BE TIED INTO STORM CONNECTION.
4. CONTRACTOR RESPONSIBLE FOR CONTACTING THE OHIO UTILITY PROTECTION SERVICE (1.800.362.2764) AND ALL UTILITY COMPANIES A MINIMUM OF 48 HOURS PRIOR TO CONSTRUCTION.
5. THE LOCATION BOTH HORIZONTAL AND VERTICAL OF EXISTING UNDERGROUND UTILITIES SHOWN HEREON, HAVE BEEN OBTAINED BY A DILIGENT AND COMPREHENSIVE SEARCH OF AVAILABLE RECORDS. VERIFICATION BY FIELD OBSERVATION HAS BEEN CONDUCTED WHERE PRACTICAL, HOWEVER, BARRINGTON CONSULTING GROUP, INC. DOES NOT GUARANTEE THE COMPLETENESS, NOR ACCURACY THEREOF.
6. CONTRACTOR SHALL VERIFY ELEVATIONS OF LATERAL INVERTS IN THE FIELD PRIOR TO FOUNDATION EXCAVATION.
7. PRIOR TO ANY WORK BEING PERFORMED WITH THE RIGHT OF WAY AND/OR UNDERGROUND UTILITY EASEMENTS, CONTRACTOR SHALL CONFIRM THAT ALL REQUIRED CLEARANCES AND BURY DEPTHS OF ALL UNDERGROUND UTILITIES WILL BE MAINTAINED AS A RESULT OF ANY AND ALL SITE IMPROVEMENTS.
8. SEE SHEET 2 FOR EROSION AND SEDIMENT-CONTROL PLAN
9. SEE SHEET 2 FOR SEEDING INFORMATION

9. SEE SHEET 2 FOR SEEDING INFORMATION
CONCORD TOWNSHIP ZONING OFFICE

Planning Permit # 1213-15203

Letter issued 12/19/2013

Subject to Approval By:

Co. Engineer/Storm Water Mgmt.

Co 111103 Den 5667


1. Co. 6th Cavalry District

100,000,000

HSE E-F FILEV =962 00

~~□ Lake~~ 3500. Building "Det." BASEME


F.F. ELEV.=952.33
(9' POURED WALLS)

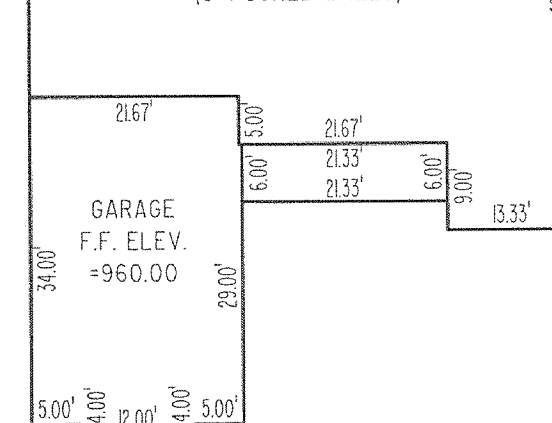

11007-071

[illegible]

Barrington
CONSULTING GROUP, INC.
9114 TYLER BLVD., MENTOR, OHIO 44060
PHONE 440.205.1260 FAX 440.205.1262
www.BarringtonCGI.com

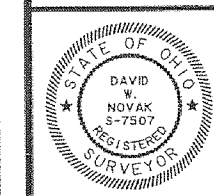

SITE PLAN
7988 BUTLER HILL DR. CONCORD TWP. OHIO 44077
SIL 71 MOUNTAINSIDE FARM'S SUBDIVISION PH. 3A VOL. 61 PG. 7

PROBUILT HOMES, INC.

DRAWN
WSO
CHECKED
DWN
DATE
DEC. 9, 2013
SCALE
1" = 30'
JOB NO.
11007-071
SHEET
1/2
OF SHEETS