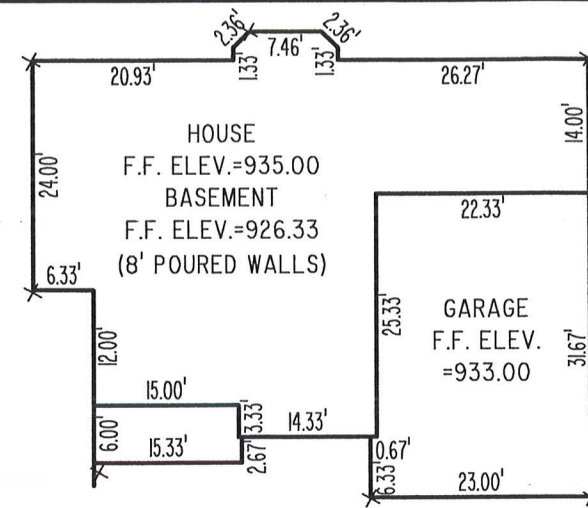
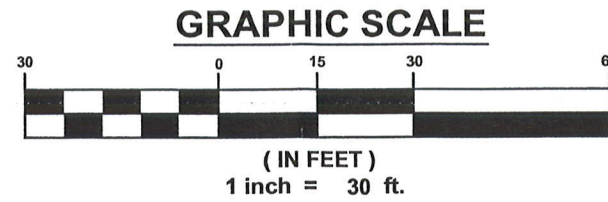


CONCORD TOWNSHIP ZONING OFFICE

Zoning Permit # 0914-15491

Date Issued 1-30-15 revised

Subject to Approval By:

- ☐ Lake Co. Engineer/Storm Water Mgmt.
- ☒ Lake Co. Utilities Dept.
- ☐ Lake Co. Soil + Water District
- ☒ Lake Co. Health District
- ☒ Lake Co. Building Dept.

Stormwater Management Plan
Approved as shown and/or noted
JAMES R. GILLS, P.E.
County Drainage Engineer
By GJH / 1 Date 2/5/2015

[illegible]

Barrington
CONSULTING GROUP, INC.
9114 TYLER BLVD., MENTOR, OHIO 44060
PHONE 440.205.1260 FAX 440.205.1262
www.BarringtonCGI.com



EXISTING GRADING
7831 BUTTERFLY ST., CONCORD TWP., OHIO 44077
S/L 15 NATURE PRESERVE NORTH PH. 1 VOL.48 PG. 26

W.R. DAWSON CONSTRUCTION, INC.

DRAWN
WSO
CHECKED
DWN
DATE
JAN. 29, 2015
SCALE
1" = 30'
JOB NO.
14096-015
SHEET
1 / 1
OF SHEETS

