

MICHAEL FISHMAN CONST CO.
3638 RAYMONT BOULEVARD
UNIVERSITY HIGTS., OHIO.
BEING SUBLOT NO. 42 IN CHERRY HILLS SUBD.
IN CONCORD TWP., OHIO.

WM. R. GRAY ASSOC., INC.
1547 MENTOR AVENUE
MENTOR, OHIO 44060
DATE: JUNE 19, 1973 SCALE: 1" = 30'

DATE: JUNE 19, 1973 SCALE: 1" = 30' DRAWN BY CR




HEREBY CERTIFY THAT THIS PLAN
IS CORRECT TO THE BEST OF MY KNOWLEDGE

WM. R. GRAY, REG. SURV. #2752
PROF. ENG. #6421

CIVIL ENGINEERS
SURVEYORS

NORTH

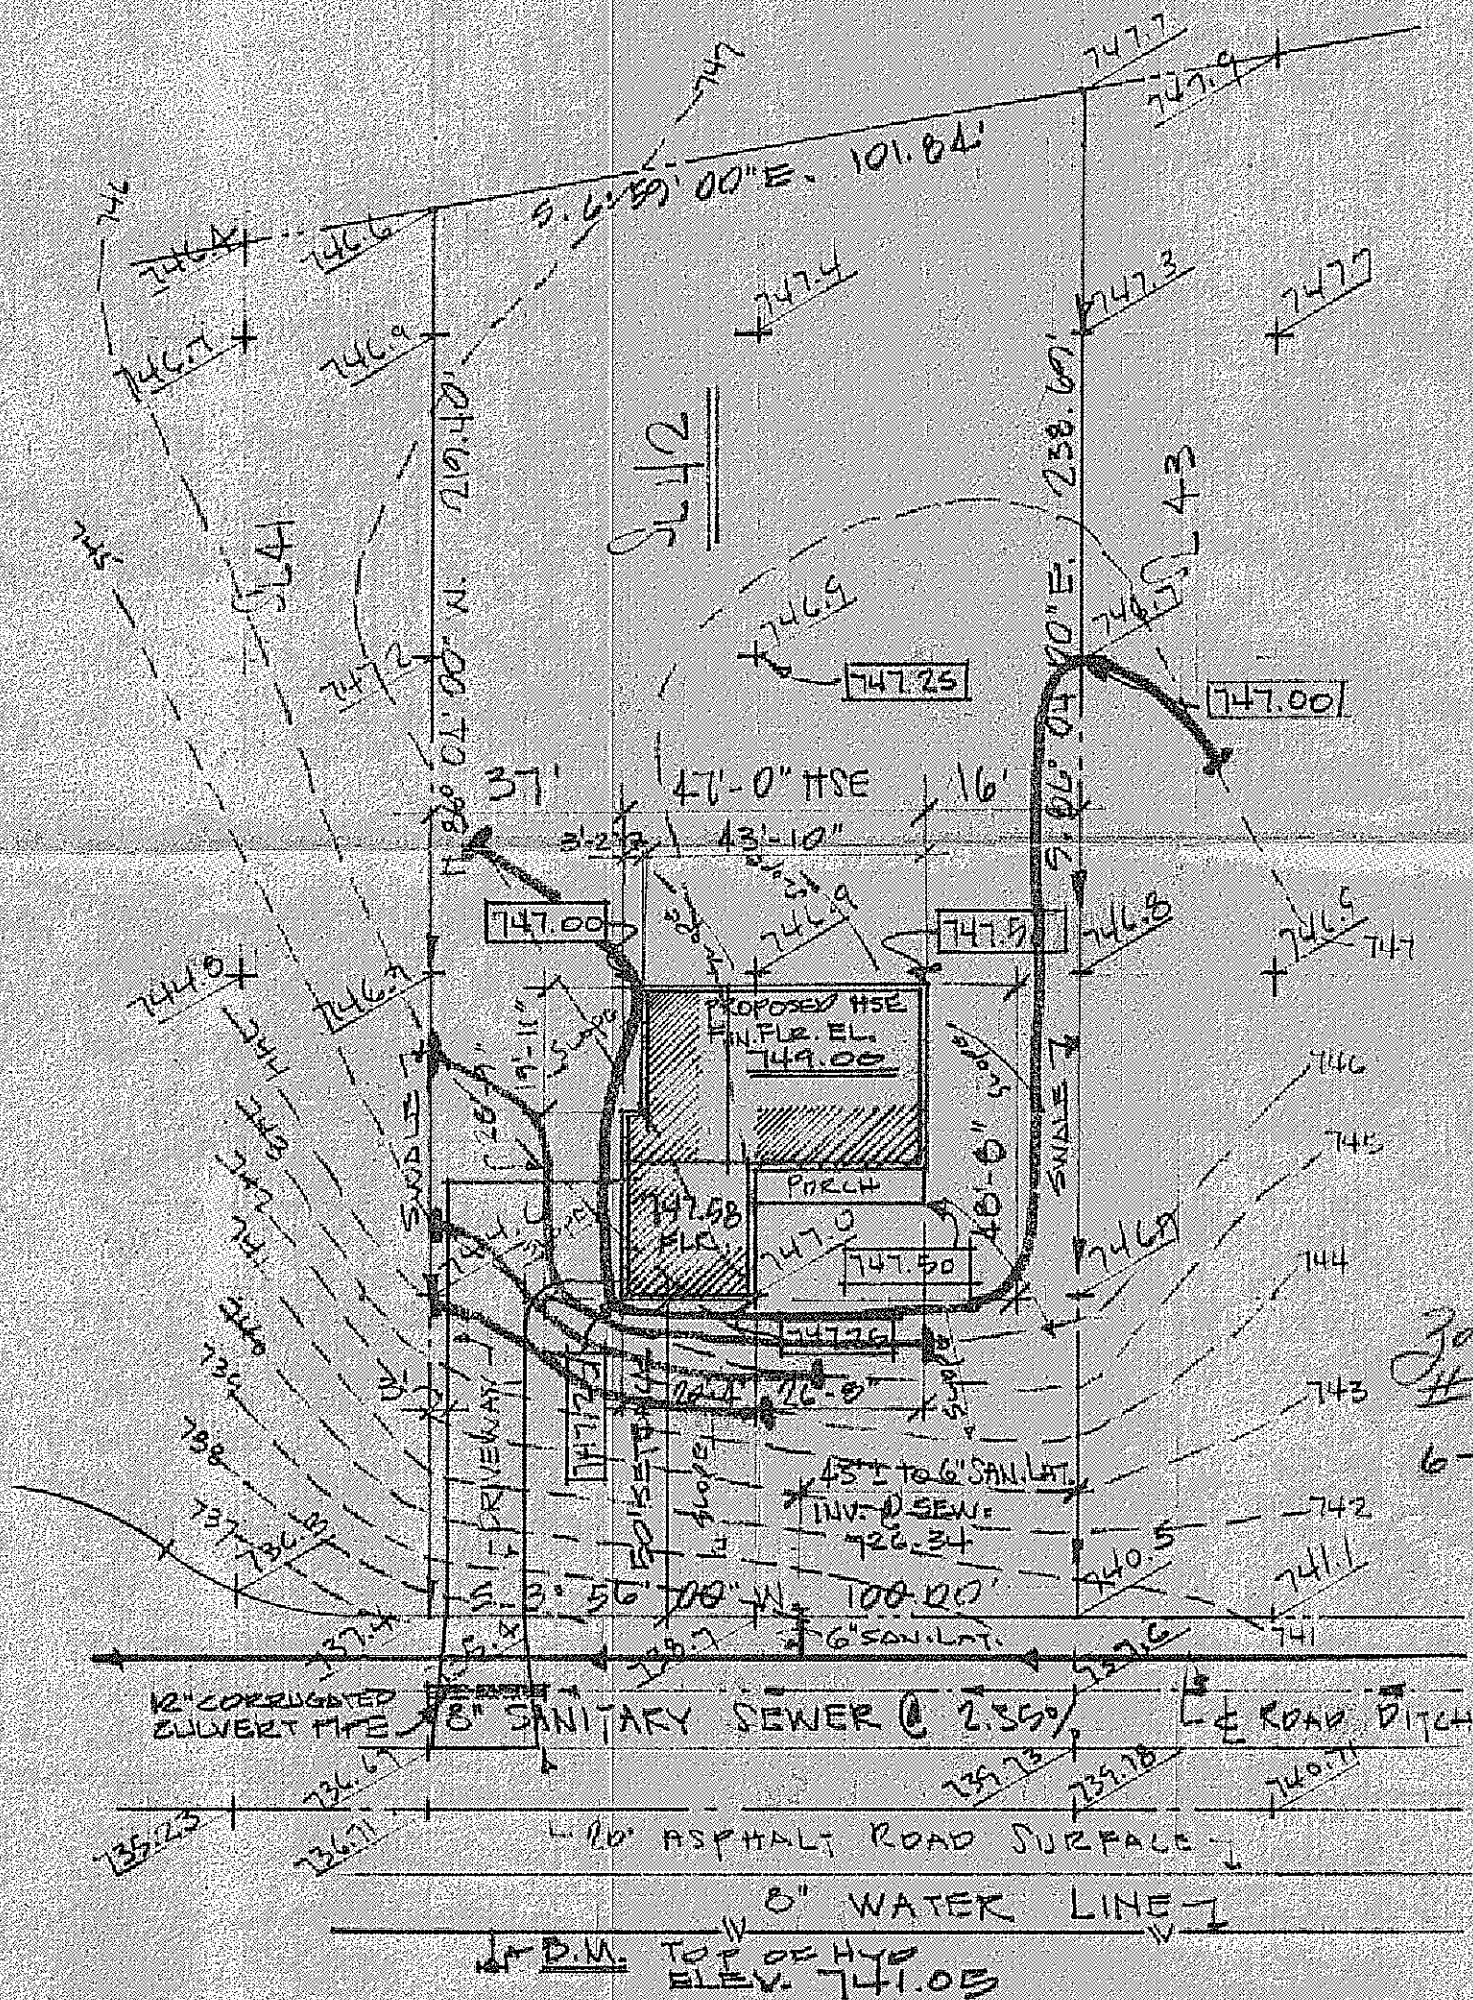

Zoning Permit
2505 issued
6-21-73

H. E. van Dierk

CHERRY HILL DRIVE 60'

Grading Plan Approved
as shown and/or noted
THOMAS P. GILLES, P.E.
Lake County Engineer

By JWK Date 26 June 73