


NOTE: UNDERLINED ELEVATIONS
INDICATE PROPOSED ELEVATIONS

BENCH MARK: TOP OF
FIRE HYDRANT - 1ST ON
CHERYL DRIVE SOUTH
OF RT. 24 - EL. 703.59

CURVE DATA
R: 720.58'
A: 129.09'
Δ: 10° 15' 53"
T: 64.72'
C: 128.92'
S. 6° 57' 46" E.

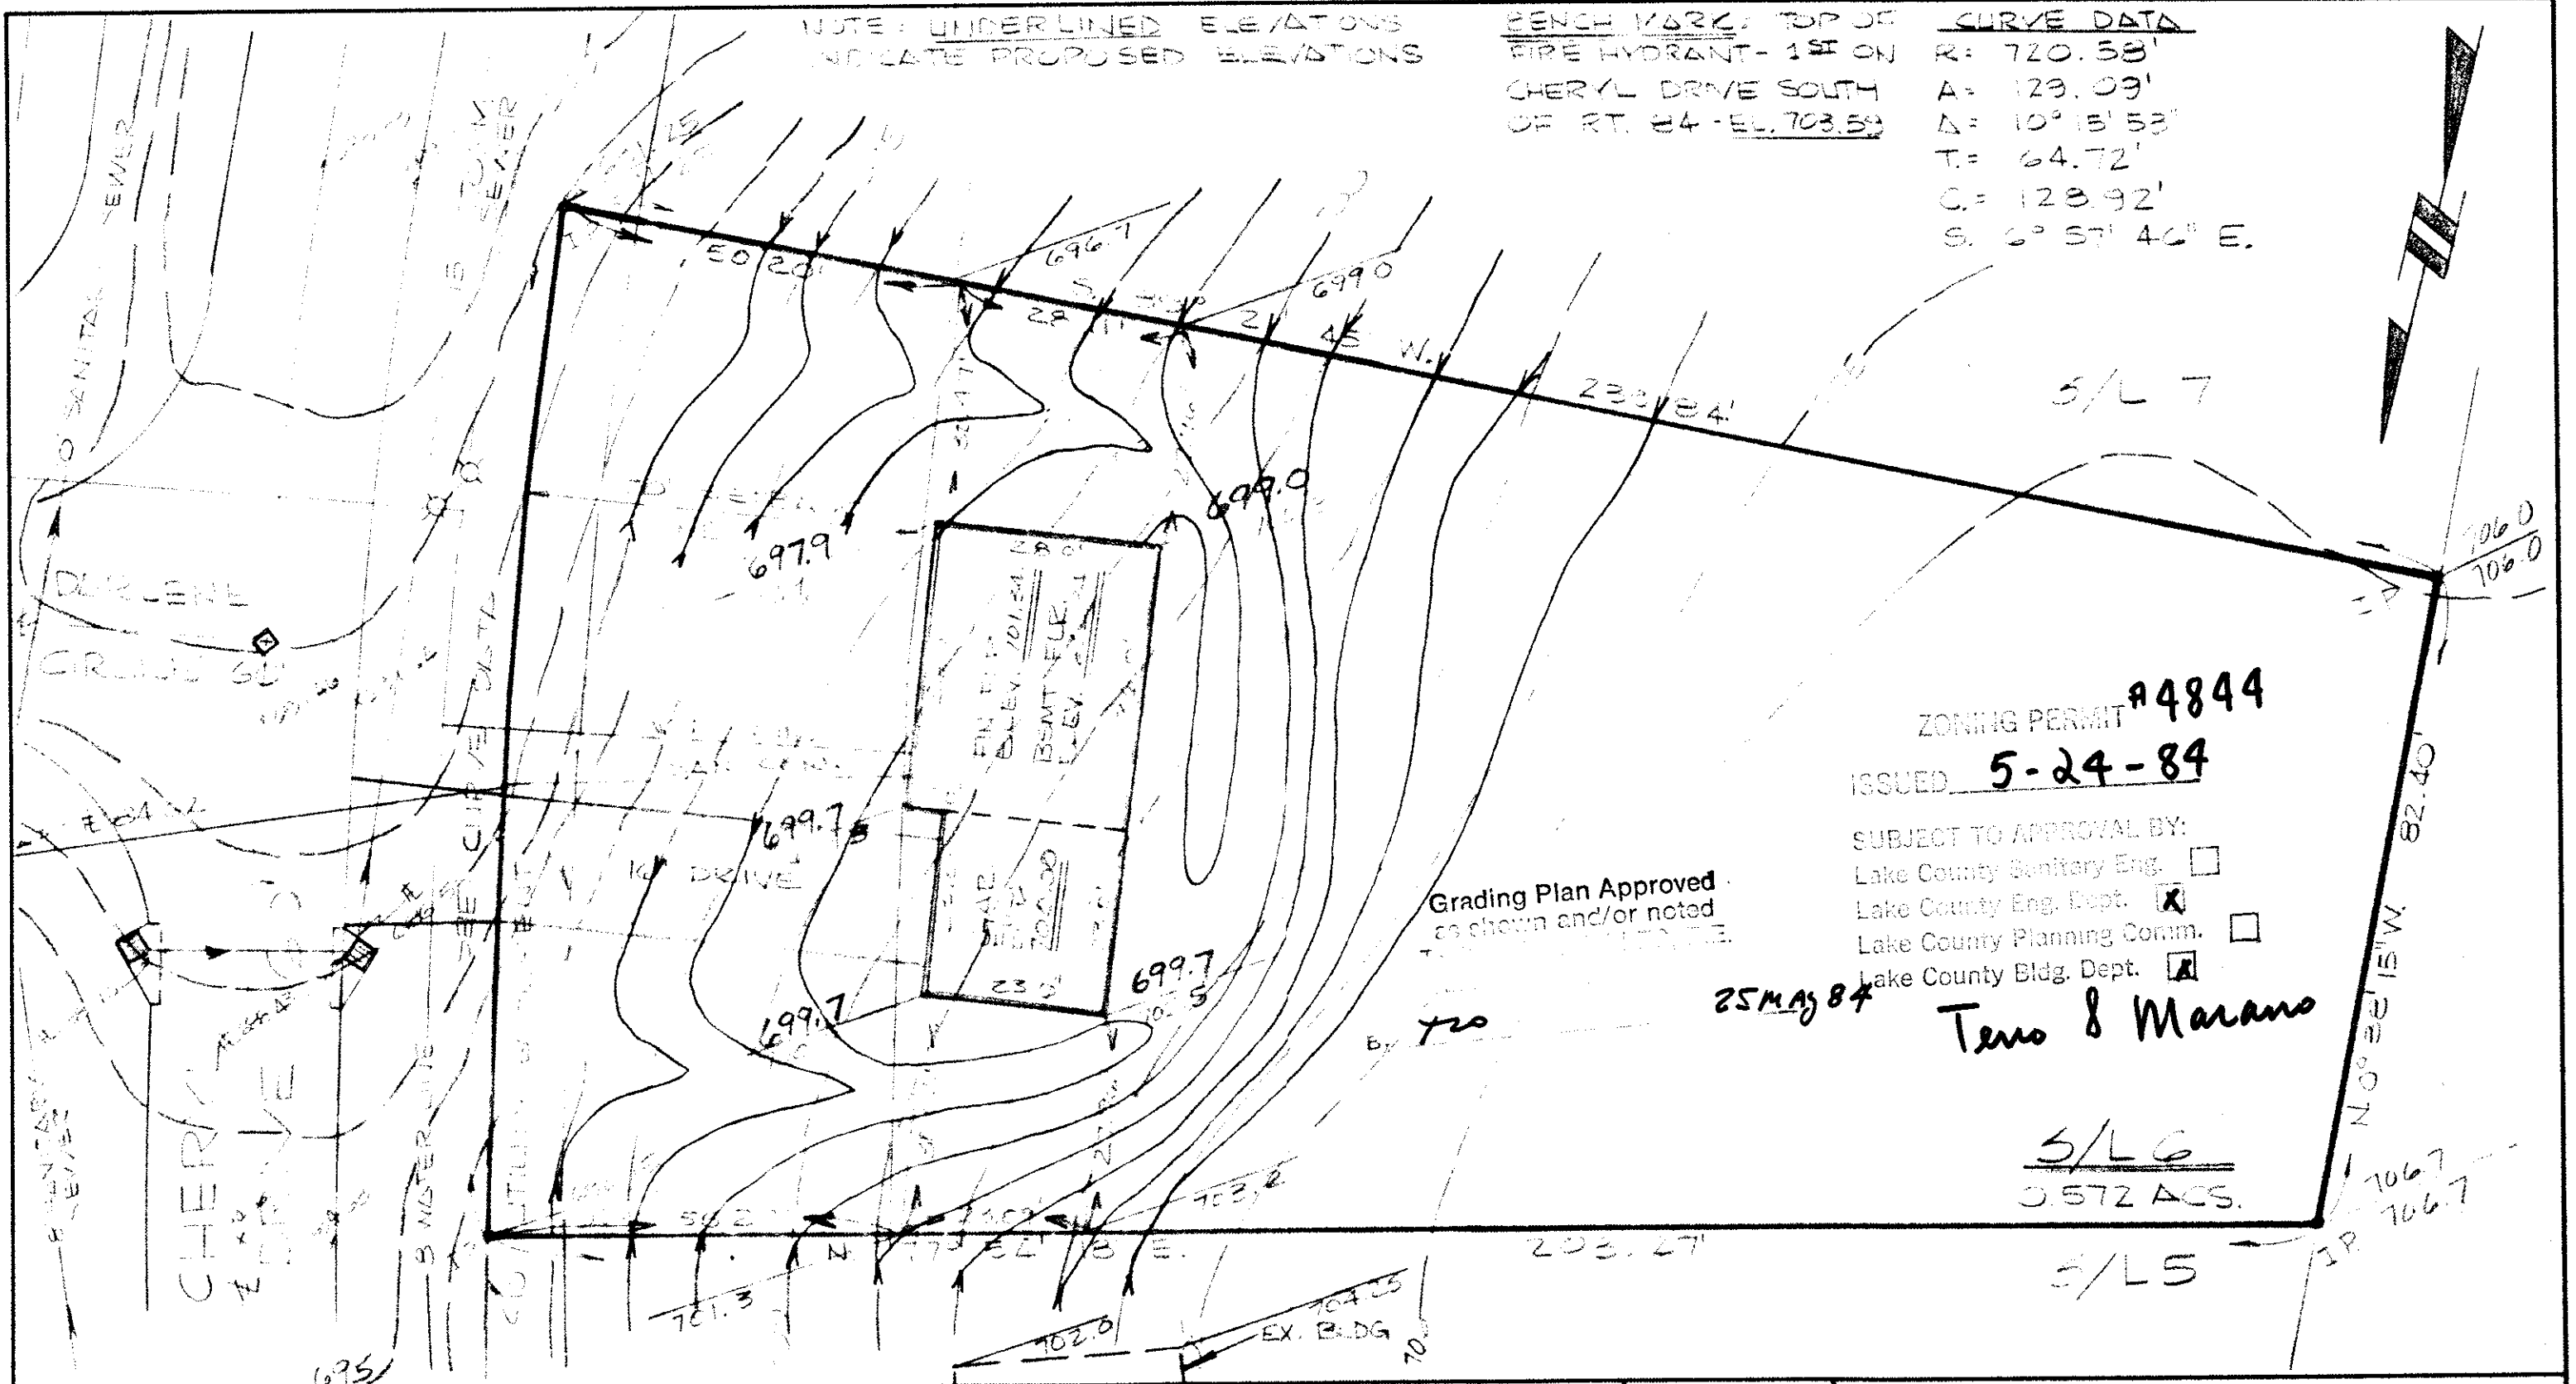

ZONING PERMIT **#4844**
ISSUED **5-24-84**

SUBJECT TO APPROVAL BY:
Lake County Sanitary Eng. ☐
Lake County Eng. Dept. ☒
Lake County Planning Comm. ☐
Lake County Bldg. Dept. ☒

Grading Plan Approved
as shown and/or noted
TERRY J. MARANO, P.E.

25 MAY 84

Terry J. Marano

S/L 6
0.572 ACS.

S/L 5

DESIGN CERTIFICATION

THIS PLAT WAS PREPARED BY ME,
AND IS CORRECT TO THE BEST OF
MY KNOWLEDGE AND BELIEF.

[Signature]
REG. SURVEYOR NO. 144

AS BUILT CERTIFICATION

I HEREBY CERTIFY THAT THE CIRCLED GRADES
ARE EXISTING FINISH GRADES CHECKED IN THE
FIELD ON AND THAT
SURVEY IS CORRECT TO THE BEST OF MY
KNOWLEDGE AND BELIEF.

REG. SURVEYOR NO.



COLPETZER · WOODS
CONSULTANTS, INC.

DATE 5-23-84
SCALE 1"=20'
DRWN BY RLS
CHKD BY
JOB NO. 84-129
FB

TOPOGRAPHIC AND SITE PLAN
FOR

WYNN SPALLER

BEING S/L 6, CONCORD KELLOGG PARK ESTATES
CONCORD TWP., LAKE COUNTY, OHIO