

CURVE DATA:

R = 280.00'
 $\Delta = 19^{\circ}34'47''$
 A = 95.68'
 T = 48.51'
 C = 95.22'
 S 47°58'37" E

SITE PLAN FOR:

RYAN HOMES
 8141 TYLER BLVD.
 MENTOR, OHIO

BEING SUBLOT NUMBER 38 IN
 THE FAR HILLS ESTATES NUMBER
 2 IN CONCORD TOWNSHIP, LAKE
 COUNTY, OHIO

PREPARED BY:

WM. R. GRAY ASSOC. INC.
 7547 MENTOR AVENUE
 MENTOR, OHIO



SCALE: 1" = 30'
 DATE: AUG 25 1977

CERTIFICATION:

I HEREBY
 CERTIFY THAT THIS
 PLAT IS CORRECT
 TO THE BEST OF
 MY KNOWLEDGE.

BY: Wm. R. Gray
 WM. R. GRAY REG. SURV. #2752

Grading Plan Approved
 as shown and/or noted
 THOMAS P. GILLES, P.E.
 Lake County Engineer
 By: Tom Date: Sept 77

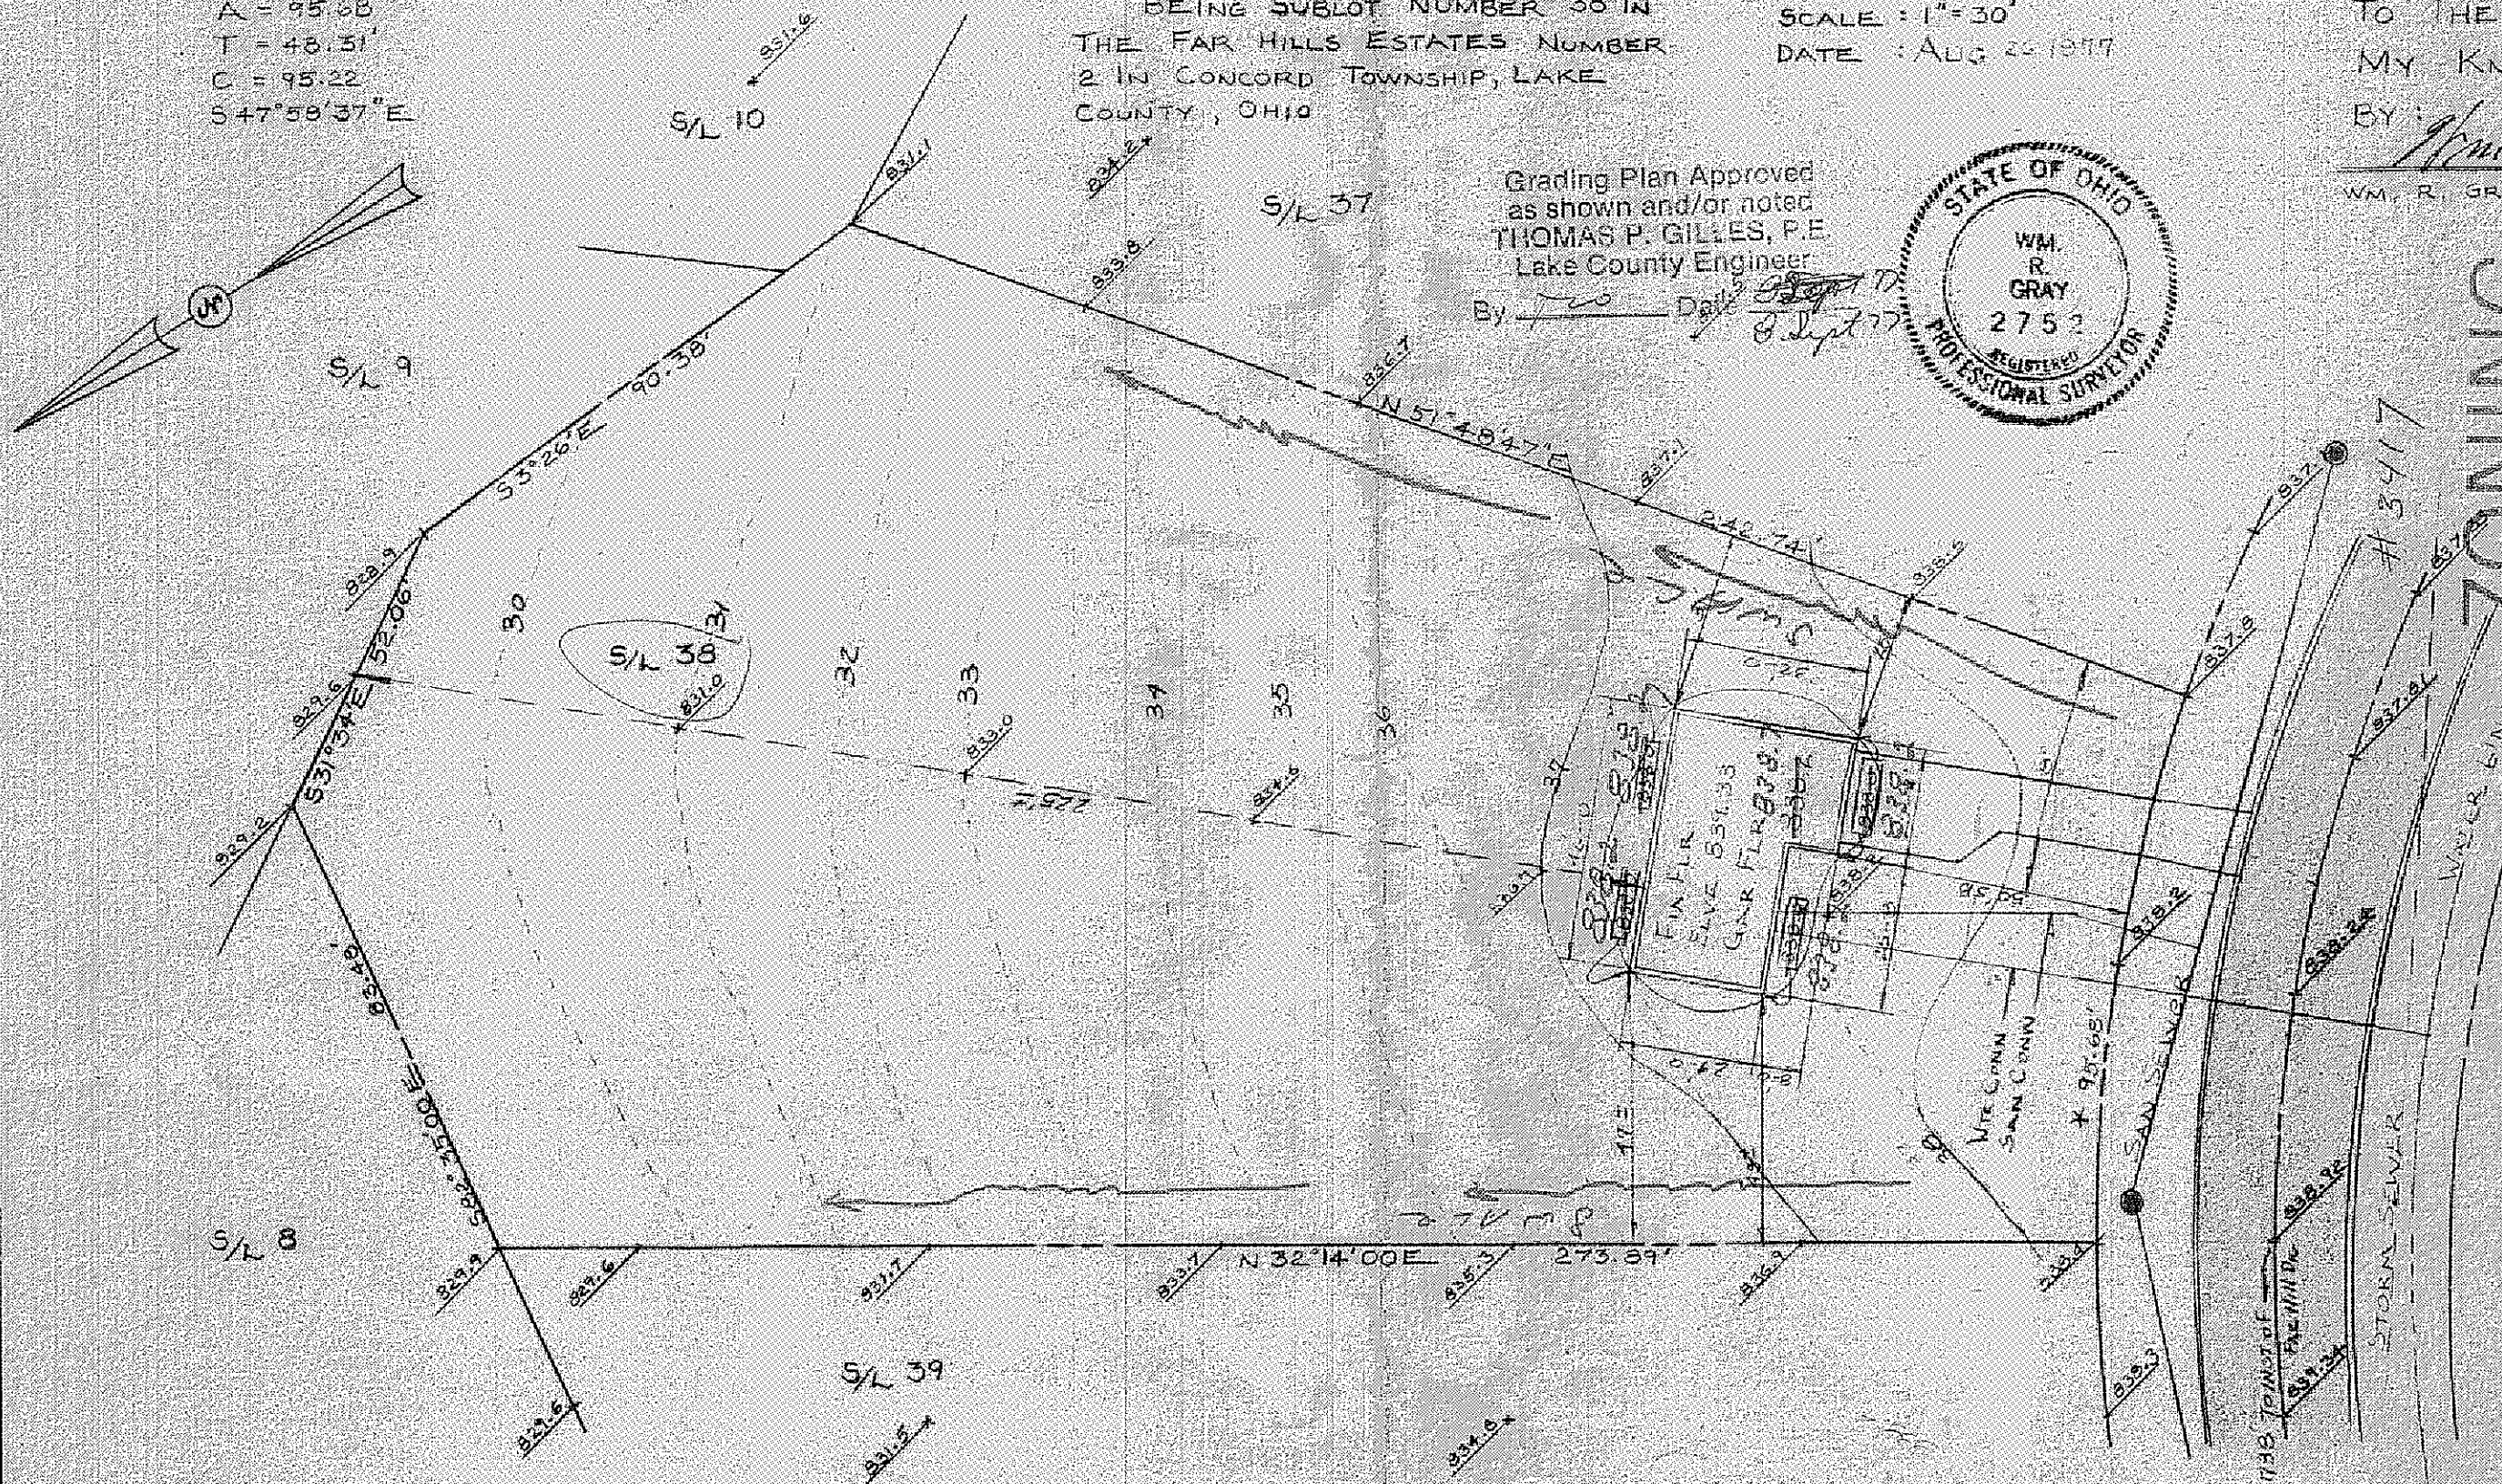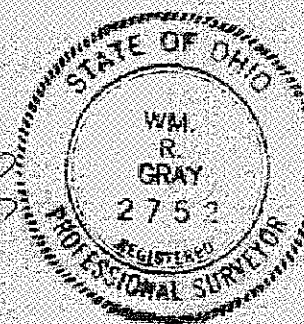

CHRISTIAN AVE CO.
 ZONING PERMIT
 #3417

Approved 9-3-77

Wm. R. Gray