



W:\2010\01\0010100.dwg, 17/02/2011 7:30:11 AM, Copyright Barrington Consulting Group

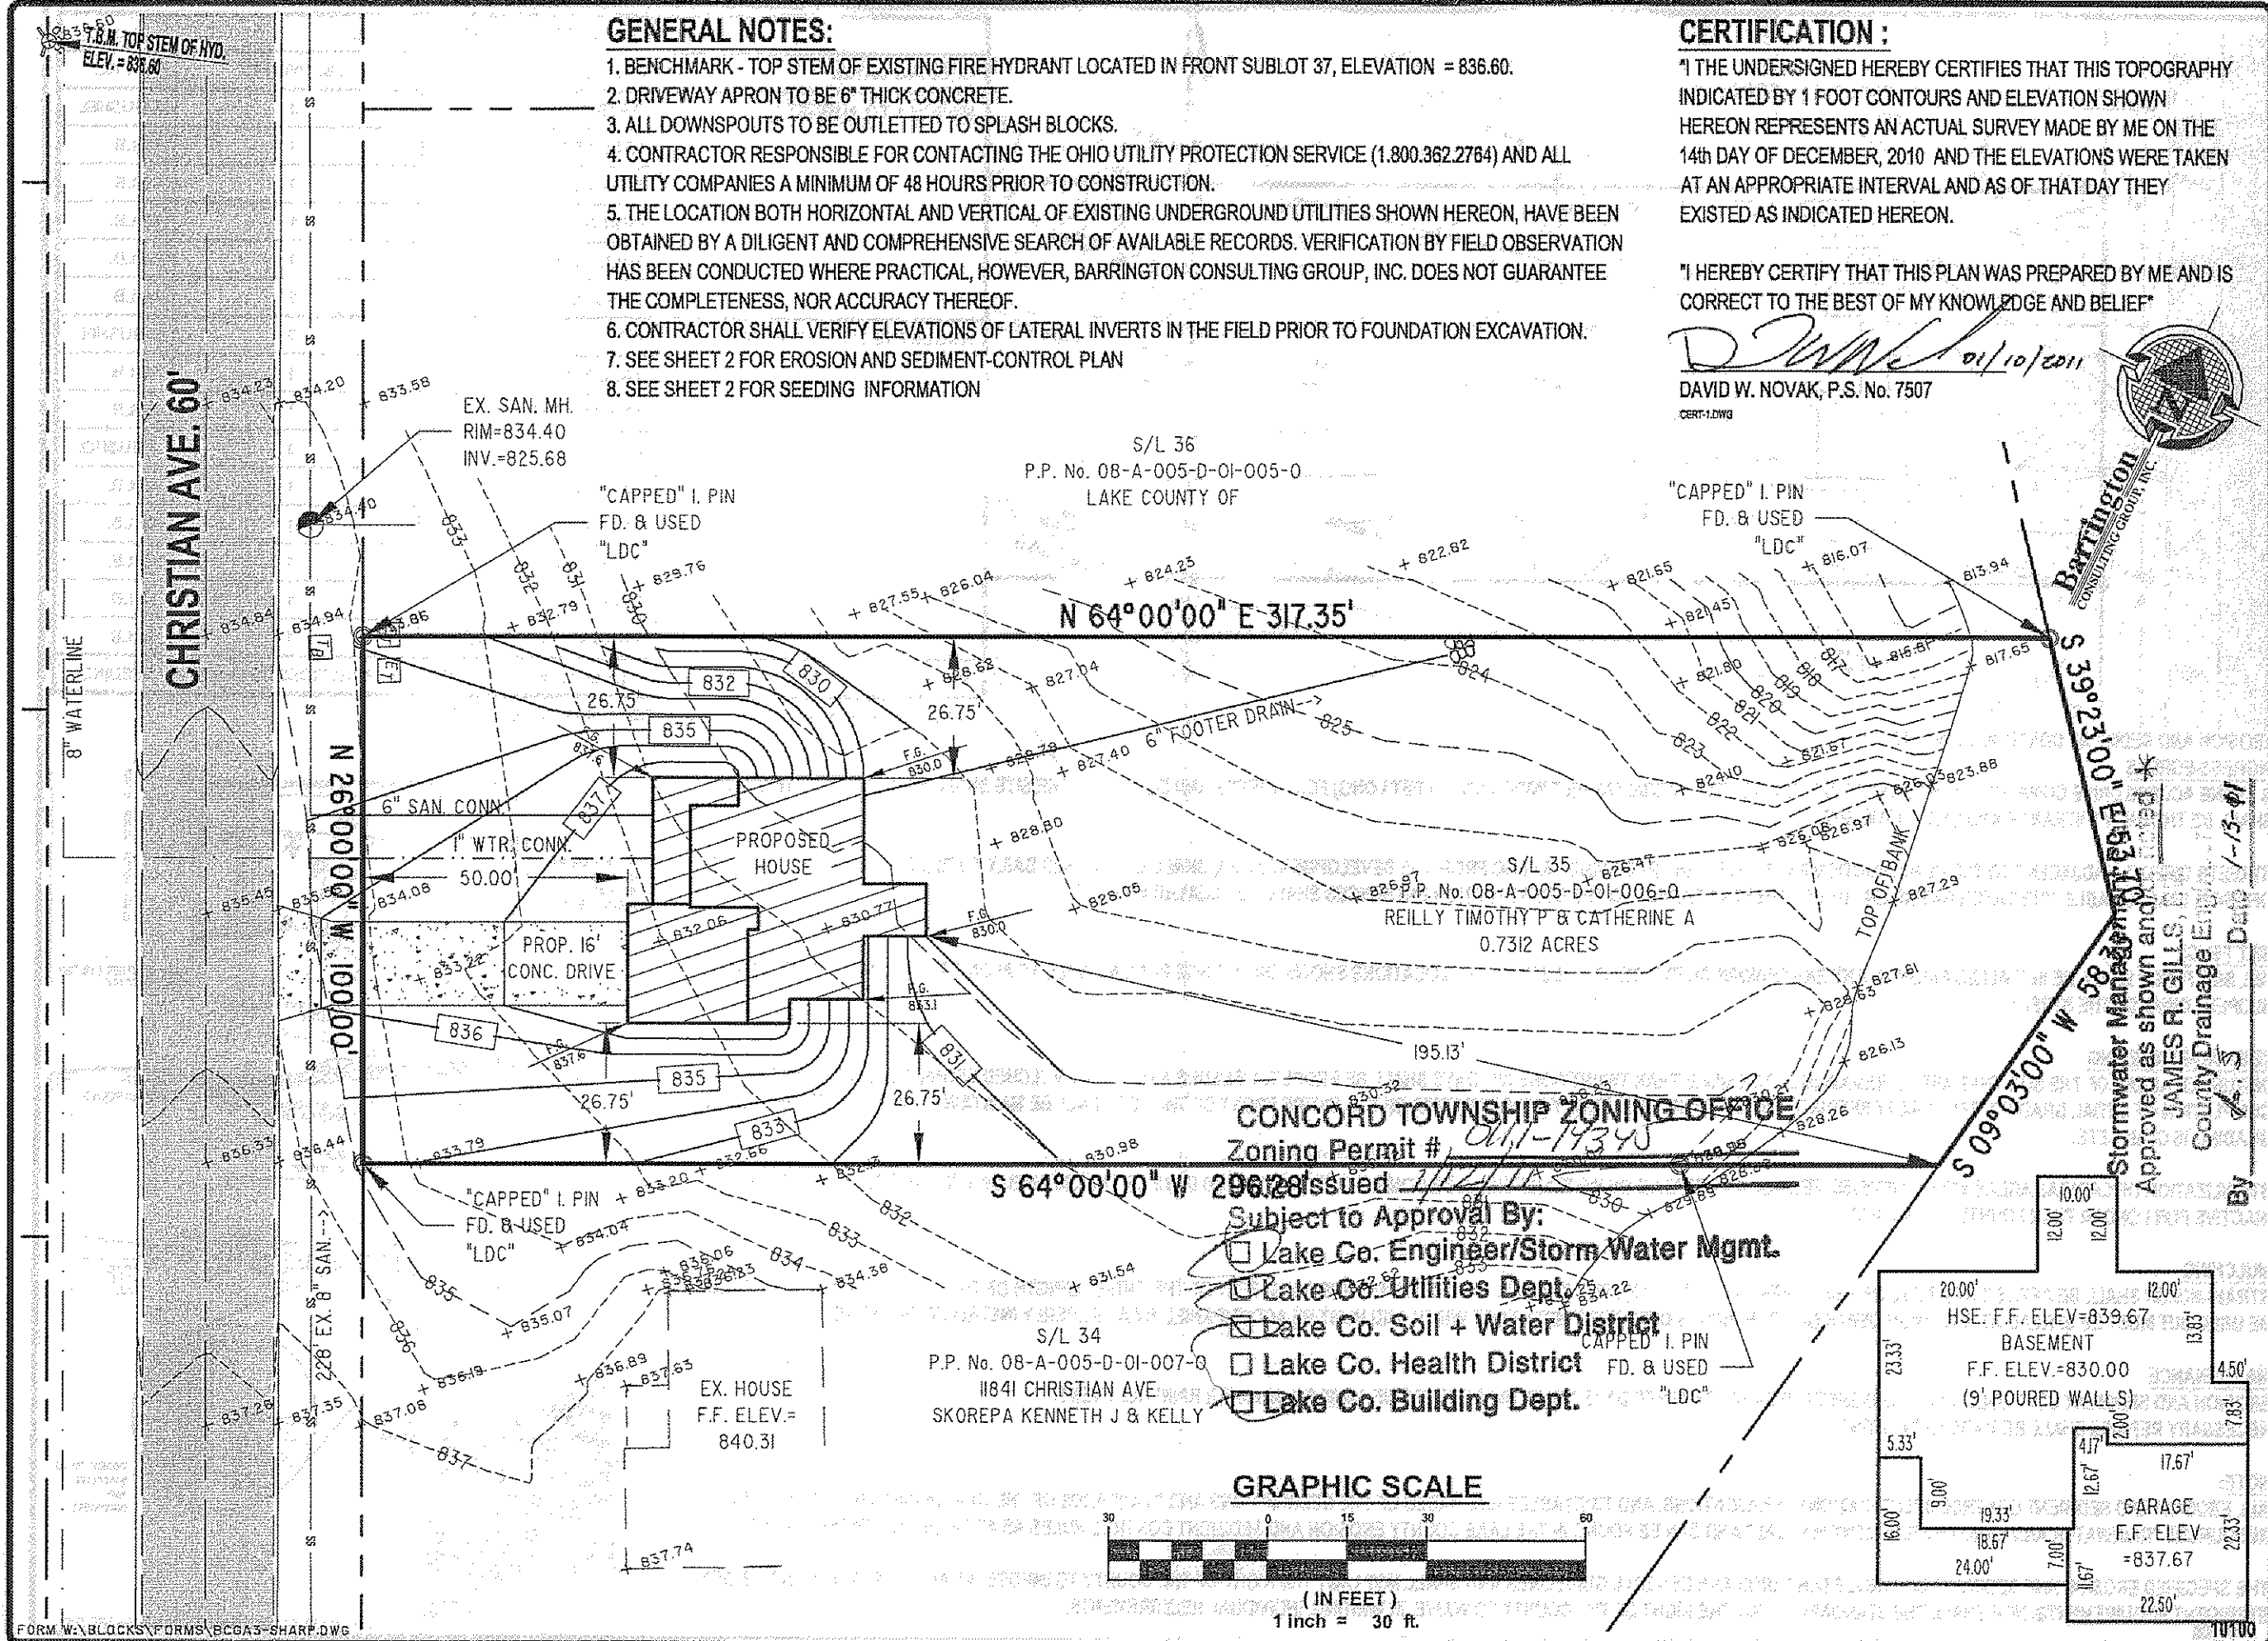

REVISIONS	BY

Barrington
CONSULTING GROUP, INC.
9114 TYLER BLVD., MENTOR, OHIO 44060
PHONE 440.285.1260 FAX 440.285.1262
www.BarringtonCGI.com

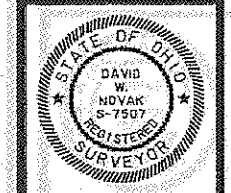

SITE PLAN
S/L 35 CHRISTIAN AVE., CONCORD TWP., OHIO 44077
FAR HILL ESTATES No. 2 VOL. 14 PG. 1
LITTLE MOUNTAIN HOMES, INC.

DRAWN WSO
CHECKED DWN
DATE JAN. 03, 2011
SCALE 1" = 30'
JOB NO. 10100
SHEET 1/2
OF SHEETS

* PROVIDE EROSION CONTROL AT FOOTER DRAIN DISCHARGE POINT