


S/L 2-2

ELEVATION LEGEND	
0.00	EXISTING ELEV.
0.00	PROPOSED ELEV.

CURVE DATA	
①	R = 30.00' A = 45.20' Δ = 82° 30' 25" T = 20.31' C = 39.56' S 4° 44' 48" W
②	R = 450.10' A = 78.87' Δ = 10° 30' 25" T = 37.55' C = 78.76' S 31° 15' 12" E

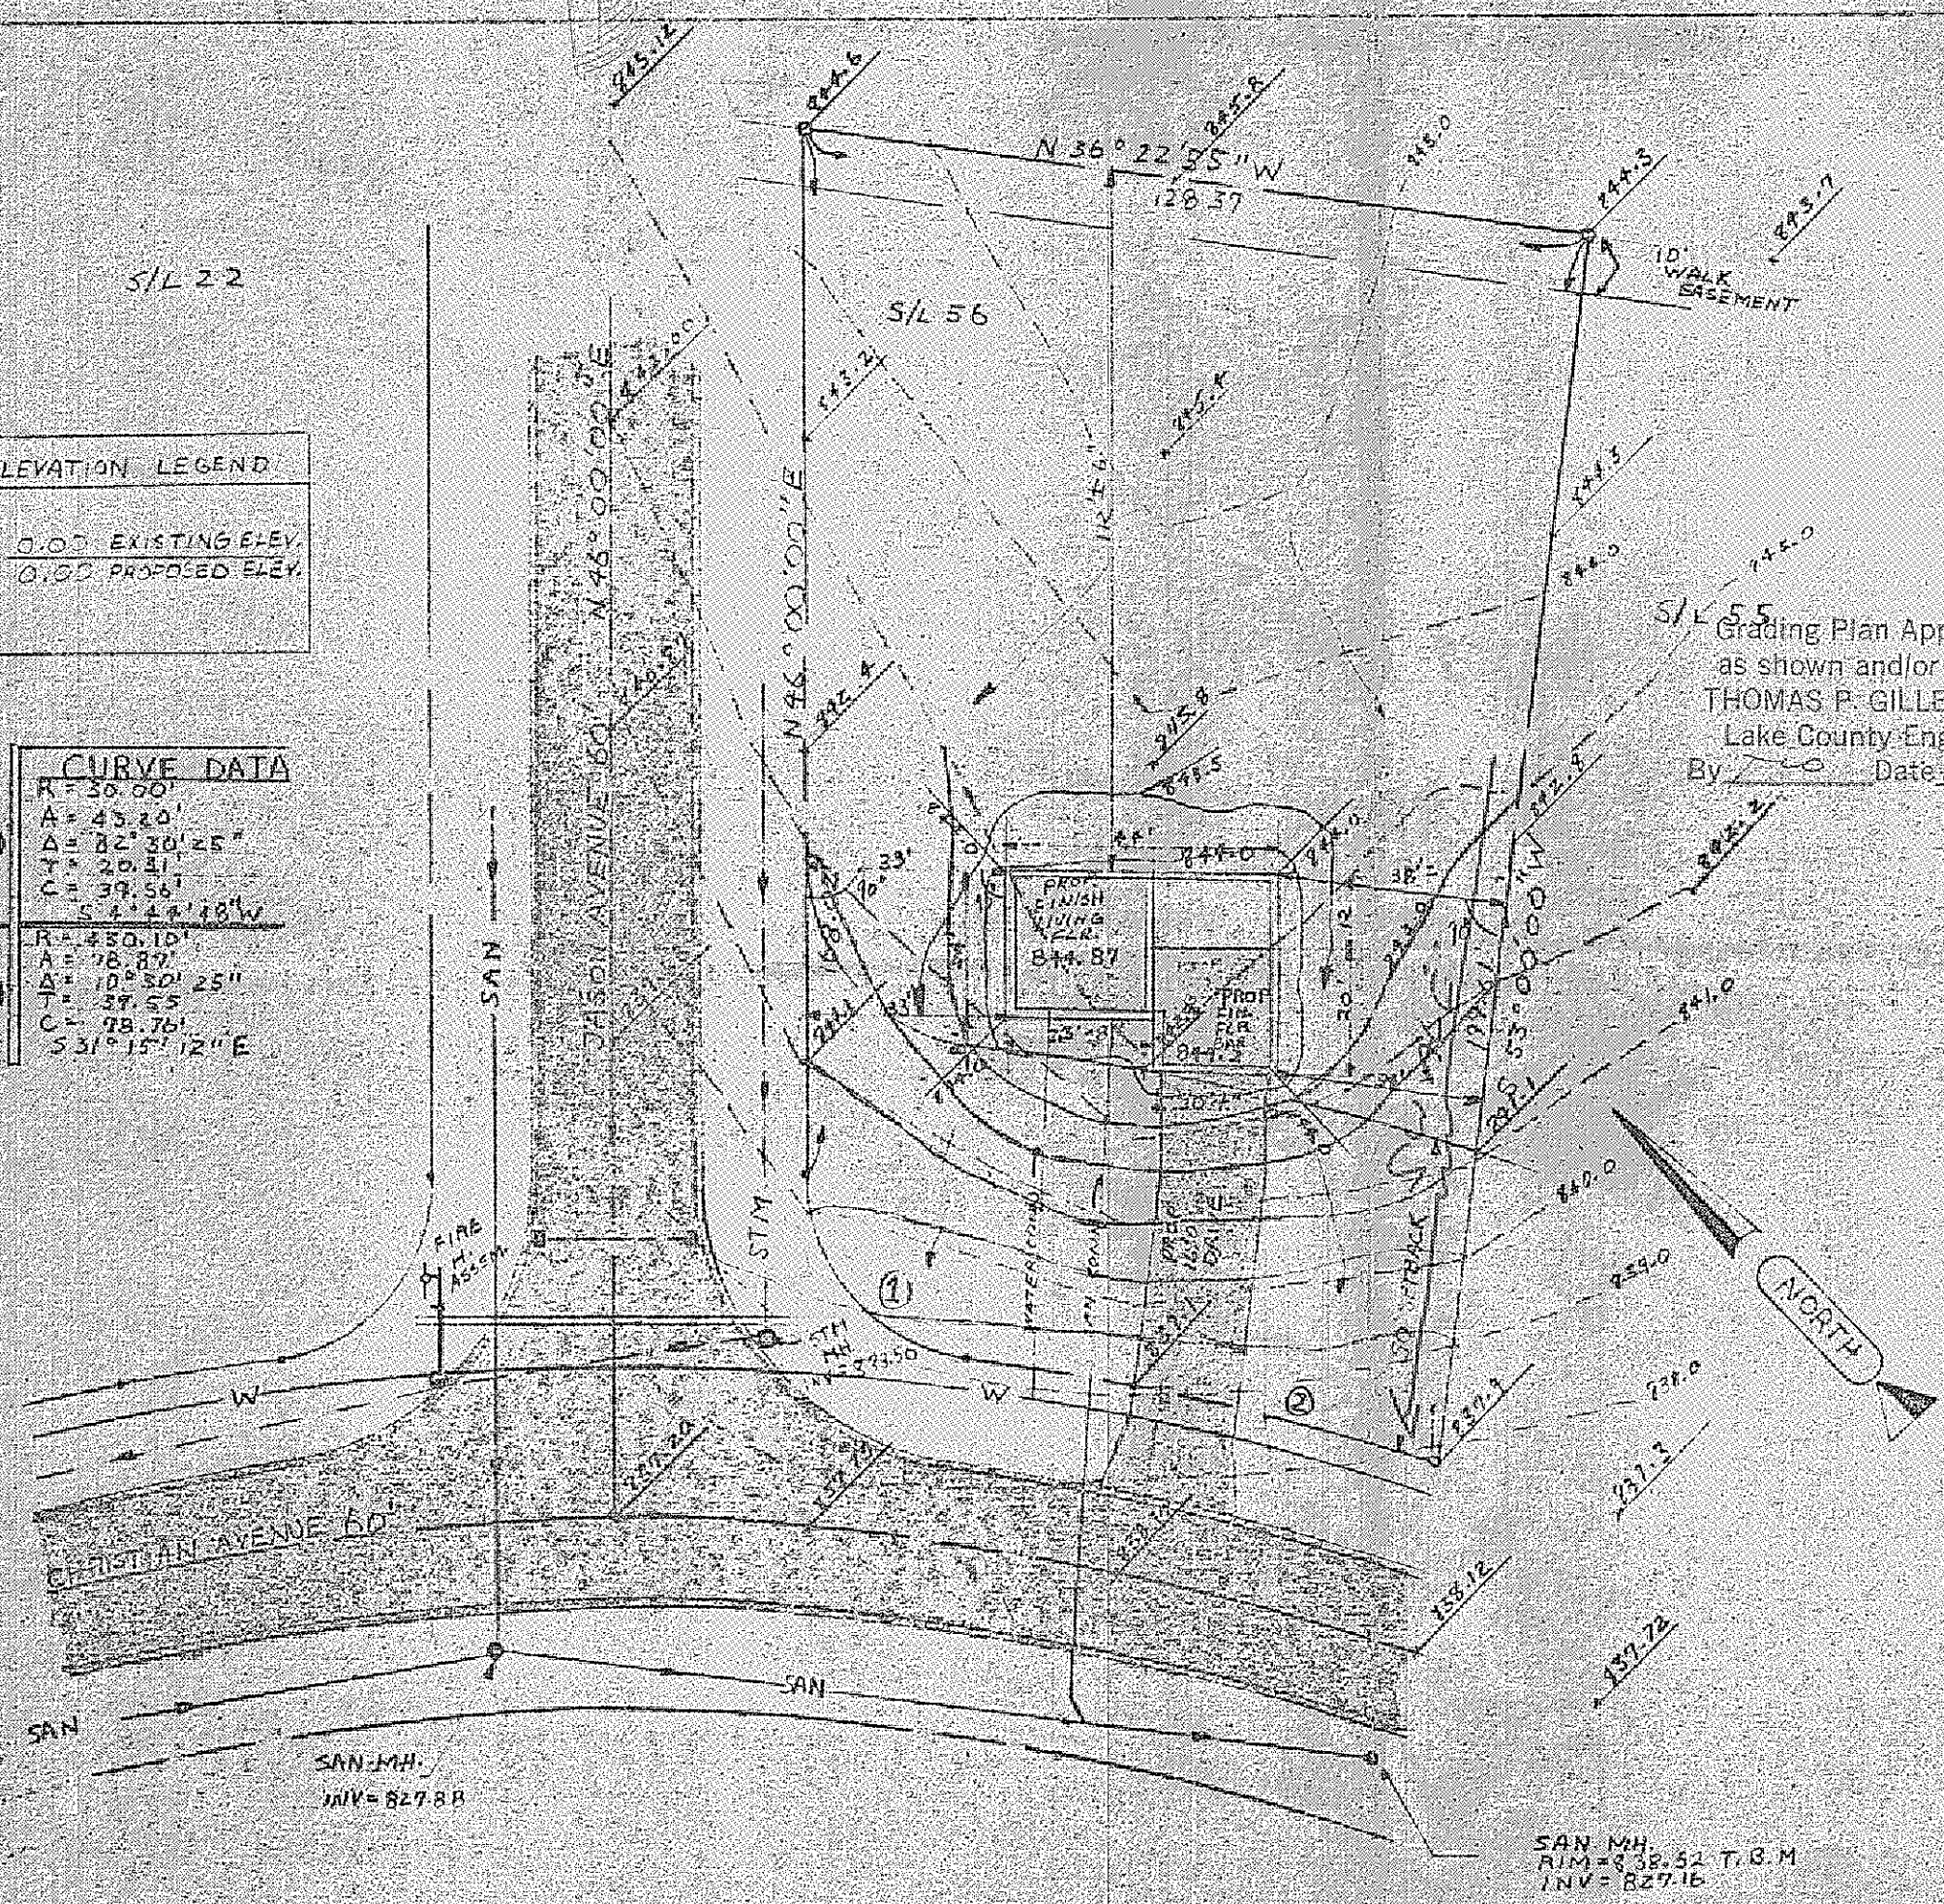

SITE PLAN FOR:
RYAN HOMES
814 TYLER BLVD
MENTOR, OHIO
BEING SUBLOT NO. 56
IN THE FAIR HILLS SUBDIVISION
LOCATED IN EDGECOD TWP.
LAKE COUNTY, OHIO

Grading Plan Approved
 as shown and/or noted
 THOMAS P. GILLES, P. E.
 Lake County Engineer
 By TCO Date ANOV77

S/L 56 CHRISTIAN AVE

PREPARED BY:
WM. A. GRAY ASSOC. INC.
4527 MENTOR AVE.
MENTOR, OHIO

SCALE: 1" = 30'
DATE: NOV. 2, 1977

CERTIFICATION:
 I HEREBY CERTIFY
 THAT THIS PLAN IS CORRECT
 TO THE BEST OF MY KNOW-
 LEDGE

BY: Wm. A. Gray
 WM. A. GRAY REG. SURV. #153

#3476

ZONING PERMIT

Approved: 12-7-77
 REGISTERED PROFESSIONAL SURVEYOR
Wm. A. Gray

SAN MH.
 RIM = 838.52 T.B.M.
 INV = 827.16