

RYAN HOMES
8141 TYLER BLVD
MENTOR, OHIO


BEING SUBLot 43 IN THE
FAR HILLS ESTATES SUBDIVISION
IN CONCORD TWP, OHIO

WM. GRAY ASSOC. INC.
7547 MENTOR AVE
MENTOR, OHIO
SCALE: 1"=30'
DATE: NOV. 21, 1977

I HEREBY CERTIFY THAT
THIS PLAT IS CORRECT TO THE
BEST OF MY KNOWLEDGE
BY: *Wm. R. Gray*

WM. R. GRAY REG. SURV. #2752

IF PROPOSED HOUSE HAS A ~~BASEMENT~~ FOOTER FLEV. LESS THAN 12" ABOVE E OF CHRISTIAN AVE
THAN FOOTER DRAIN CAN NOT BE TIED
INTO EXISTING SIM. SEWER

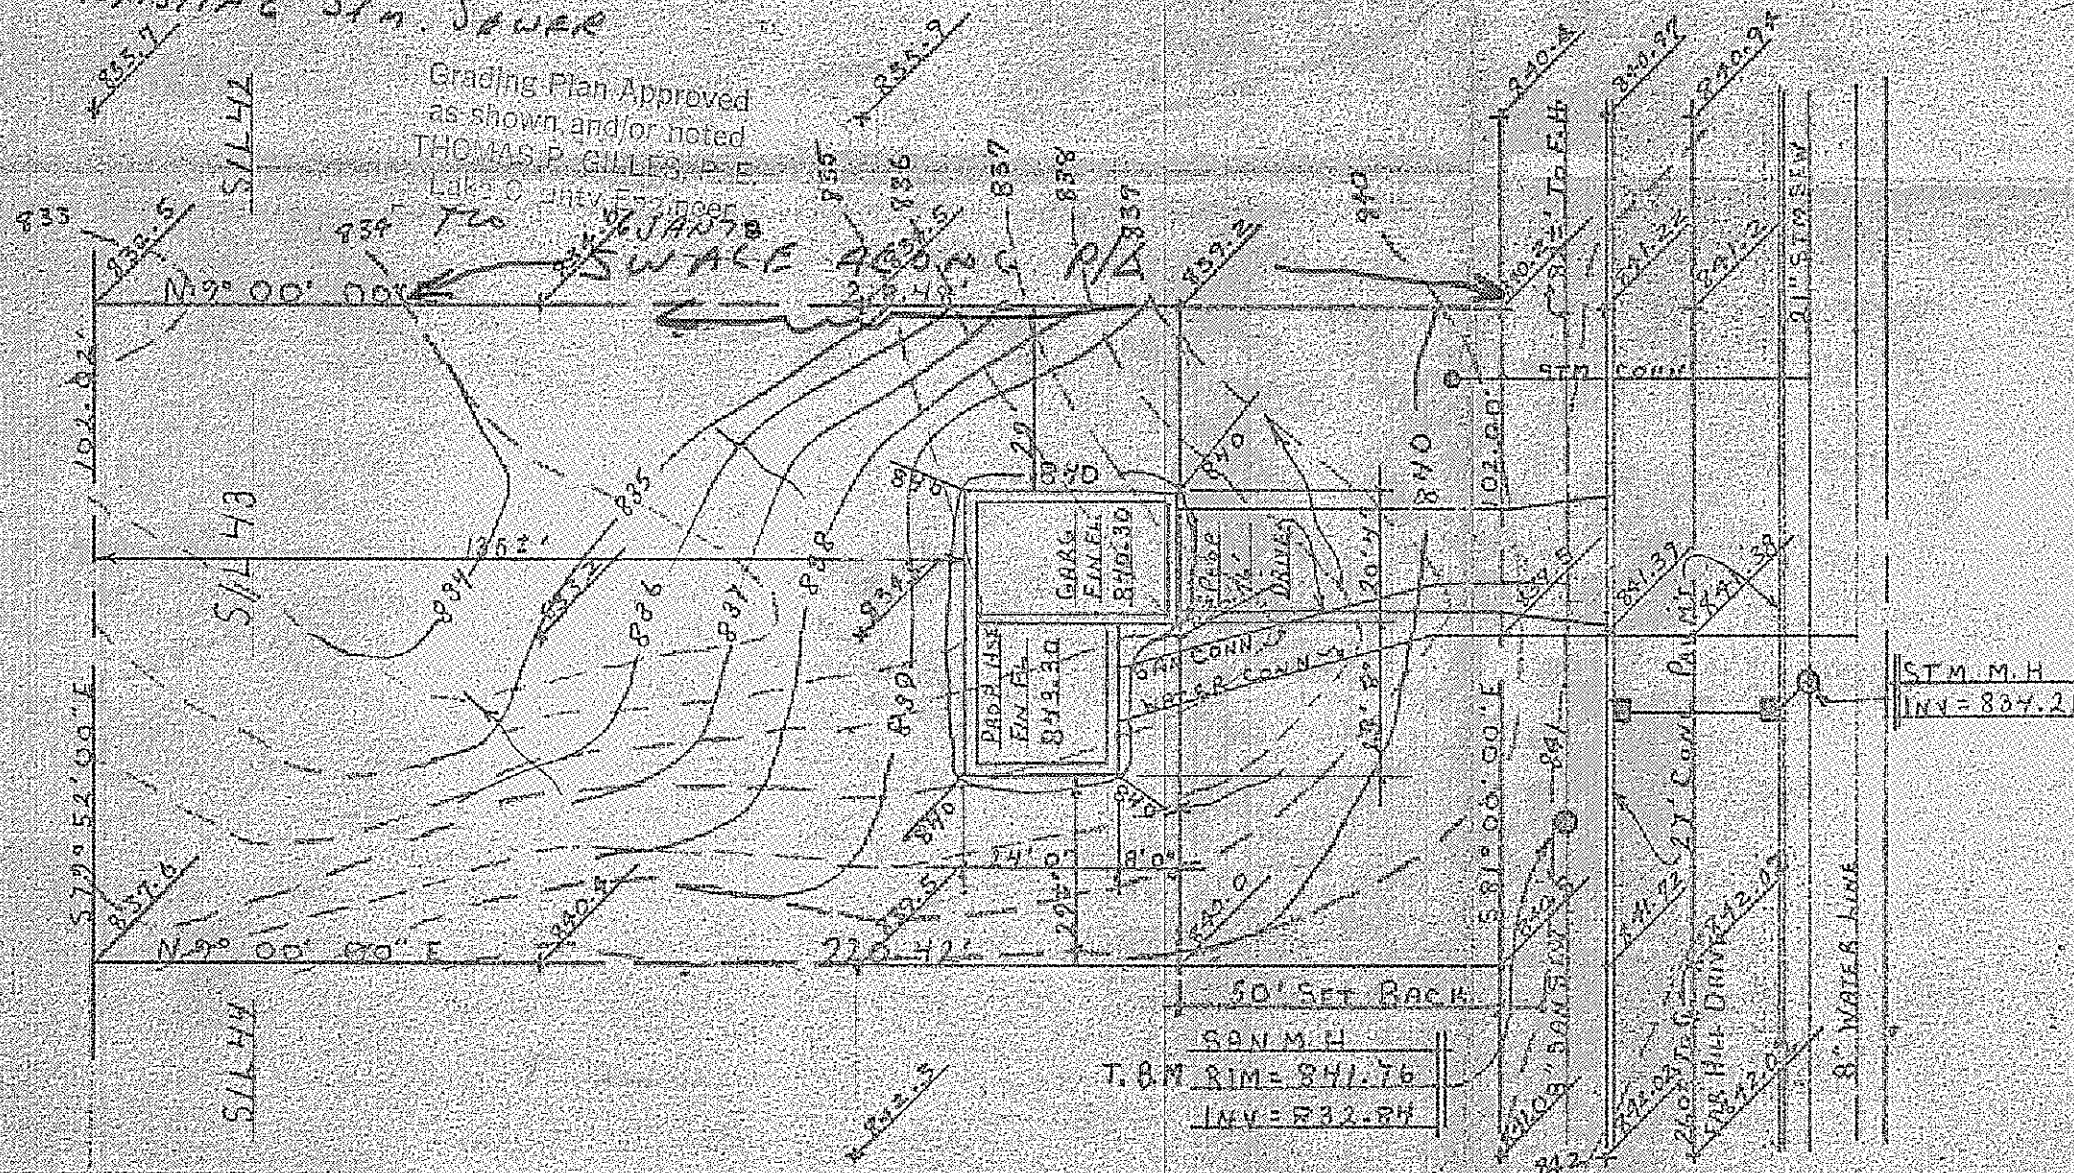

3500

ZONING

PERMIT

Approved 12-5-77

H. E. van Vriest

CHRISTIAN AVENUE 60'

* 0.00 EXIST. ELEV
0.00 PROP. ELEV