


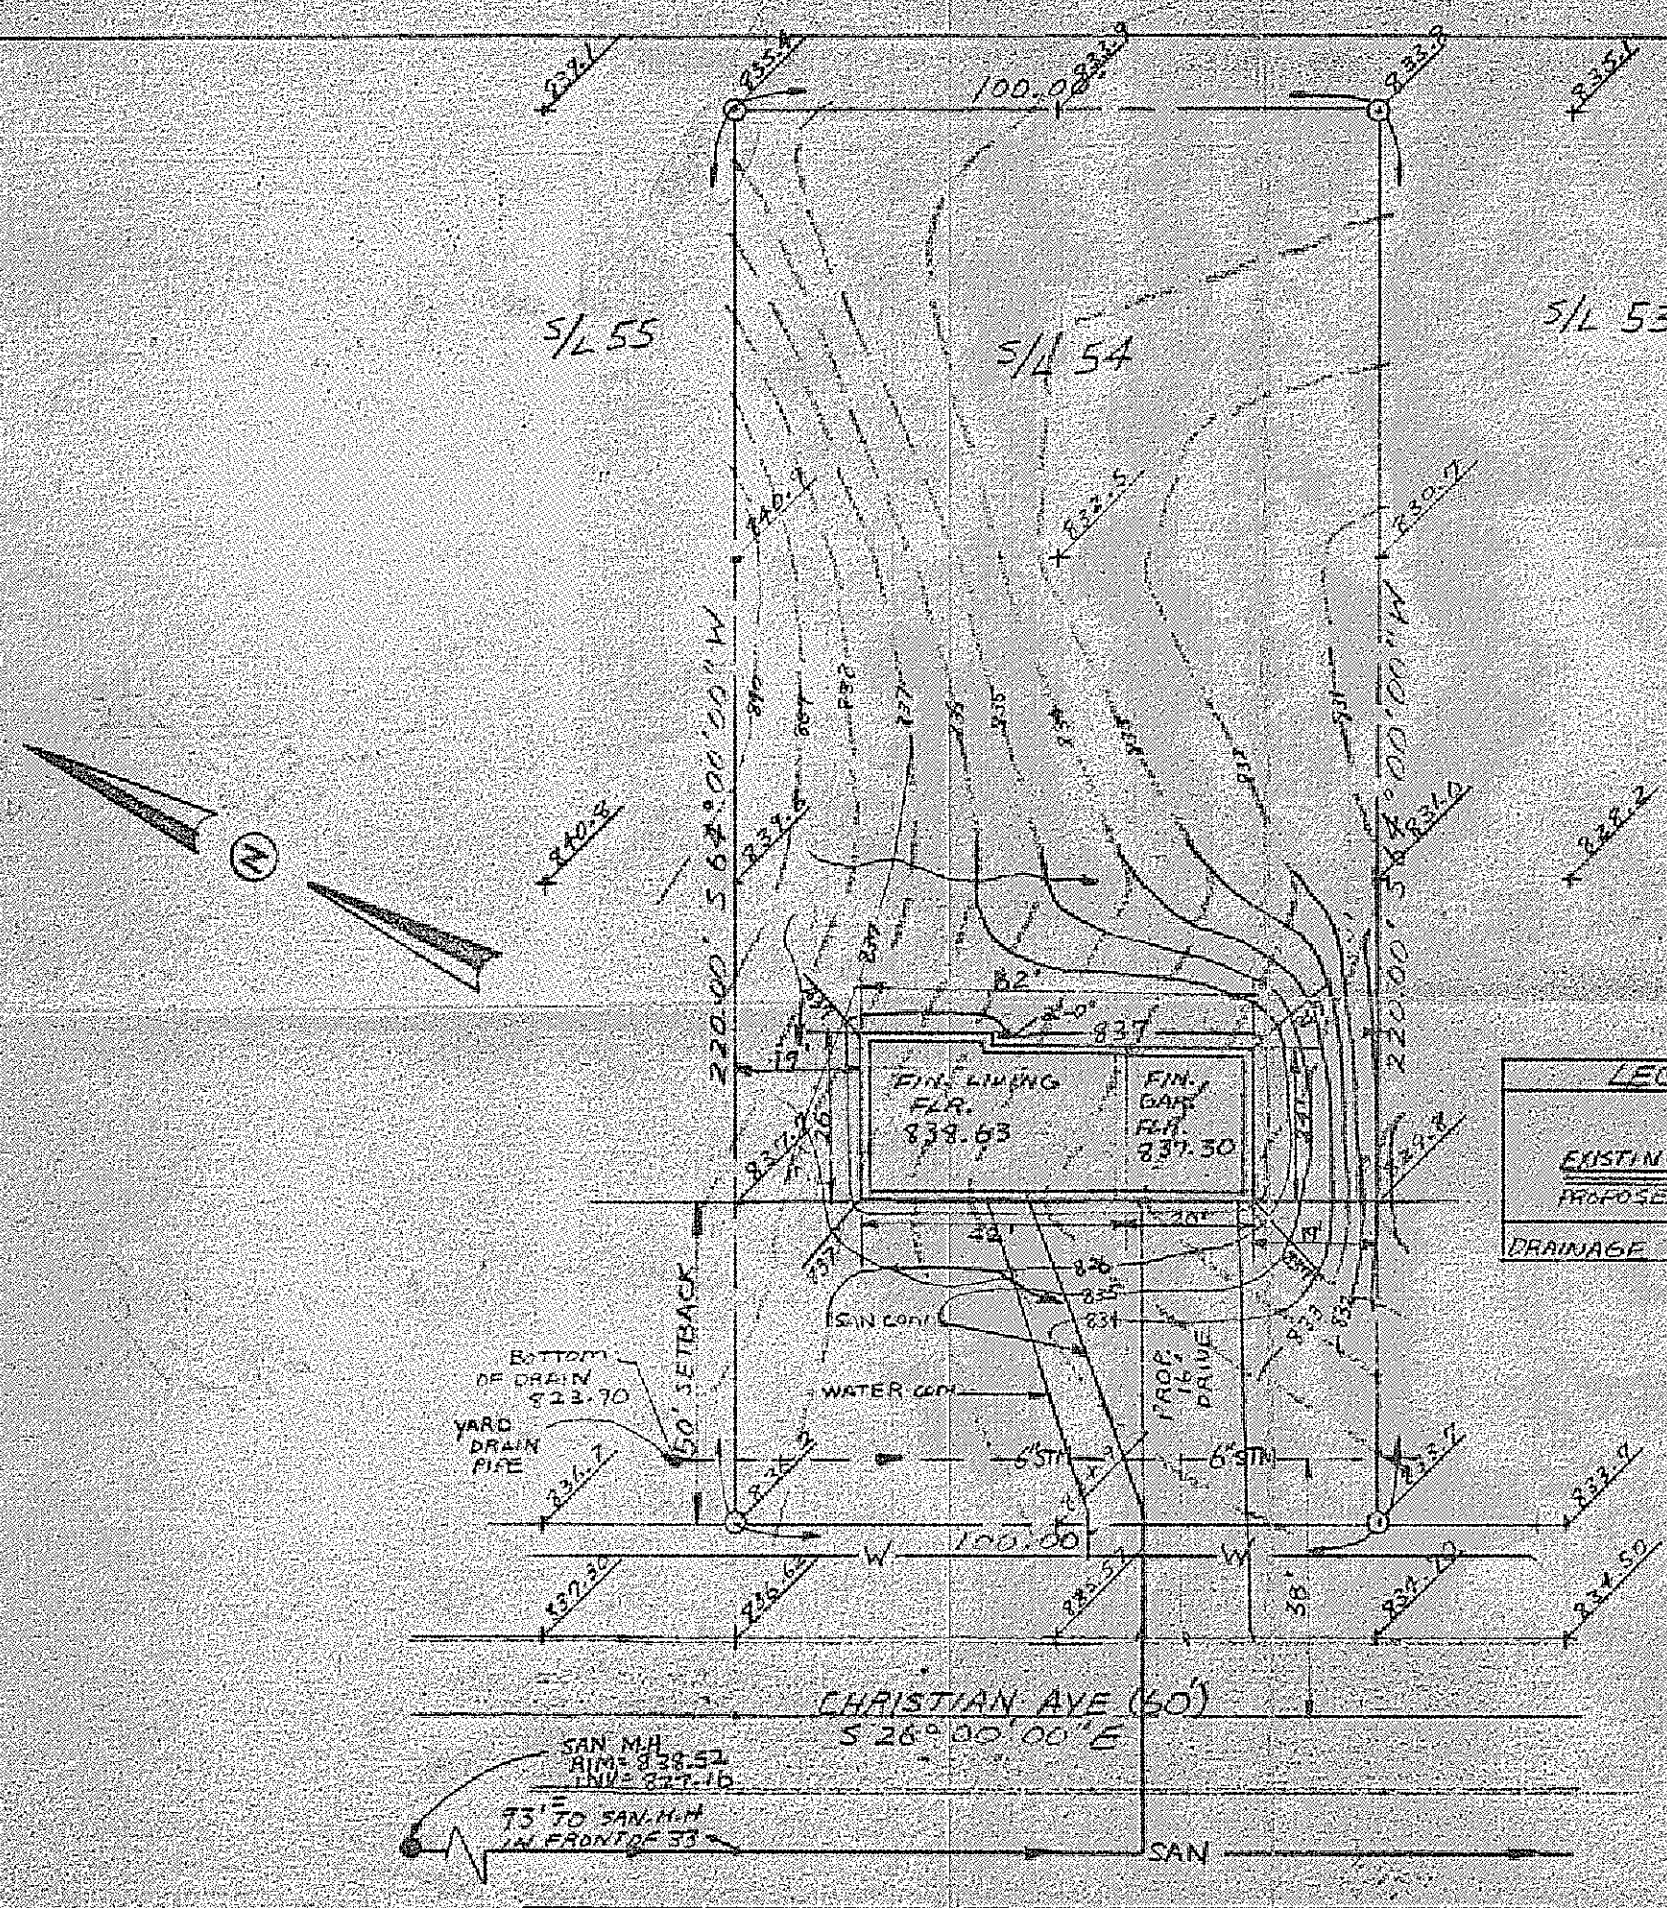

SITE PLAN FOR:

RYAN HOMES
 8141 TYLER BLVD.
 MENTOR, OHIO
 BEING SUBLOT NO. 54
 IN THE FAR HILLS SUBD. IN
 CONCORD, OHIO.
 Grading Plan Approved
 as shown and/or noted
 THOMAS P. GILLES, P.E.
 Lake County Engineer
 By T. W. R. Gray 17 APR 78

PREPARED BY:

WM. R. GRAY ASSOC. INC.
 1547 MENTOR AVE
 MENTOR, OHIO

SCALE: 1"=30'
 DATE: 4-5-78

LEGEND	
EXISTING	— 850 —
PROPOSED	— 850 —
DRAINAGE	— 850 —

CERTIFICATION:

I HEREBY CERTIFY
 THAT THIS PLAN IS
 CORRECT TO THE BEST
 OF MY KNOWLEDGE

3571 By: Wm. R. Gray
 WM. R. GRAY REG. ENGR. 2752

ZONING PERMIT
 ISSUED 4-11-78

SUBJECT TO APPROVAL BY:
 Lake County Sanitary Eng.
 Lake County Eng. Dept.
 Lake County Planning Comm.
 Lake County Bldg. Dept.



Wm. R. Gray

FB 84-39
 DATE 3-29-78