
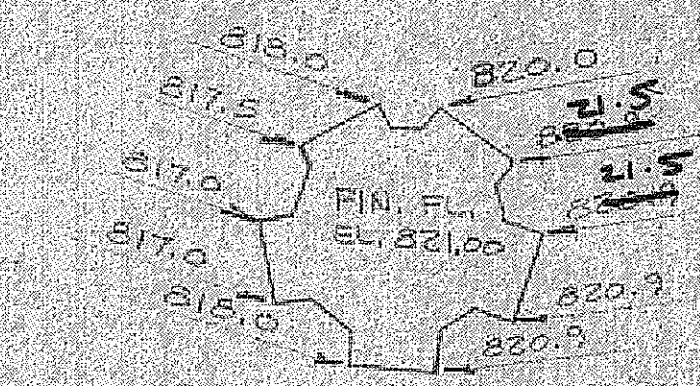


CURVE DATA

R=20.00'
 A=50.52'
 Δ=57°01'41"
 T=32.66'
 CH=57.38'
 L=25°33'51" E

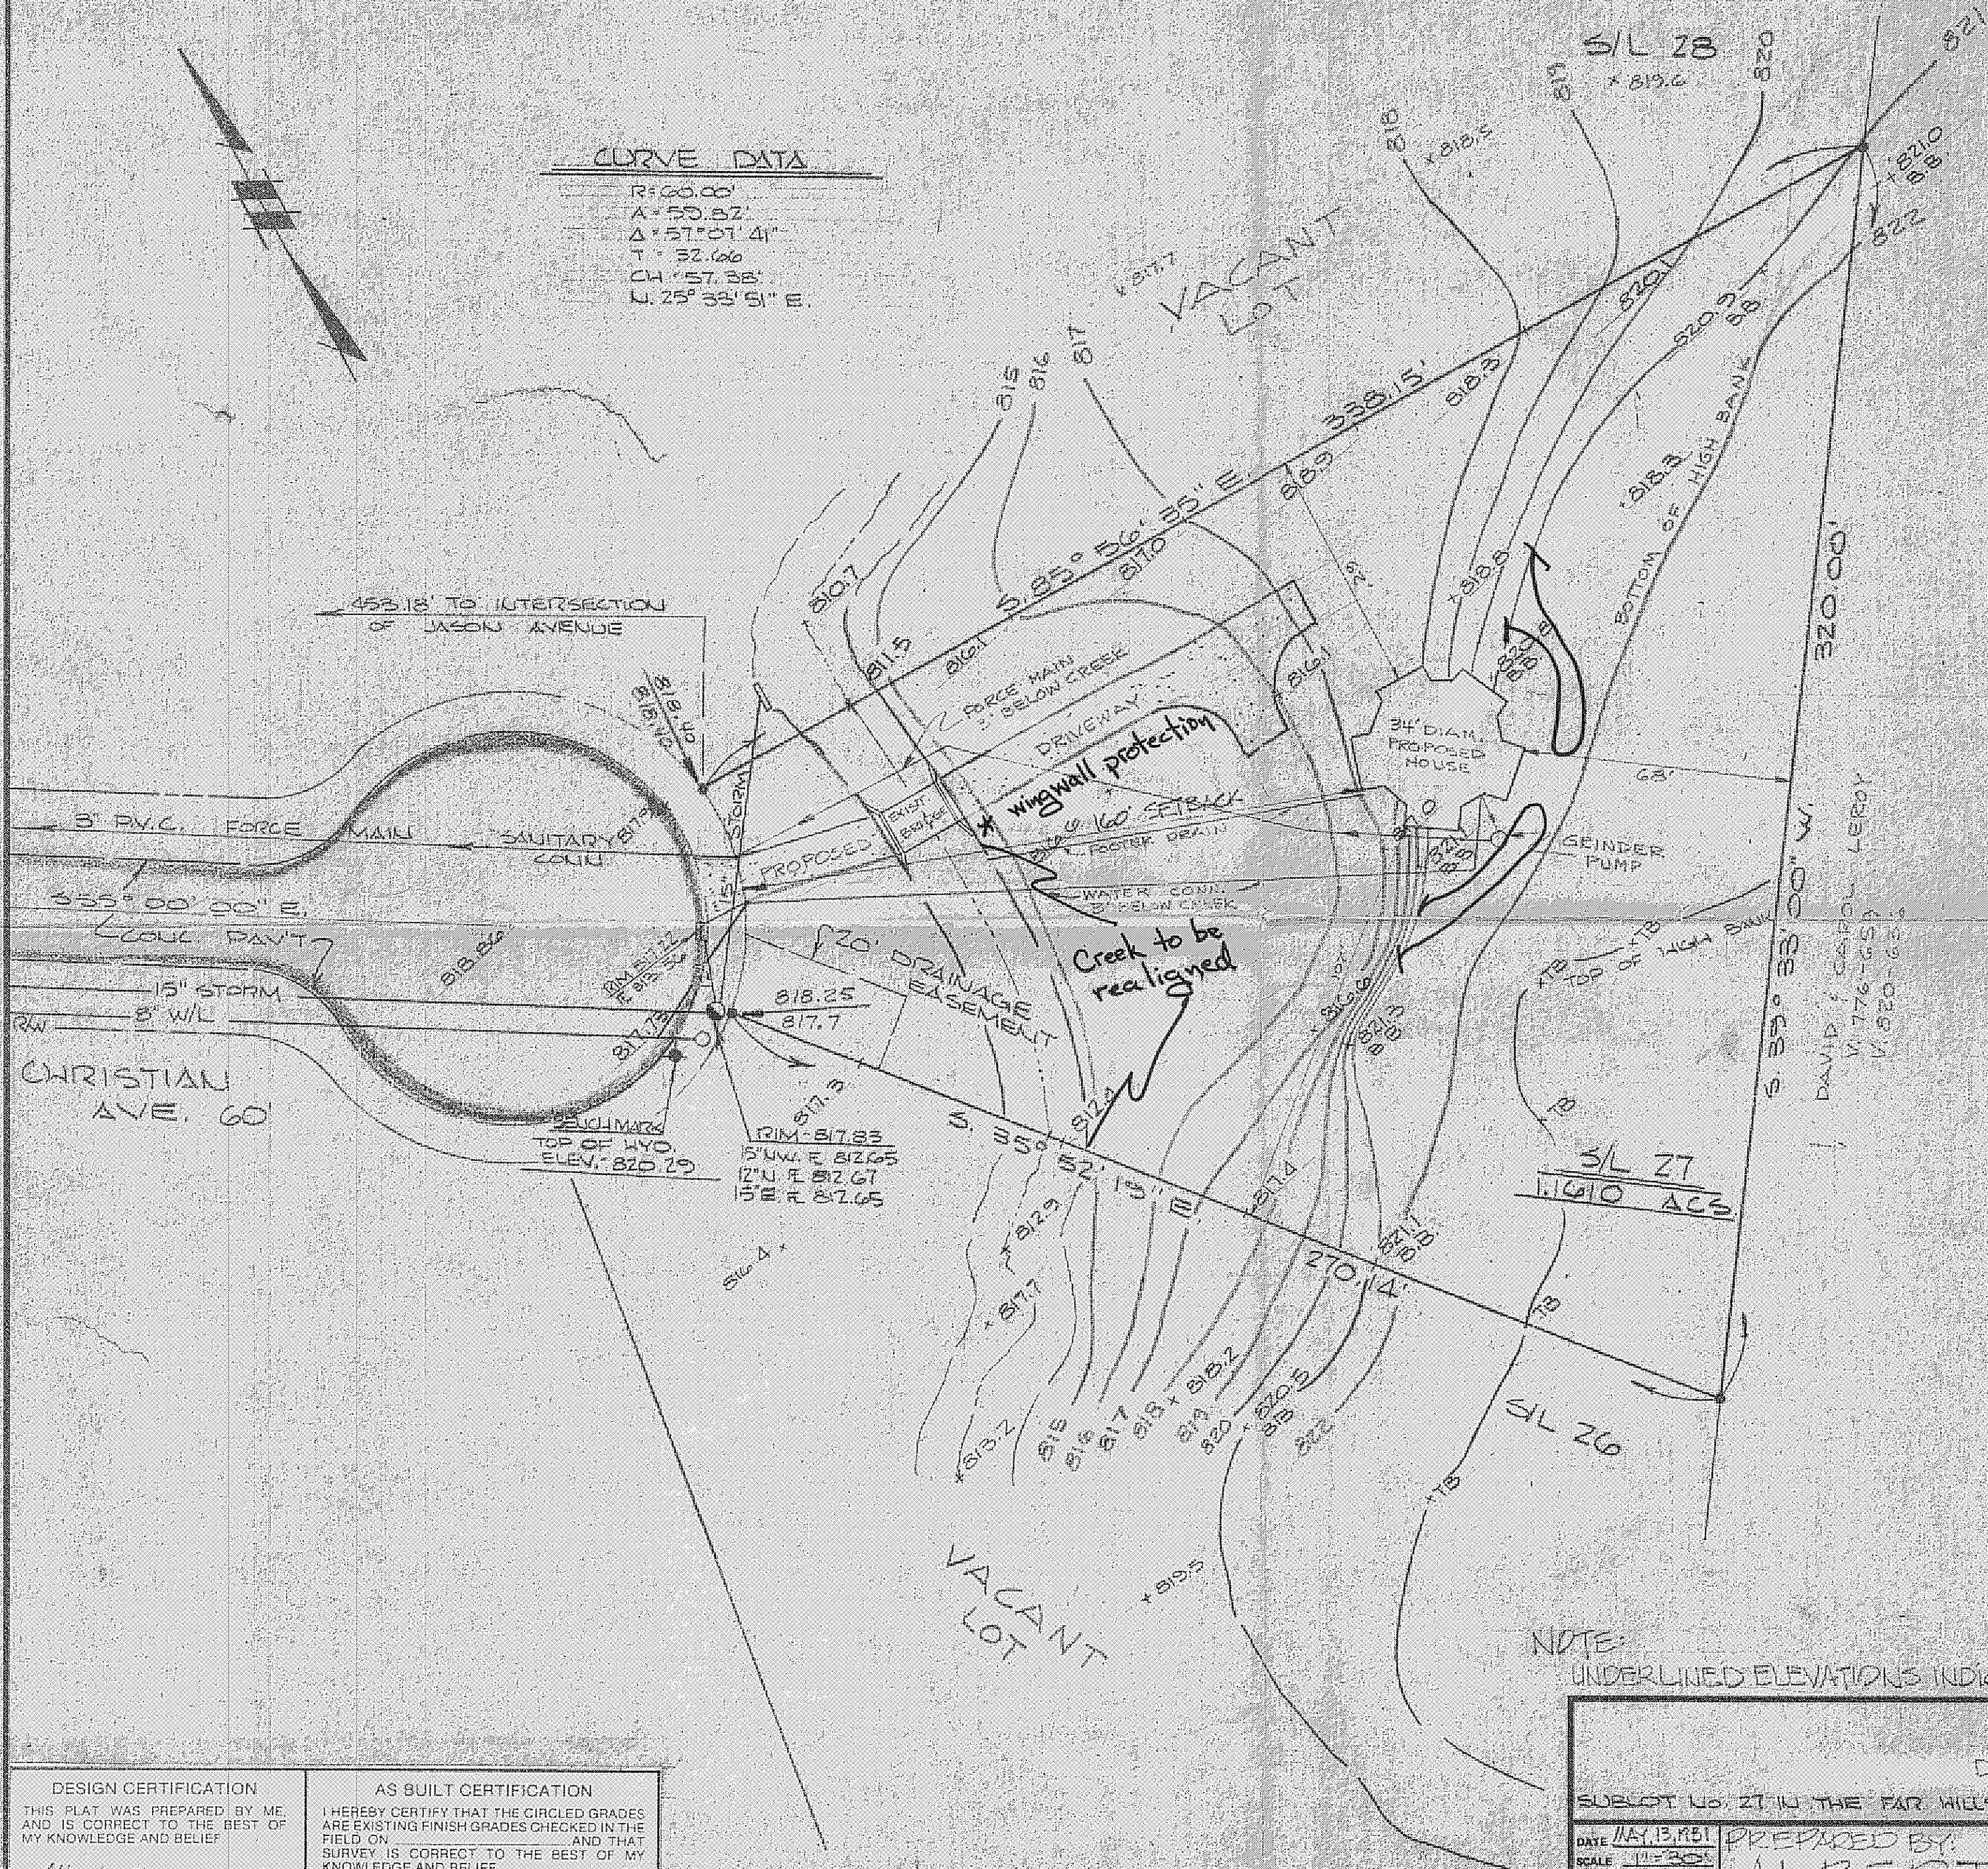

PROPOSED GRADING
 AROUND HOUSE

Grading Plan Approved
 as shown and/or noted
 THOMAS P. GILLES, P.E.
 Lake County Engineer
 By TMC Date 5-22-81

ZONING PERMIT #4334
 ISSUED 5-18-81
 SUBJECT TO APPROVAL BY:
 Lake County Sanitary Eng. ☐
 Lake County Eng. Dept. ☒
 Lake County Planning Comm. ☐
 Lake County Bldg. Dept. ☒
Tom J. Marano

NOTE:
 UNDERLINED ELEVATIONS INDICATES PROPOSED GRADES.

SITE PLAN
 FOR
 DALE EVANS

SUBLOT NO. 27 IN THE FAR WILLS ESTATES NO. 2, CONCORD TWP. LAKE CO. O.

DATE MAY 13, 1981 PREPARED BY:
 SCALE 1"=30' ALBERT SAARI, P.E.
 DRAWN BY _____
 CHK'D BY _____
 F.B. _____ P.G. _____

DESIGN CERTIFICATION
 THIS PLAN WAS PREPARED BY ME,
 AND IS CORRECT TO THE BEST OF
 MY KNOWLEDGE AND BELIEF
Albert J. Saari, P.E.
 ENGINEER
 REG. SURVEYOR NO. 11278

AS BUILT CERTIFICATION
 I HEREBY CERTIFY THAT THE CIRCLED GRADES
 ARE EXISTING FINISH GRADES CHECKED IN THE
 FIELD ON _____ AND THAT
 SURVEY IS CORRECT TO THE BEST OF MY
 KNOWLEDGE AND BELIEF
 REG. SURVEYOR NO. _____