

SITE PLAN FOR:

RYAN HOMES
23,600 MERCHANTILE ROAD
BEACHWOOD, OHIO.


BEING SUBLOT NO. 3 IN REVERE WOODS
SUB. NO. 2 IN CONCORD TOWNSHIP, OHIO

PREPARED BY:

WM. R. GRAY ASSOC., INC.
ENGINEERS & SURVEYORS
7547 MENTOR AVENUE
MENTOR, OHIO

DATE: OCTOBER 31, 1973 SCALE: 1"=20'
REV'D: FEBRUARY 21, 1974

NORTH

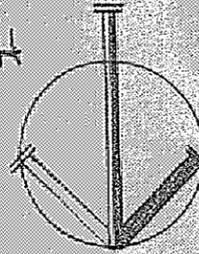

CERTIFICATION:

I HEREBY CERTIFY THAT THIS PLAN IS
CORRECT TO THE BEST OF MY KNOWLEDGE.

By: *Wm. R. Gray*

WM. R. GRAY, REG. SURV. # 2752

Site Plan Approved
shown and/or noted
THOMAS P. GILLES, P.E.
Lake County Engineer


By: *JWK*

Revised from 11-2-73
Date: 3-1-74

SL 4



COLERIDGE ROAD 60'

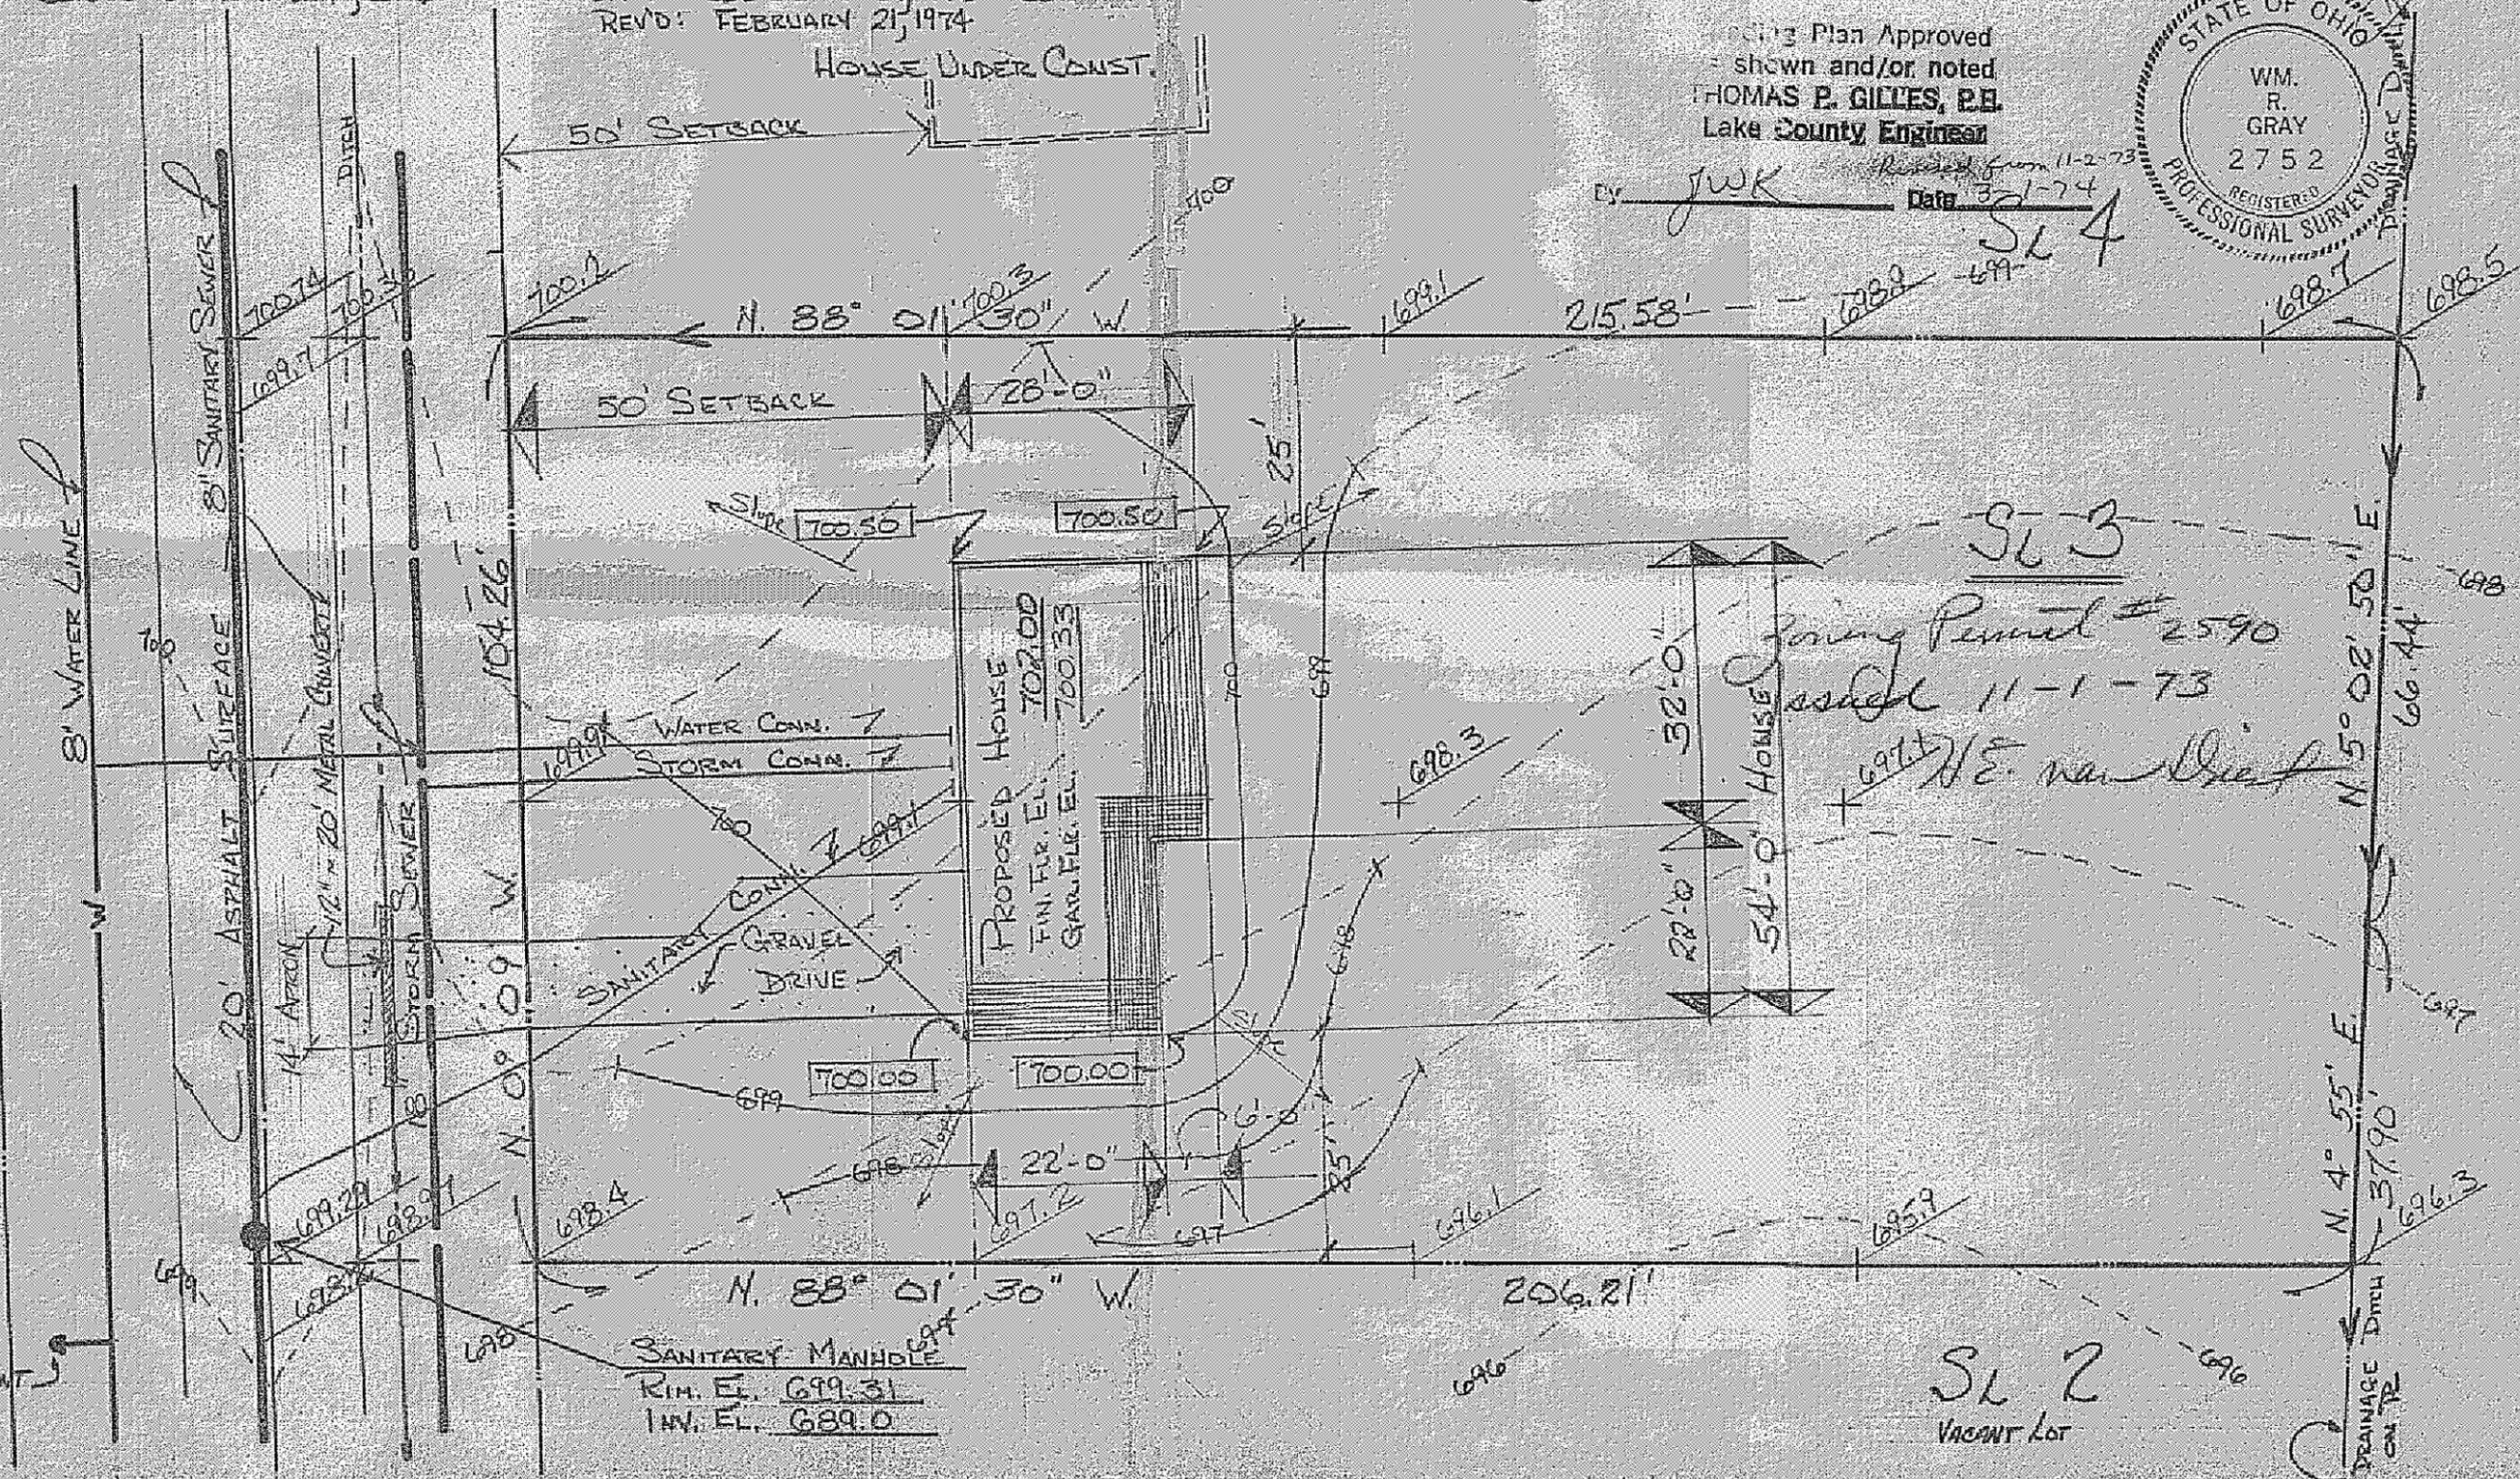

HOUSE UNDER CONST.

50' SETBACK

50' SETBACK

PROPOSED HOUSE
FIN. FLOOR EL. 702.00
GRAVEL FLOOR EL. 700.33

SANITARY MANHOLE
RIM. EL. 699.31
INV. EL. 689.0

SL 3
Firing Permit # 2590
issued 11-1-73
N.E. van Diep

SL 2
VACANT LOT

FIRE HYDRANT

DRAINAGE DITCH
ON THE