

SITE PLAN FOR:

RYAN HOMES

23600 MERCANTILE RD.

BEACHWOOD, OHIO

BEING SUBLT NO 7 IN THE

REVERE WOODS SUBDIVISION

NO. 2 IN CONCORD TWP., OHIO.

PREPARED BY:

WM. R. GRAY ASSOC. INC.

7547 MENTOR AVE.

MENTOR, OHIO

DATE: MAY 6, 1979 SCALE: 1"=30'



ENGINEERS

SURVEYORS

CERTIFICATION

I HEREBY CERTIFY THAT THIS PLAT
IS CORRECT TO THE BEST OF MY
KNOWLEDGE.

By: Wm. R. Gray REG. SURVEY
#2752

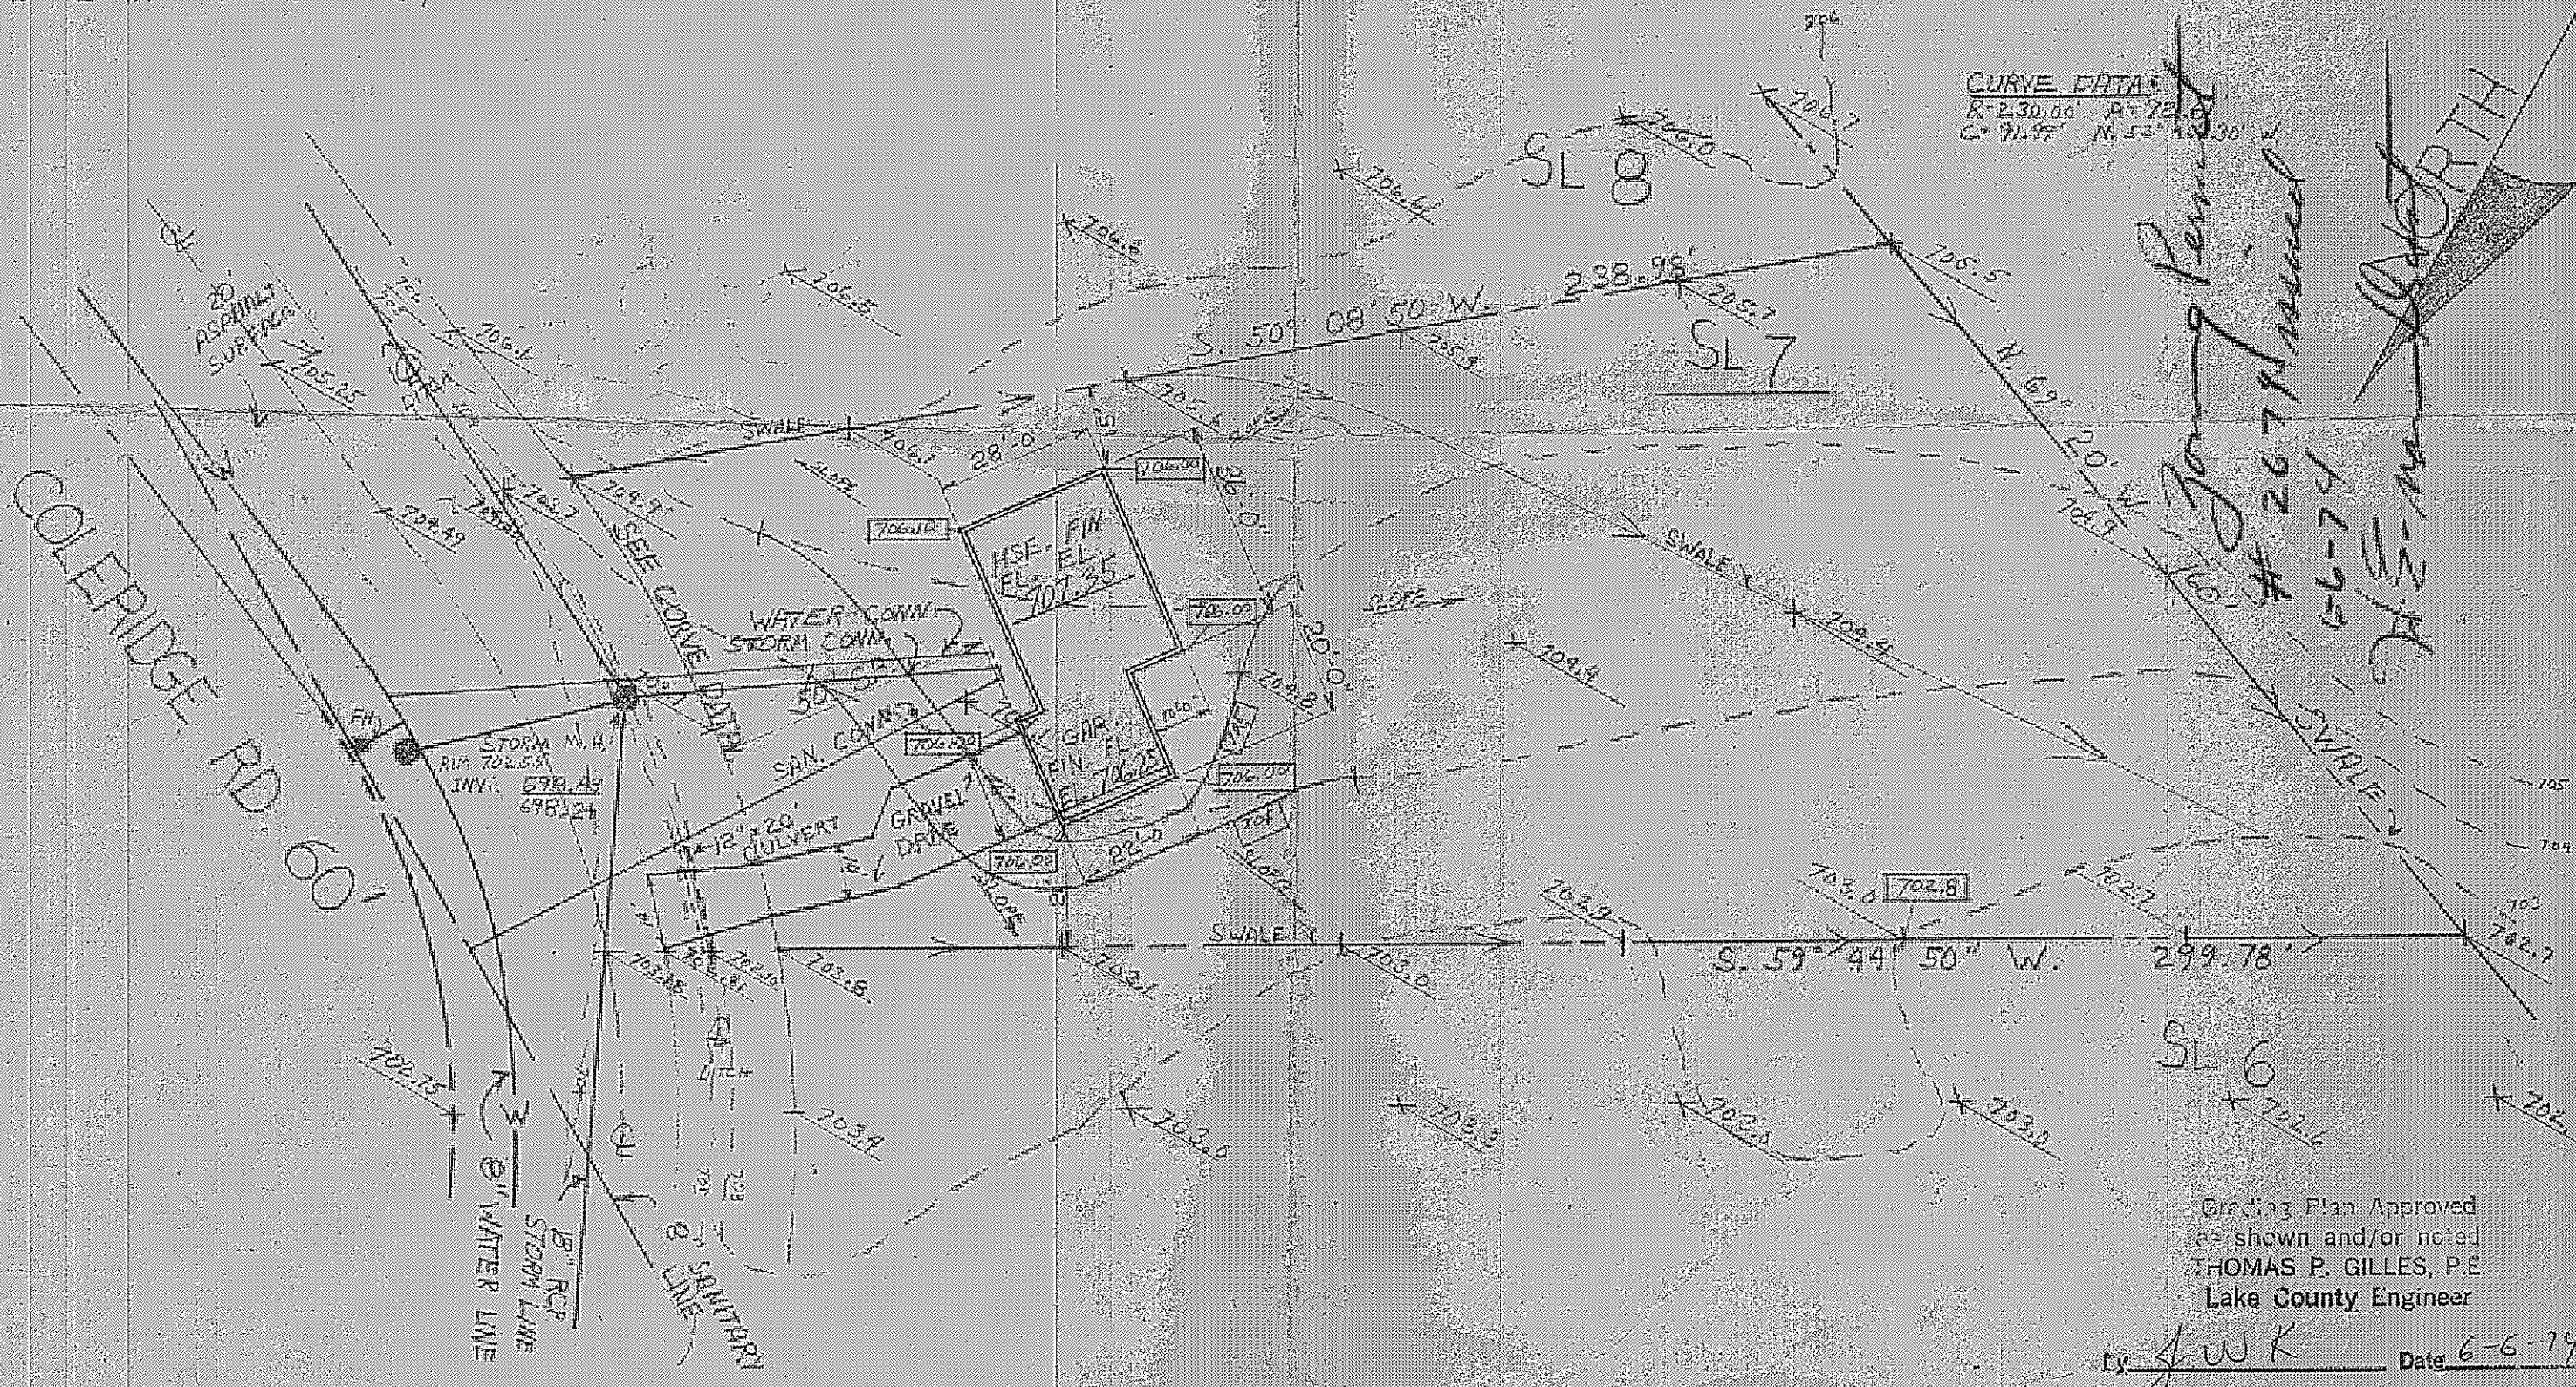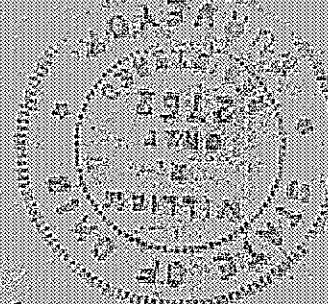

CURVE DATA:
R=230.00' P=72.0'
C=91.97' N=53°10'30\"/>

*Young Permit
#2671 issued
6-6-79
H.E. M. NORTH*

Grading Plan Approved
as shown and/or noted
THOMAS P. GILLES, P.E.
Lake County Engineer

By: JWK Date: 6-6-79