


DELCO HOMES INC.
VOL. 768 PG. 703

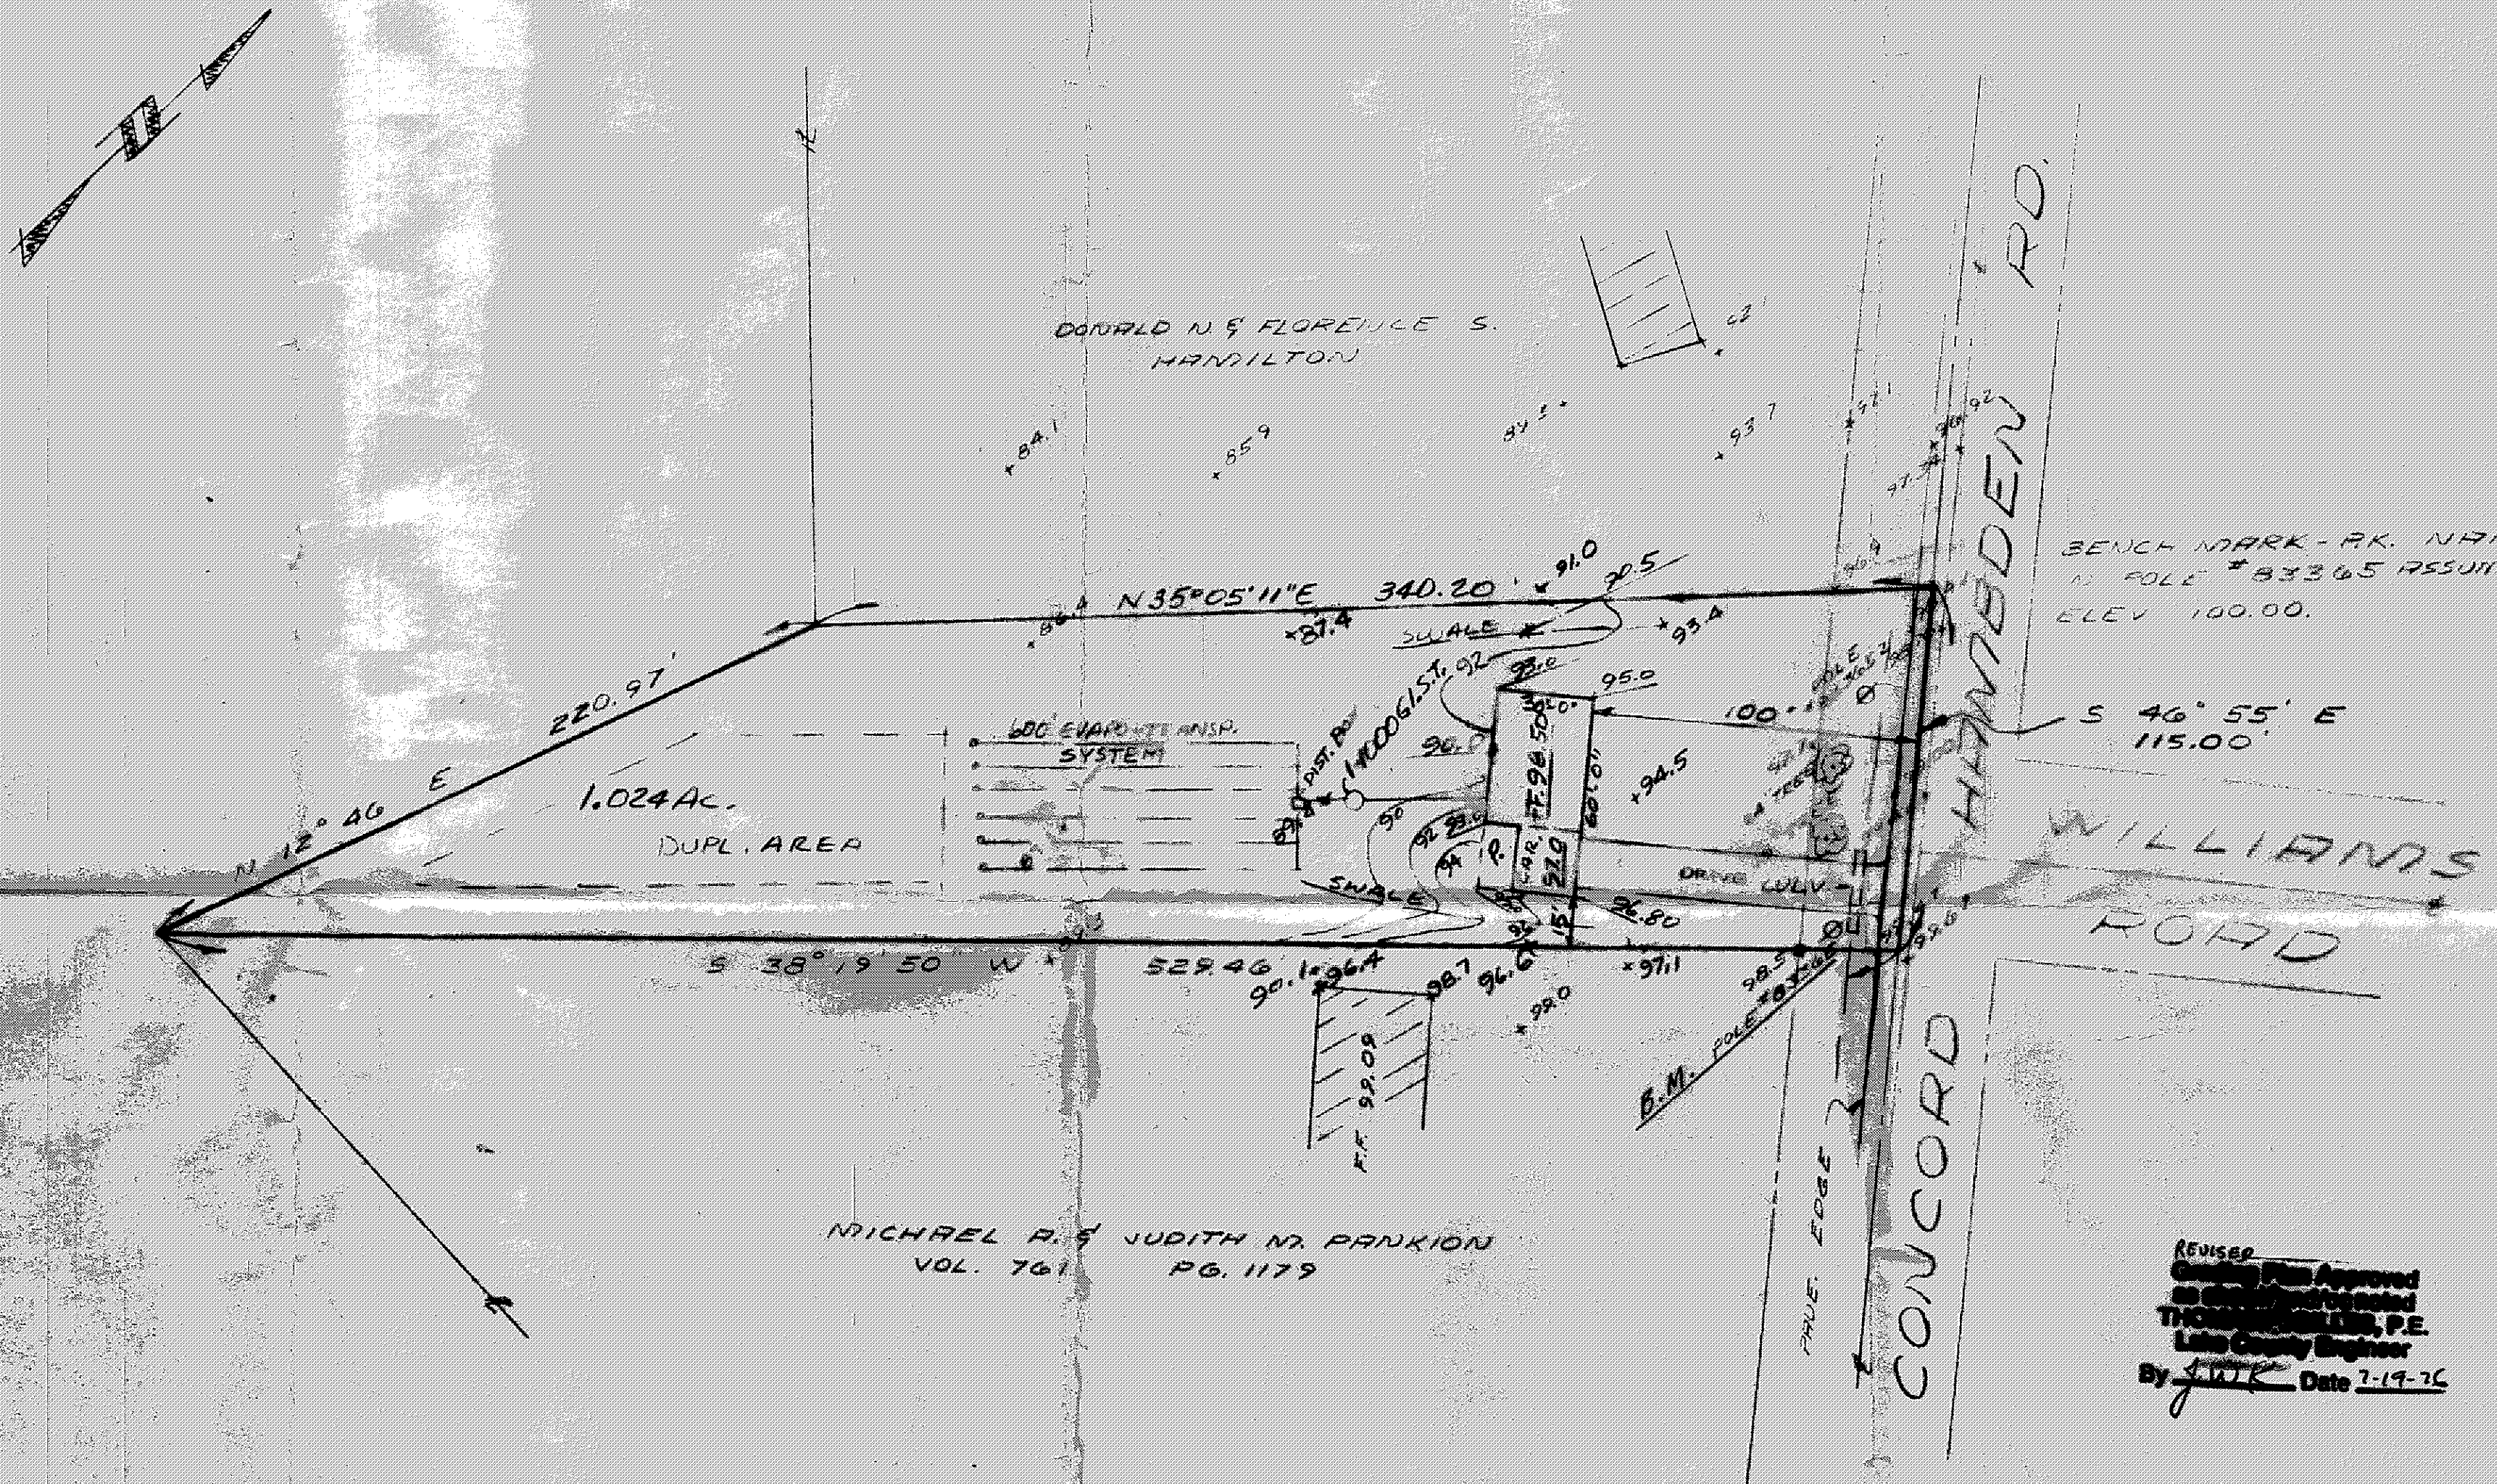

MICHAEL R. & JUDITH M. PANKION
VOL. 761 PG. 1179

REVISOR
Grading Plan Approved
as shown and noted
THOMAS J. HALL, P.E.
Lake County Engineer
By JATK Date 7-19-76

NOTE UNDERLINED ELEVATIONS ARE
PROPOSED FINISH GRADES.

"DESIGN CERTIFICATION"
THIS PLAT WAS PREPARED BY ME,
AND IS CORRECT TO THE BEST OF MY
KNOWLEDGE AND BELIEF.

Eli J. Jelinek
REG. SURVEYOR NO. 4785

"AS BUILT" CERTIFICATION
I, HEREBY CERTIFY THAT THE
CIRCLED GRADES ARE EXISTING
FINISH GRADES CHECKED IN
FIELD ON _____ 19____.
SURVEY IS CORRECT TO THE
BEST OF MY KNOWLEDGE & BELIEF.

REG. SURVEYOR NO.

Revised July 15, 1976	
SITE PLAN FOR DONALD N. HAMILTON	
PART OF LOT 10, TRACT 1, CONCORD TWP, LAKE COUNTY, OHIO	
DATE JUN 76 SCALE 1"=40' DRAWN BY JCO CHECKED BY JATK P&S 28 PG. 78	Colpetzer • Woods Consultants, Inc. CONSULTING ENGINEERS AND SURVEYORS PAINESVILLE, OHIO 44077
SHEET 1	CONTRACT 761

H543-1