


2/3/03
Approved 5-15-03
ZONING PERMIT

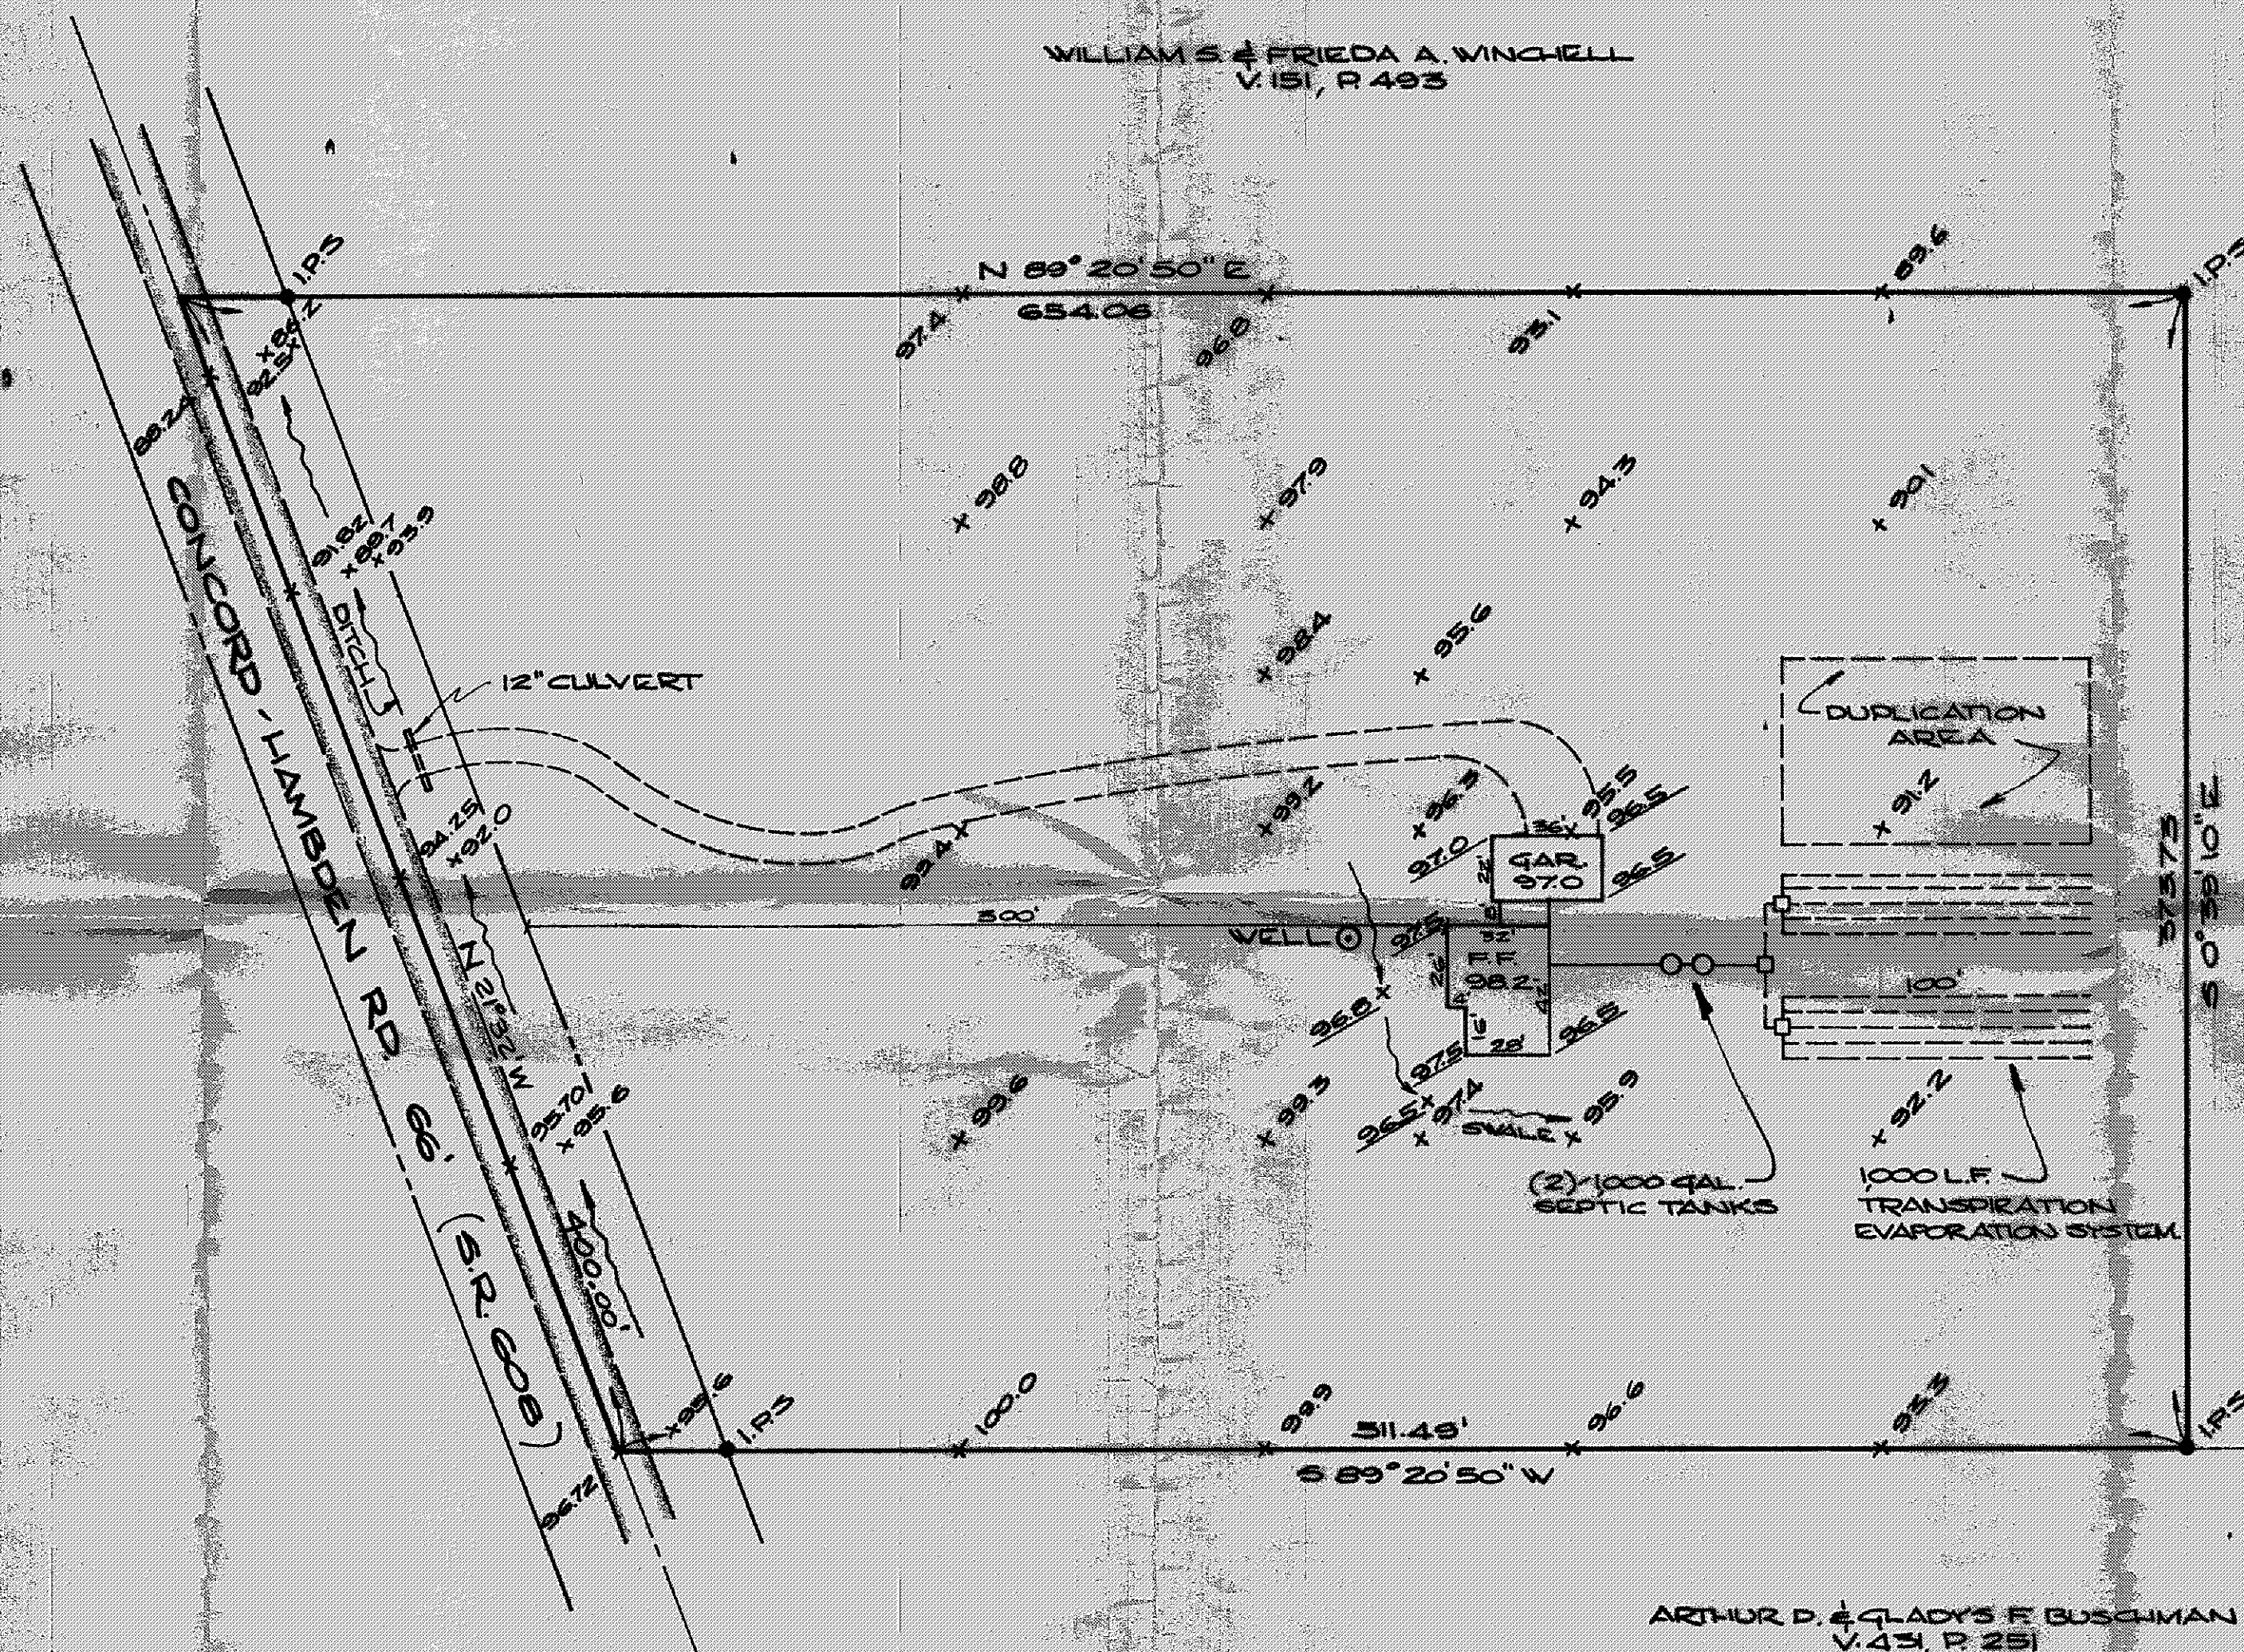

"AS BUILT" CERTIFICATION

I, HEREBY CERTIFY THAT THE CIRCLED GRADES ARE EXISTING FINISH GRADES CHECKED IN FIELD ON 19____. SURVEY IS CORRECT TO THE BEST OF MY KNOWLEDGE & BELIEF.

REGISTERED SURVEYOR No. 4785

DESIGN CERTIFICATION

THIS PLAT WAS PREPARED BY ME, AND IS CORRECT TO THE BEST OF MY KNOWLEDGE & BELIEF.

Thomas P. Gilles
REGISTERED SURVEYOR No. 4785

ARTHUR D. & GLADYS E. BUSCHMAN
V. 43, P. 251

NOTE:
B.M. TOP OF WELL
ELEV. 100.00

PRINTED
Grading Plan Approved
as shown and/or noted
THOMAS P. GILLES, P.E.
Lake County Engineer
2000W Lake County Engineer
Date 5/12/03

SITE PLAN FOR DAVE BUCHOLTZ BEING PART OF LOT 5, TRACT 1, CONCORD TWP, LAKE CO., OHIO Colpetzer - Woods Consultants, Inc. CONSULTING ENGINEERS AND SURVEYORS PAINESVILLE, OHIO 44077		DATE 5/12/03 SCALE 1" = 40' DRAWN BY JWG CHECKED BY JWG F.S. 28
---	--	--