


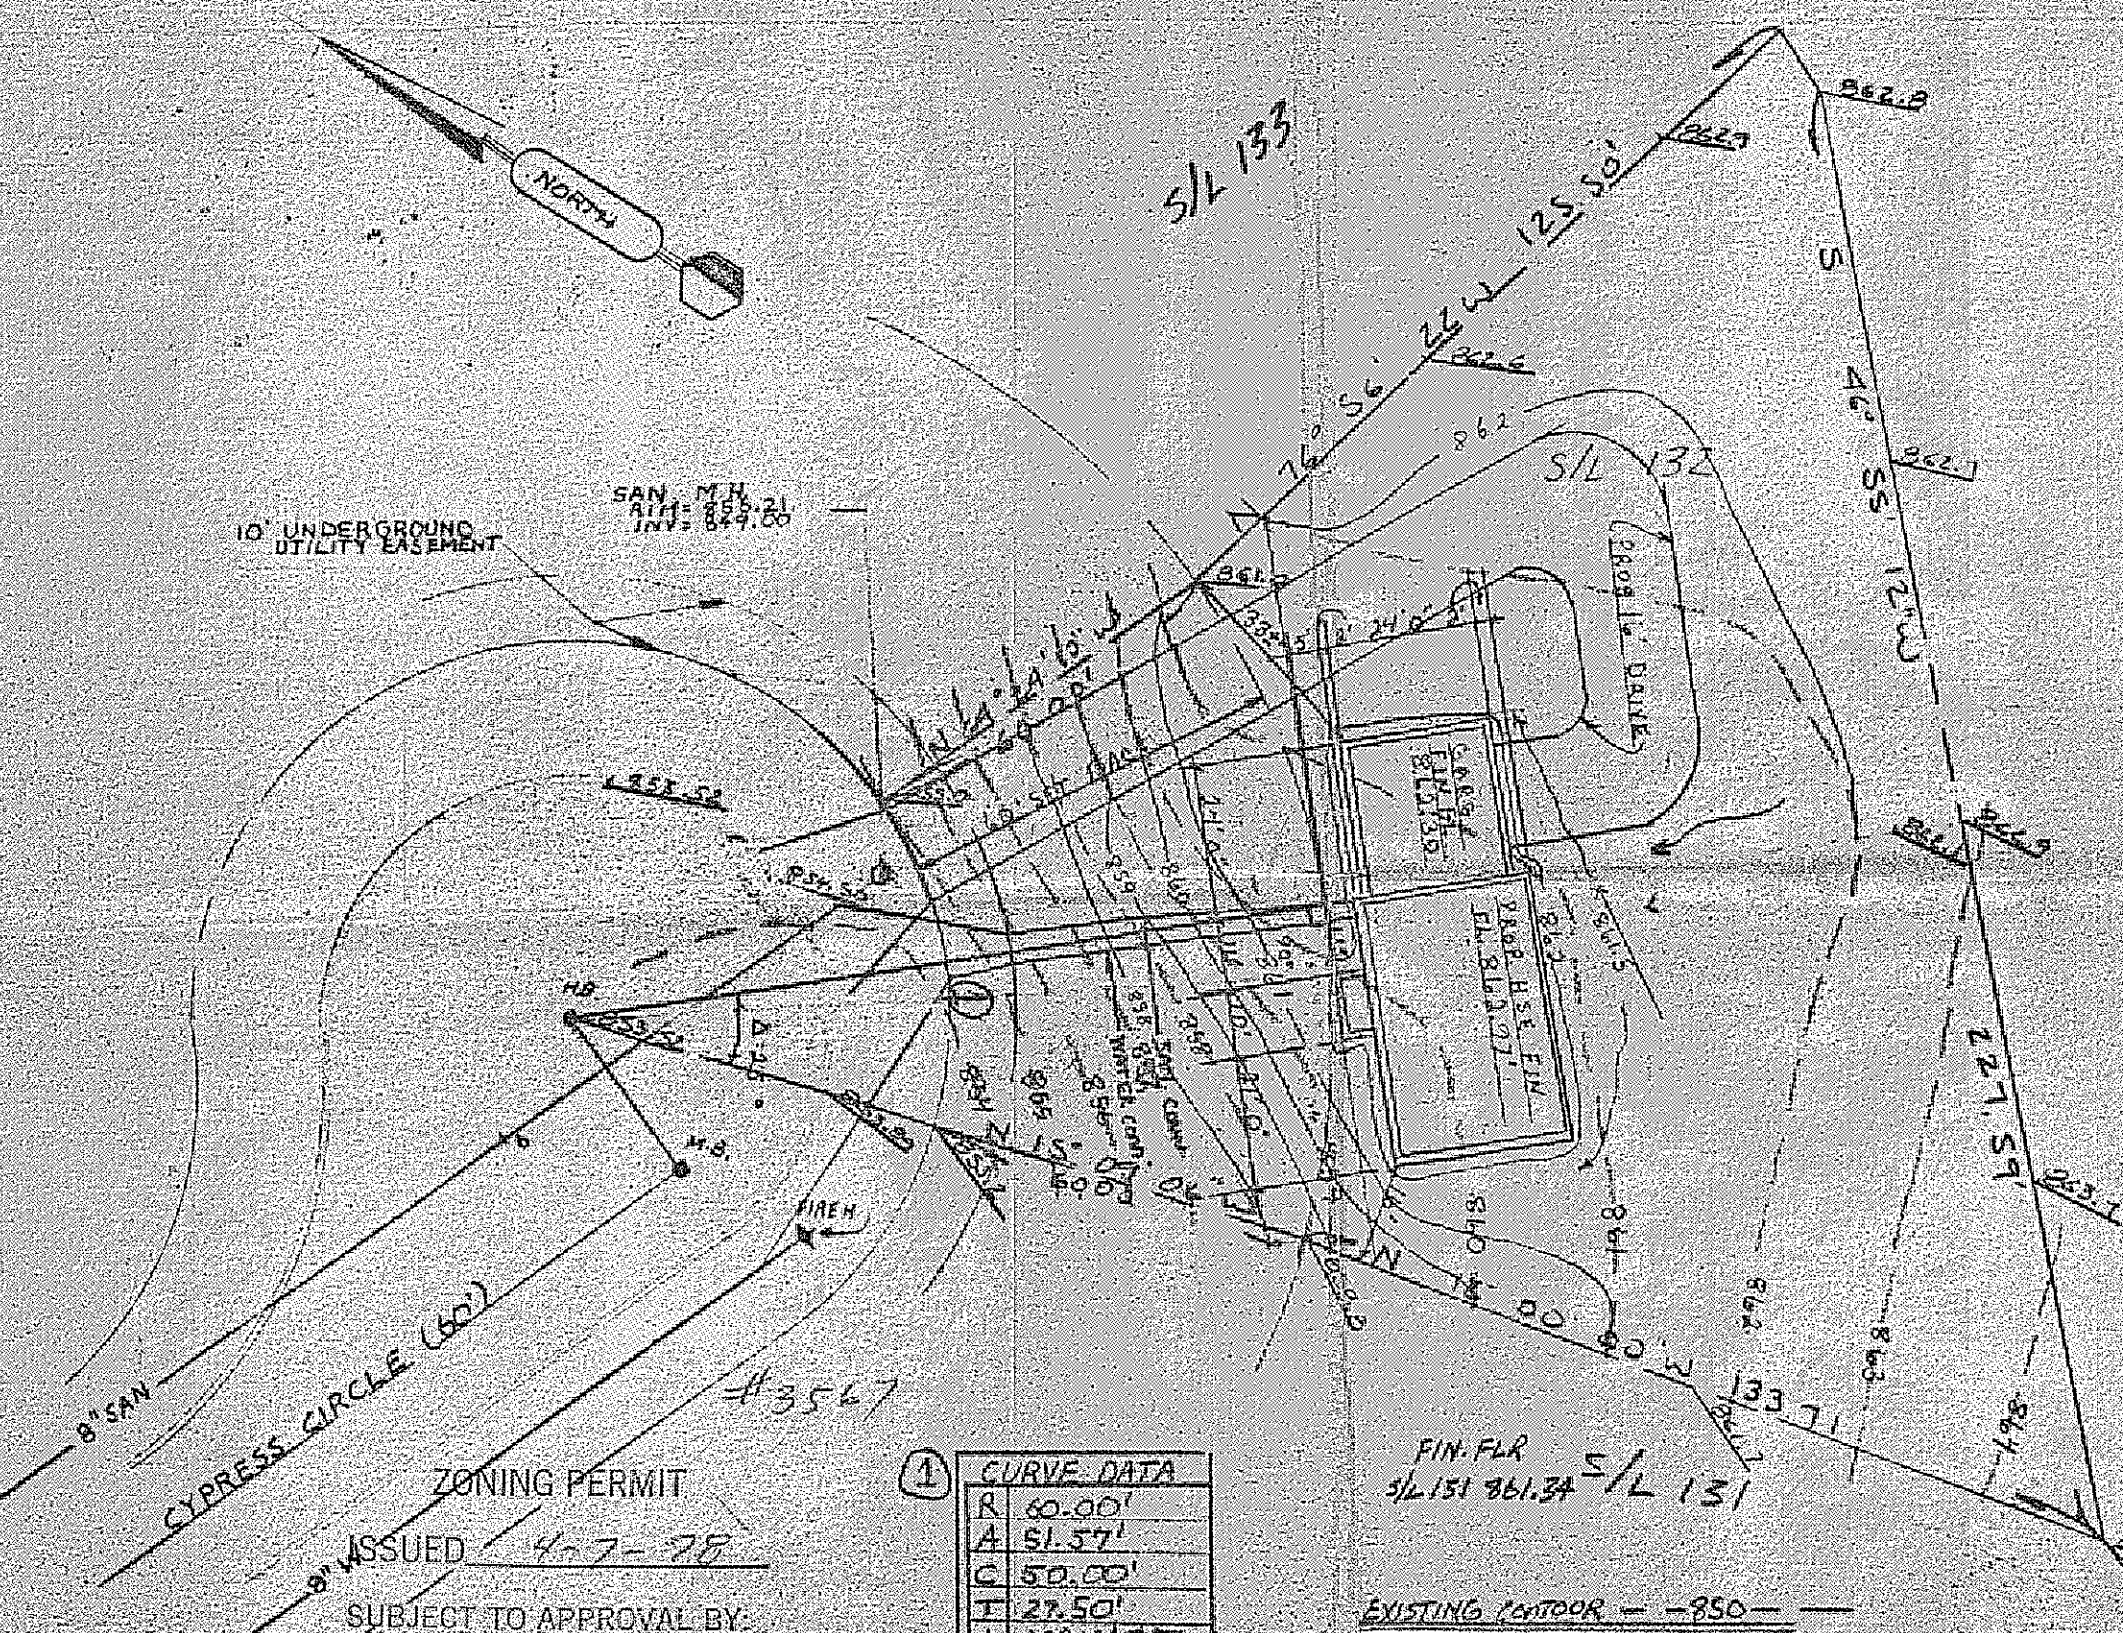


SITE PLAN FOR:
SHANDLE CONST.
8353 MENTOR AVE.
MENTOR, OHIO
 BEING SUBLOT NO
 132 IN MORLEY HILLS ESTATES
 SUBDIVISIONS LOCATED IN
 CONCORD TWP. LAKE COUNTY, OH.
 Grading Plan Approved
 as shown and/or noted
 THOMAS P. GILLES, P. E.
 Lake County Engineer
 By TC Date 11 APR 78

PREPARED BY:
WM. R. GRAY ASSOC. INC.
7547 MENTOR AVE
MENTOR, OHIO

SCALE: 1" = 30'
DATE: 3-30-78
REV. 4-5-78

CERTIFICATION:
 I HEREBY CERTIFY
 THAT THIS PLAN IS COR-
 RECT TO THE BEST OF
 MY KNOWLEDGE
 BY Wm R Gray
 WM. R. GRAY, P.E., SURV. ENG.

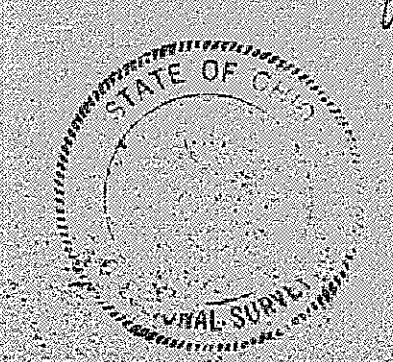

①

CURVE DATA	
R	60.00'
A	51.57'
C	50.00'
T	27.50'
Δ 42° 14' 55"	
CRN 50° 13' 26" E	

FIN. FLR
 S/L 131 861.34 S/L 131
 EXISTING CONTOUR - -850-
 PROPOSED CONTOUR 850
 DRAINAGE

ZONING PERMIT
ISSUED 4-7-78
 SUBJECT TO APPROVAL BY:
 Lake County Sanitary Eng. ☐
 Lake County Eng. Dept. ☒
 Lake County Planning Comm. ☐
 Lake County Bldg. Dept. ☒

F.B. 80-48
DATE 2-1-78