

SITE PLAN

CONCORD TOWNSHIP, LAKE COUNTY, OHIO

for: E.L. MOORE HOMES INC.

CLIENT: 11491 Cedar St. CITY: ZIP:

ADDRESS: STREET:

LOT: TRACT:
SUBDIVISION: 13-20
VOLUME: 7
PAGE: 2A
GENERAL TARGET NO.: STREET:

LEGEND

SANITARY MANHOLE
STORM MANHOLE
INLET OR CATCH BASIN
HYDRANT
EXISTING CONTOURS
PROPOSED CONTOURS
EXIST. ELEV. 100.0
PROP. ELEV. 100.0

WATER VALVE (GAS)
WATER METER (GAS)
AS BUILT ELEVATION
INDICATES DIRECTION OF SURFACE DRAINAGE

REMARKS

ALL BOUNDARY DATA SHOWN WAS OBTAINED FROM (DEEDS, RECORDED SUBDIVISION PLAT OR OTHER PUBLIC RECORDS)
LOCATIONS AS SHOWN OF ADJACENT WELLS AND SEPTIC TANKS OBTAINED FROM LAKE COUNTY HEALTH DEPARTMENT

DESIGN CERTIFICATION

THIS PLAT WAS PREPARED BY ME, AND IS CORRECT TO THE BEST OF MY KNOWLEDGE AND BELIEF.

NAME: SURVEYOR REGISTRATION NO.:

CHECK LIST

NO. OF BEDROOMS
DIMENSIONS
SAN. SEWER SIZE & GR. LOC.
SEASONS
THE TO NEAREST STREET
SUBLOT NO. PARCEL NO.
BLDG. DIMENSIONS FIN. GR.
BLDG. DIMENSIONS FIN. GR.
BLDG. TYPE, GRADES
APPROX. TYPE WIDTH THICKNESS
SIDEWALK TYPE DIA. LENGTH
ROCK OUTCROPPINGS

WATER MAIN SIZE, LOCATION
SAN. SEWER SIZE & GR. LOC.
SAN. METER, CAST. ELEV. INV. ELEV.
SAN. CORR. SIZE, LOC. DEPTH
STORM SEWER SIZE & GR. LOC.
STORM METER, CAST. ELEV. INV. ELEV.
PLAT TYPE GRADE CURVES
GAS LINE LOC. SIZE PRESSURE
SEPTIC TANK LOCATION & DUPLICATION AREA
WELL LOCATION
ISOLATION RADIUS FROM WELL

PLAN PREPARED BY:

BABCOCK • JONES & ASSOCIATES, INC.

PAINESVILLE, OHIO

NO.	DATE	BY	SCALE	PHONE NO.
1			1" = 30'	357-1811
2				
3				
4				
5				

REVISIONS

CHIEF: DATE: 9-6-90

APPD. 89-155-07

"AS BUILT" CERTIFICATION



I, HEREBY CERTIFY THAT THE CIRCLED GRADES ARE EXISTING FINISH GRADES CHECKED IN THE FIELD ON 19____ AND ARE CORRECT TO THE BEST OF MY KNOWLEDGE AND BELIEF.

REGISTERED SURVEYOR REG. NO.:

T.B.M.: TOP OF HYDRANT 877.69

Grading Plan Approved
BY: G.H. DATE: 9/24/90
Lake County Engineer

1. CONNECT SUMP PUMP TO YARD DRAIN

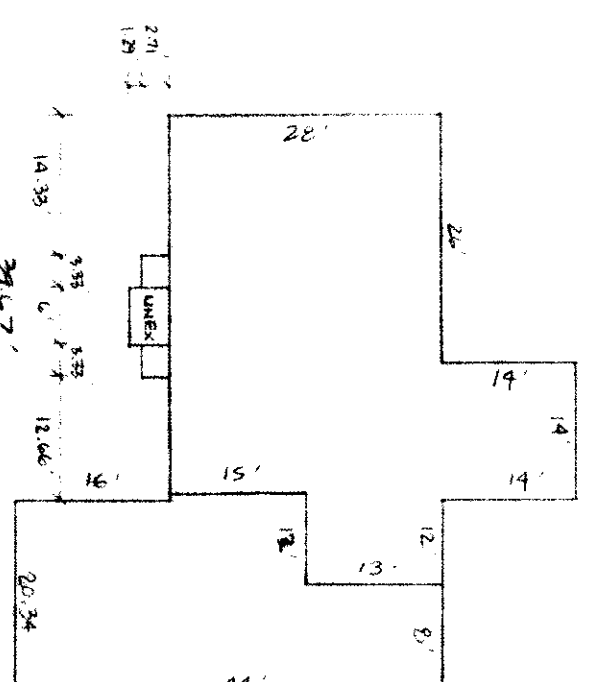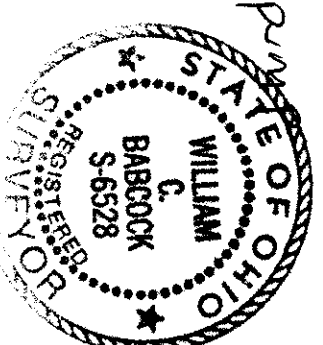

CALI COURT - 60'

6605
ISSUED 9-14-90
SUBJECT TO APPROVAL BY:
Lake County Surveyor Eng. ☐
Lake County Public Dept. ☒
Lake County Planning Comm. ☐
Lake County Bldg. Dept. ☒
Pamela J. Mariano