


for : CHARLES A. PENGAL
CLIENT

11702 CALI Ct.		CONCORD
ADDRESS	STREET	CITY


35		CALL WOODS Ph.2	
SUBLOT No.		SUBDIVISION NAME	VOL. PAGE
8.9.10	1	CONCORD	OHIO
LOT	TRACT	TOWNSHIP	

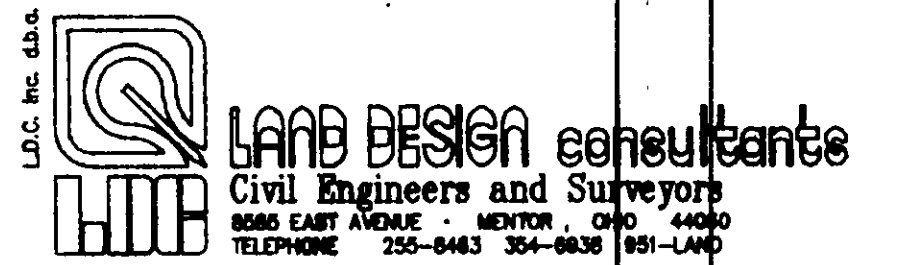

THIS PLAT WAS PREPARED BY ME, AND IS CORRECT TO THE
BEST OF MY KNOWLEDGE AND BELIEF.

Richard S. Thompson 3/1/00
NAME

LOT DIMENSIONS & BEARINGS
TO NEAREST STREET
SUBLOT No. (PARCEL No.)
SURROUNDING OWNERS
BUILDING DIMENSIONS
SEWERBACK, SIDEYARD, REARYARD
FINISHED GRADES
DRIVE & APRON TYPE, WIDTH, THICKNESS
SIDEWALK TYPE, WIDTH, THICKNESS
CULVERT TYPE, WIDTH
WATER MAIN SIZE, LOCATION
SAN. SEWER SIZE, & GRADE, LOC.
SAN. H/L C&T, ELEV., INV. ELEV.
STORM SEWER SIZE, & GRADE, LOC.
STORM H/L C&T, ELEV., INV. ELEV.
PAV'T TYPE, GRADE
GAS LINE LOC. & GRADE
SEPTIC SYSTEM & DUPICATION
WELL LOCATION & ISOLATION RADIUS

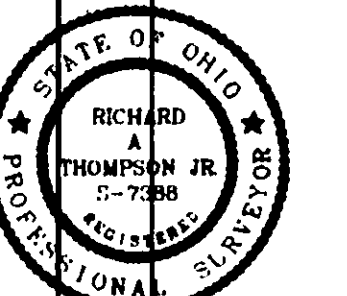

I HEREBY CERTIFY THAT THE CIRCLED INFORMATION IS
EXISTING AS OBTAINED ON THE SITE _____
1994 AND IS CORRECT TO THE BEST OF MY KNOWLEDGE
AND BELIEF.

NAME

STORM MANHOLE
SANITARY MANHOLE
EXISTING CONTOURS
PROPOSED CONTOURS

DIST. ELEV. 100.0
100.0 PROP. ELEV.

DIRECTION OF
SURFACE DRAINAGE

DRAWN BY		SCALE
jbr/site2.dwg		1"=30'-0"
CHK'D BY	FIELD	DATE
R.A.T./T.S.		Feb., 2000

BENCHMARK: *B.M.=T.B.M. Set On Top Of Hydrant
Located In Front Of Sublot 35;
Elev.: 848.45*

REVIEWED AND ACCEPTED
LAKE COUNTY GENERAL
HEALTH DISTRICT

Date 3-16-00 BY [Signature]


SEWAGE DISPOSAL PERMIT MUST BE
OBTAINED BY A LAKE COUNTY LICENSED
INSTALLER BEFORE INSTALLATION
STARTED.

S/L
(Vacant)

HYDRAULIC PROFILE
 S. ALF. HORIZ. $r'' = 40'$
 VERT. $r' = 10'$



OWG. NAME	
PENGC1-9703	

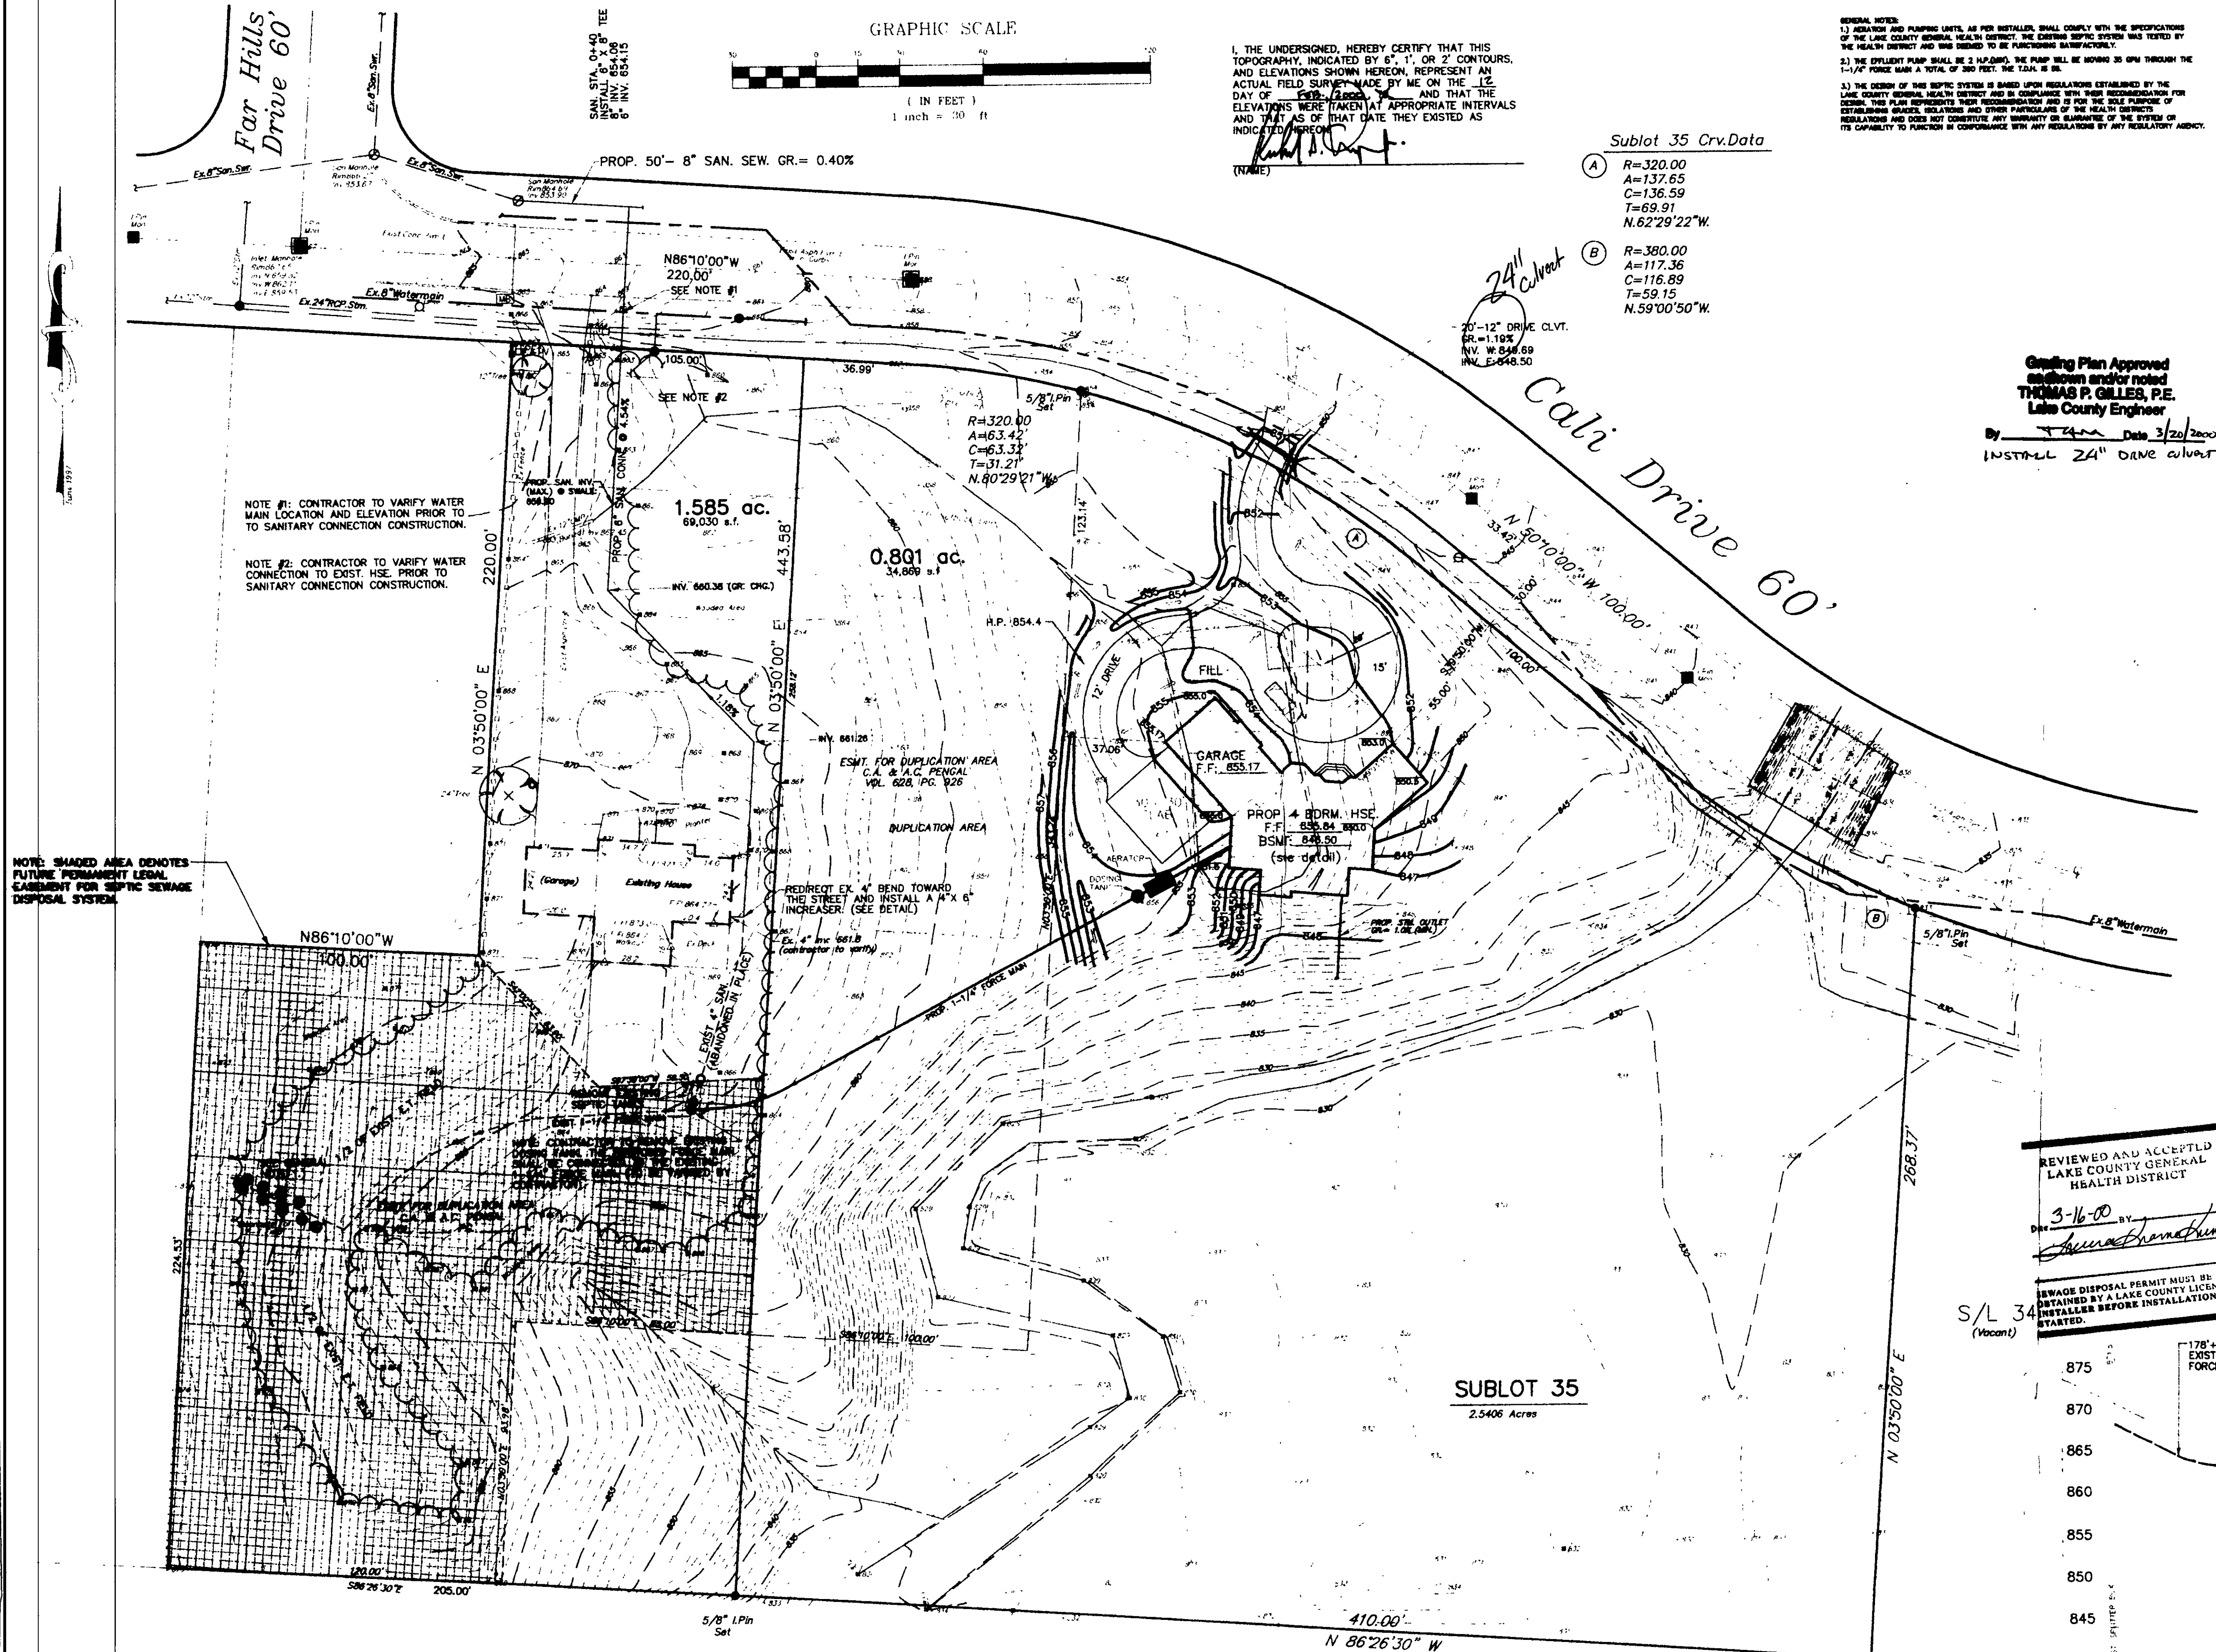

EXISTING UNDERGROUND UTILITIES NOTE:
THE SIZE & LOCATION, BOTH HORIZONTAL AND VERTICAL,
OF THE UNDERGROUND UTILITIES SHOWN HEREON, HAVE BEEN
OBTAINED BY A SEARCH OF AVAILABLE RECORDS.
VERIFICATION BY FIELD OBSERVATION HAS BEEN CONDUCTED
WHERE PRACTICAL. HOWEVER, LDC INC. DOES NOT
GUARANTEE THE COMPLETENESS NOR ACCURACY THEREOF.