

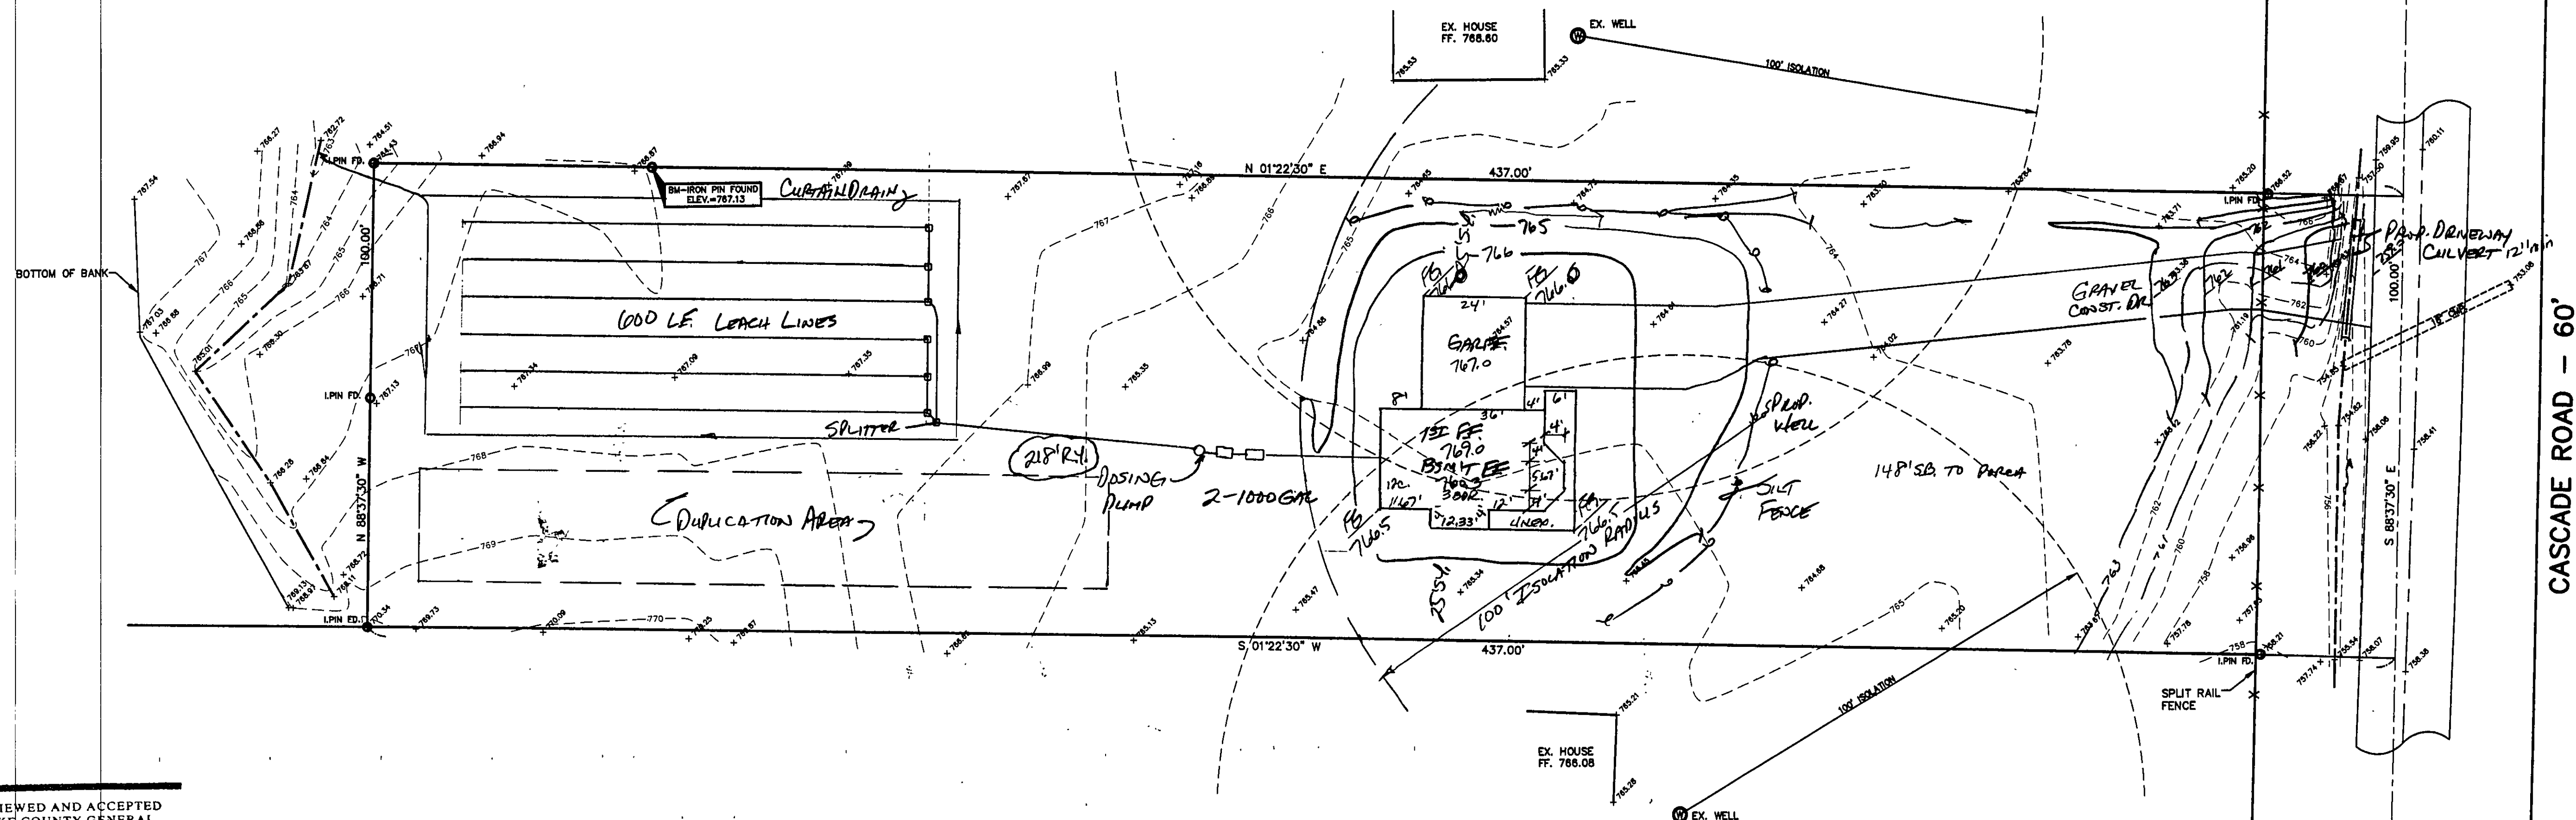
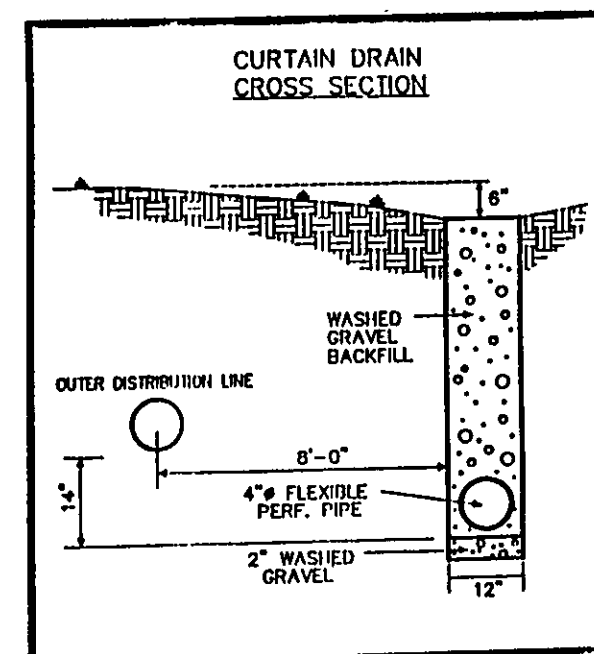


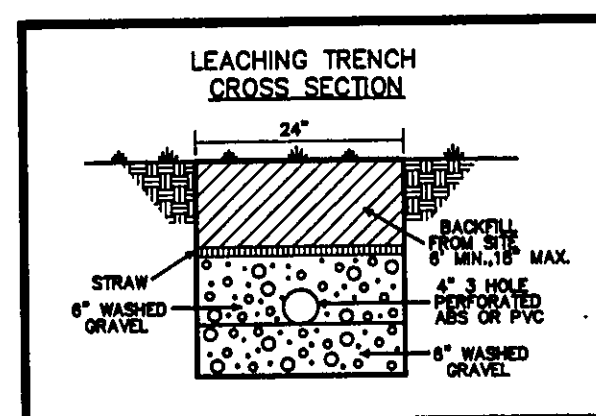

REVIEWED AND ACCEPTED
LAKE COUNTY GENERAL
HEALTH DISTRICT

DATE 7-27-01 BY [Signature]

SEWAGE DISPOSAL PERMIT MUST BE
OBTAINED BY A LAKE COUNTY LICENSED
INSTALLER BEFORE INSTALLATION IS
STARTED.

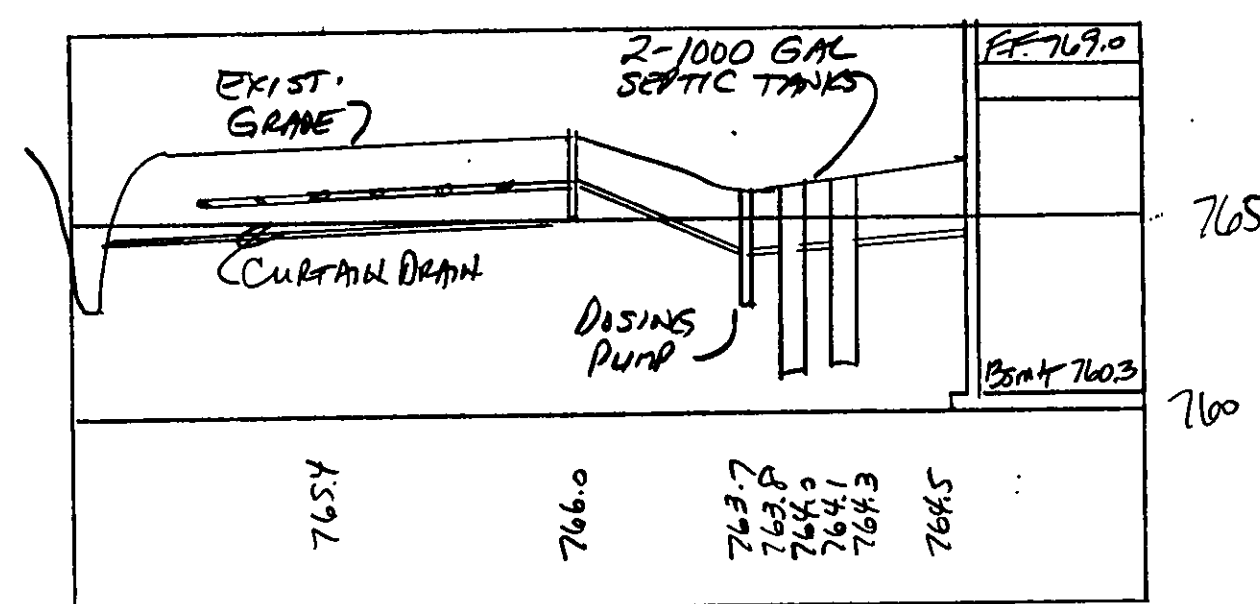

HYDRAULIC PROFILE
HORIZ. 1"=20' VERT. 1"=5'

NOTE: TEMPORARY SEEDING REQUIRED
IN DISTURBED AREAS.

NOTE:
TEMPORARY SEEDINGS REQUIRED
IN DISTURBED AREAS.

Grading Plan Approved
as shown and/or noted
JAMES R. GILLS, P.E.
Lake County Engineer

By [Signature] Date 8-1-01
1. Lower E.G. as noted and scale as shown
2. Reference zoning permit # 0101-10240

ROOF DRAINS
SHALL DISCHARGE
TO SPLASH BLOCKS.

"I, the undersigned hereby certify that
this topography indicated by 6", 1", or 2"
contours, and elevations shown hereon
represent an actual field survey made by
me on the 27th day of June, 2001
and that the elevations were taken at
appropriate intervals and that as of that
date they existed as indicated hereon."

[Signature] #10343
Name Reg. No.

REV. NO.	DESCRIPTION	DATE	BY	CHK'D
1	REVISED SEPTIC	7-27-01	HT	HT

bj BABCOCK, JONES AND ASSOCIATES, INC
CIVIL ENGINEERS - SURVEYORS - LAND PLANNERS
PAINESVILLE OHIO 44077

DATE	6/27/01
DESIGN BY	H.J.
DRAWN BY	T.R.
APPROVED BY	H.J.

SITE PLAN
FOR
VAN WINKLE BUILDERS
PARCEL 8A-6D-25 CASCADE ROAD
CONCORD TOWNSHIP LAKE COUNTY

SCALE	1"=20'
JOB NO	01-119
SHEET	1 OF 1

