


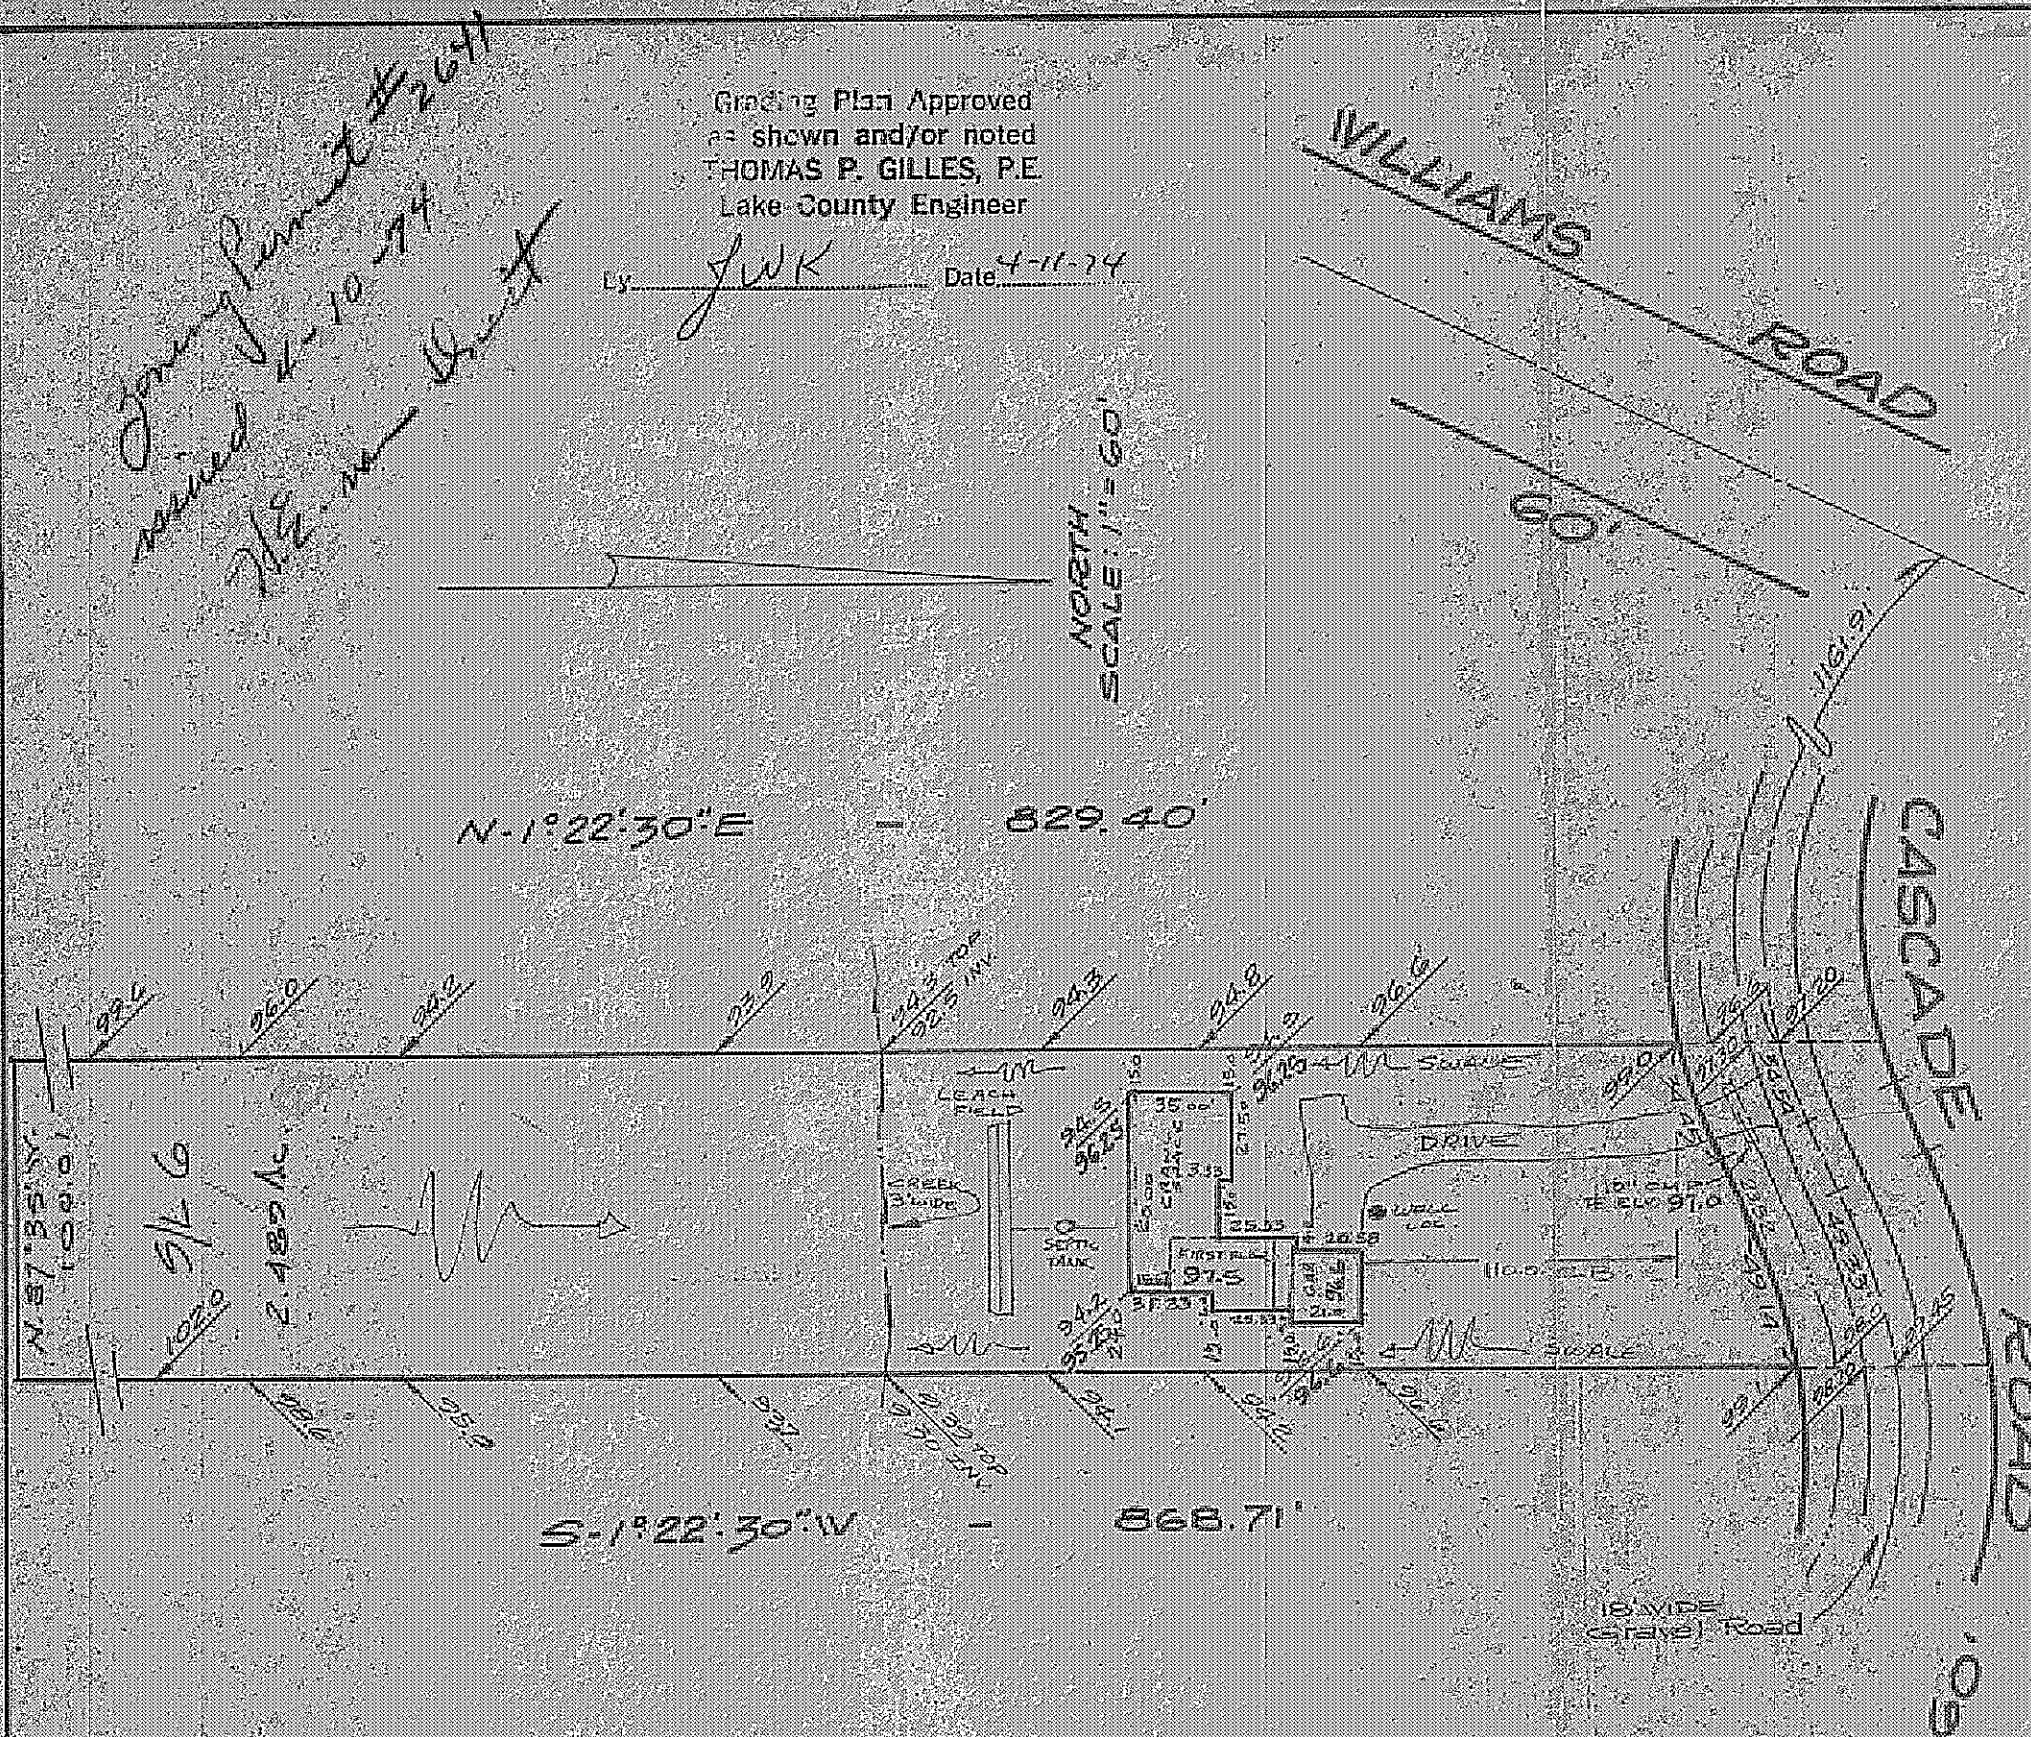

Grading Plan Approved
as shown and/or noted
THOMAS P. GILLES, P.E.
Lake County Engineer

By JWK Date 4-11-74

NORTH
SCALE 1" = 60'

N-1°22'30"E - 829.40'

S-1°22'30"W - 868.71'

"AS BUILT" CERTIFICATION

I HEREBY CERTIFY THAT THE CIRCLED GRADES ARE EXISTING FINISH
GRADES CHECKED IN FIELD ON _____ 19__ BY _____
SURVEYING AND ARE CORRECT TO THE BEST OF MY KNOWLEDGE AND BELIEF

REGISTERED SURVEYOR

REG. NO.

SITE PLAN

CONCORD
TOWNSHIP

LAKE COUNTY, OHIO

for JOHN C. KOLOVICH
CLIENT OWNER

37 BROWN RD.

ADDRESS STREET CITY ZIP

CASCADE VALLEY ESTATES
SUBDIVISION L-105 NAME

6 CASCADE RD
SUBLOT NO STREET

LOT TRACT

VOLUME PAGE

PERM PARCEL # STREET

LEGEND

SANITARY MANHOLE	---	○	WATER VALVE (GAS)	---	○
STORM MANHOLE	---	●	WATER METER (GAS)	---	○
INLET OR CATCH BASIN	---	■	AS BUILT ELEVATION	---	100.0
HYDRANT	---	○	INDICATES	---	
EXISTING CONTOURS	---	---	DIRECTION OF	---	
PROPOSED CONTOURS	---	---	SURFACE DRAINAGE	---	
EXIST. ELEV. 100.0	---			---	
100.0 PROP. ELEV.	---			---	

REMARKS

ALL BOUNDARY DATA SHOWN WAS OBTAINED FROM DEEDS, RECORDED
SUBDIVISION PLAT, OR OTHER PUBLIC RECORDS

DESIGN CERTIFICATION

THIS PLAT WAS PREPARED BY ME, AND IS CORRECT
TO THE BEST OF MY KNOWLEDGE AND BELIEF

Richard Salo PS# 5244
NAME SURVEYOR REGISTRATION NO.

CHECK LIST

DIMENSIONS	WATER MAIN SIZE LOCATION
BEARINGS	SAN SEWER SIZE % GR LOC
TIE TO NEAREST STREET	SAN M.H. CAST ELEV. INV. ELEV.
SUBLOT NO PARCEL NO	SAN CONN. SIZE LOC. DEPTH
SURROUNDING OWNERS	STORM SEWER SIZE % GR LOC
BLDG. DIMENSIONS FIN. GR.	STORM M.H. CAST ELEV. INV. ELEV.
BLDG. TIES FLOOR GRADES	PAVT. TYPE GRADE CURBS
APRON TYPE WIDTH THICKNESS	GAS LINE LOC. SIZE PRESSURE
SIDEWALK TYPE WIDTH THICKNESS	SEPTIC TANK SIZE LOC.
CULVERT TYPE DIA. LENGTH	WELL LOCATION

REVISIONS

NO.	DATE	BY
1	8/4/74	WB
2		
3		
4		
5		

PLAN PREPARED BY

DEBEVEC SALO & ASSOC., INC.
NAME

130 EAST JACKSON ST. PAINESVILLE
ADDRESS

DRAWN BY <u>JSB</u>	SCALE <u>1" = 60'</u>	PHONE NO.
CHECKED <u>JSB</u>	DATE <u>4.3.73</u>	DRAWING NO.
CREW CHIEF	APP'D.	<u>3888</u>