

**FOR
JELENIC CONSTRUCTION**
**BEING SUBLot No. 18 IN THE CHAIRMAN'S COVE SUBDIVISION,
IN THE TOWNSHIP OF CONCORD COUNTY OF LAKE,
STATE OF OHIO**

CONCORD TOWNSHIP ZONING OFFICE
ISSUED PERMIT # 0500-9759
5/11/2000
SUBJECT TO APPROVAL BY:
Co. Sanitary Engineer
Twp. Dept.
Zoning Comm.
Dist.

REF: VACANT

SUBJECT TO APPROVAL BY:

☐ Late Co. Sanitary Engineer

☒ Late Co. Eng. Dept.

☐ Late Co. Planning Comm.

☒ Late Co. Building Dept.


☒ Late Co. Soil & Water Cons. Dist.

**Grading Plan Approved
as shown and/or noted
THOMAS P. GILLES, P.E.
Lake County Engineer.**

By TAM Date 8/12/2000
110 **ROOF DRAINS** swale along
SHALL DISCHARGE drive
TO SPLASH BLOCKS.

I, the undersigned hereby certify that this topography, indicated by 1' contours and elevations shown hereon represent an actual field survey made by me on 4-28-2000 and that the elevations were taken at appropriate intervals and that as of that date they existed as indicated hereon.

J. M. Coffman P.S.
No 685

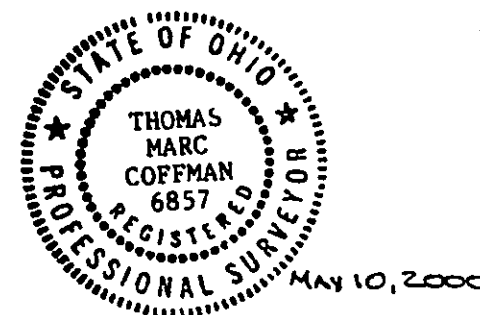

VILLAGE SURVEYING Co.
P.O. BOX 1096, FAIRPORT HBR, OH 44077
(440) 357-1359