



(A) R = 720.58'
 A = 129.09'
 Δ = 10° 15' 51"
 C = 128.91'
 S. 27° 29' 29" E

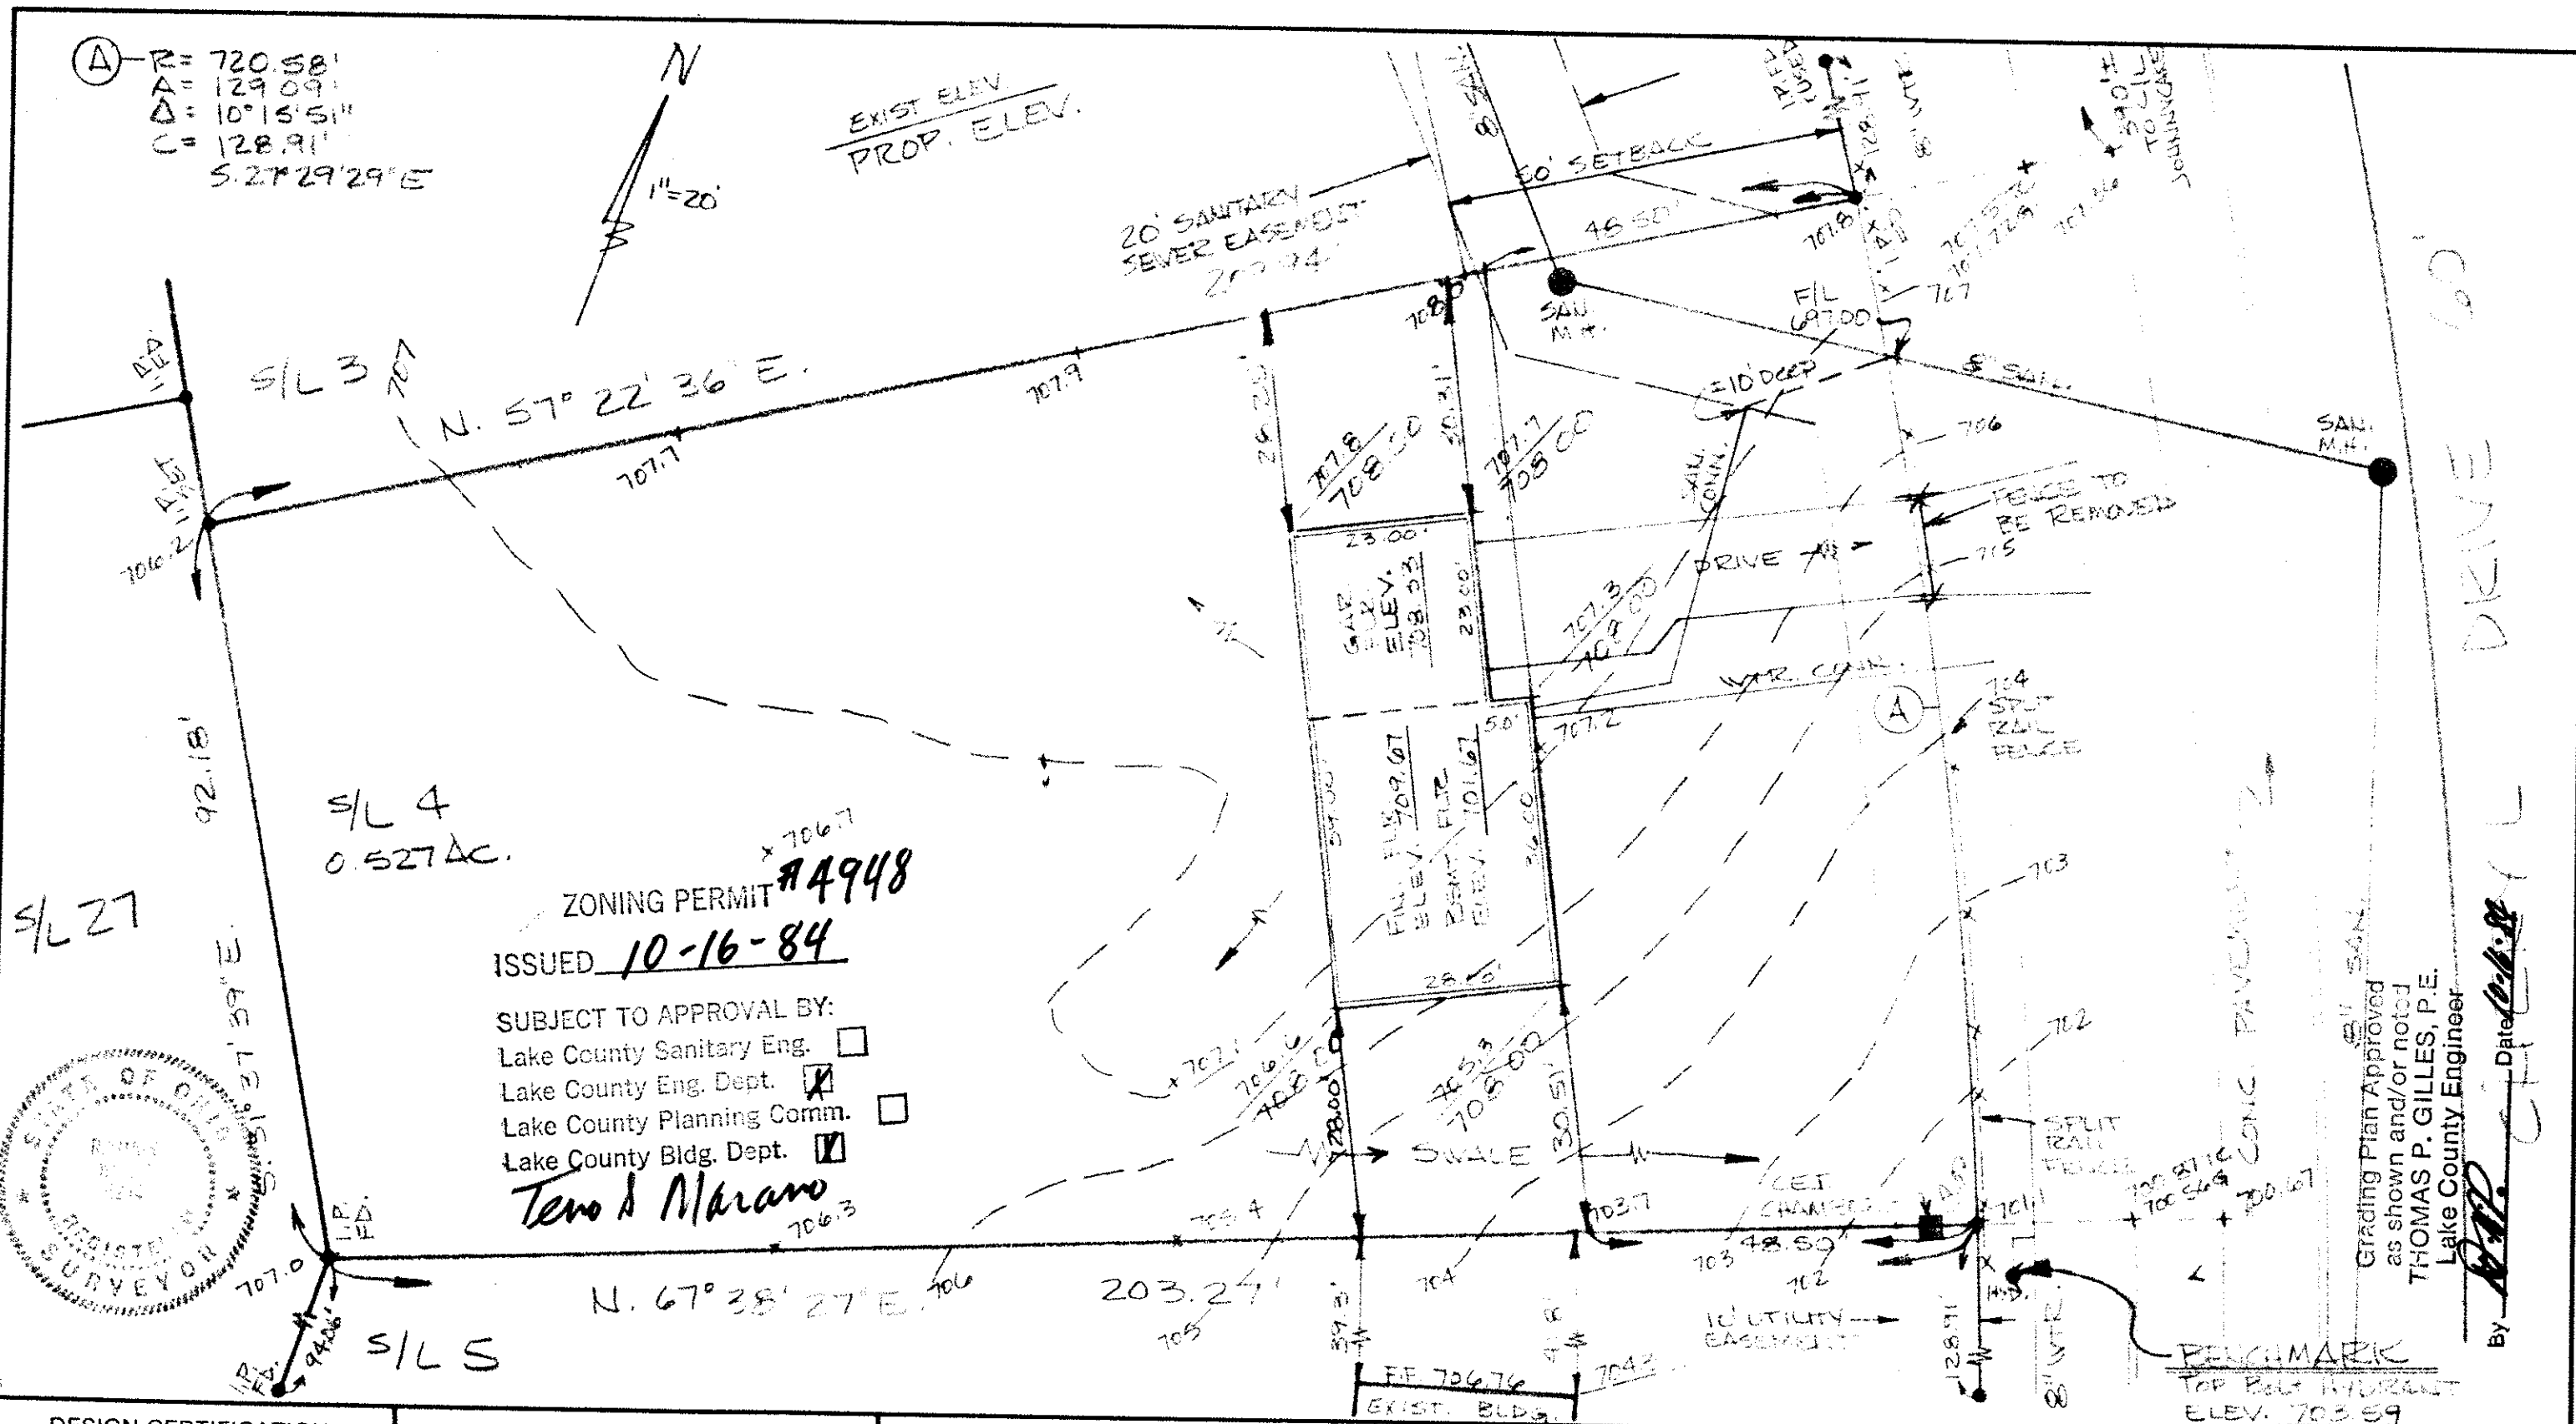

ZONING PERMIT #4948
 ISSUED 10-16-84
 SUBJECT TO APPROVAL BY:
 Lake County Sanitary Eng. ☐
 Lake County Eng. Dept. ☒
 Lake County Planning Comm. ☐
 Lake County Bldg. Dept. ☒
 Tero A. Alarano

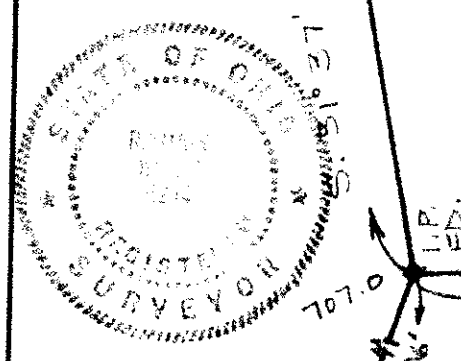

DESIGN CERTIFICATION
 THIS PLAT WAS PREPARED BY ME,
 AND IS CORRECT TO THE BEST OF
 MY KNOWLEDGE AND BELIEF.
 REG. SURVEYOR NO. 5244

AS BUILT CERTIFICATION
 I HEREBY CERTIFY THAT THE CIRCLED GRADES
 ARE EXISTING FINISH GRADES CHECKED IN THE
 FIELD ON _____ AND THAT
 SURVEY IS CORRECT TO THE BEST OF MY
 KNOWLEDGE AND BELIEF.
 REG. SURVEYOR NO. _____

COLPETZER · WOODS
 CONSULTANTS, INC.
 9470 MENTOR AVENUE • MENTOR, OHIO 44060 • (216) 357-7569

DATE 10-2-84
 SCALE 1" = 20'
 DRWN BY RLS
 CHKD BY _____
 JOB NO. 84-238
 FB. 504 PG. 34

SITE PLAN
 FOR
 WYNNI SPALLER
 BEING S/L #4 OF CONCORD KELLOGG PARK
 ESTATE, SUBD. VOL. X PG. 13
 IN CONCORD TWP., LAKE COUNTY, OHIO

Grading Plan Approved
 as shown and/or noted
 THOMAS P. GILLES, P.E.
 Lake County Engineer

By *[Signature]* Date 10-16-84