

Tom-lead
352-4805
6217 Chough

SITE PLAN


FOR
GREGORY R. LEWIS

BEING SURLOT No. 54 CONCORD KELLAS
PARK ESTATES, TOWNSHIP OF CONCORD,
LAKE COUNTY, OHIO

Grading Plan Approved
as shown and/or noted
THOMAS P. GILLES, P.E.
Lake County Engineer

By THP Date 5/27/87


Note: DRIVEWAY SHOULD BE CROWNED
TO DIVERIT SURFACE DRAINAGE
AWAY FROM GARAGE.

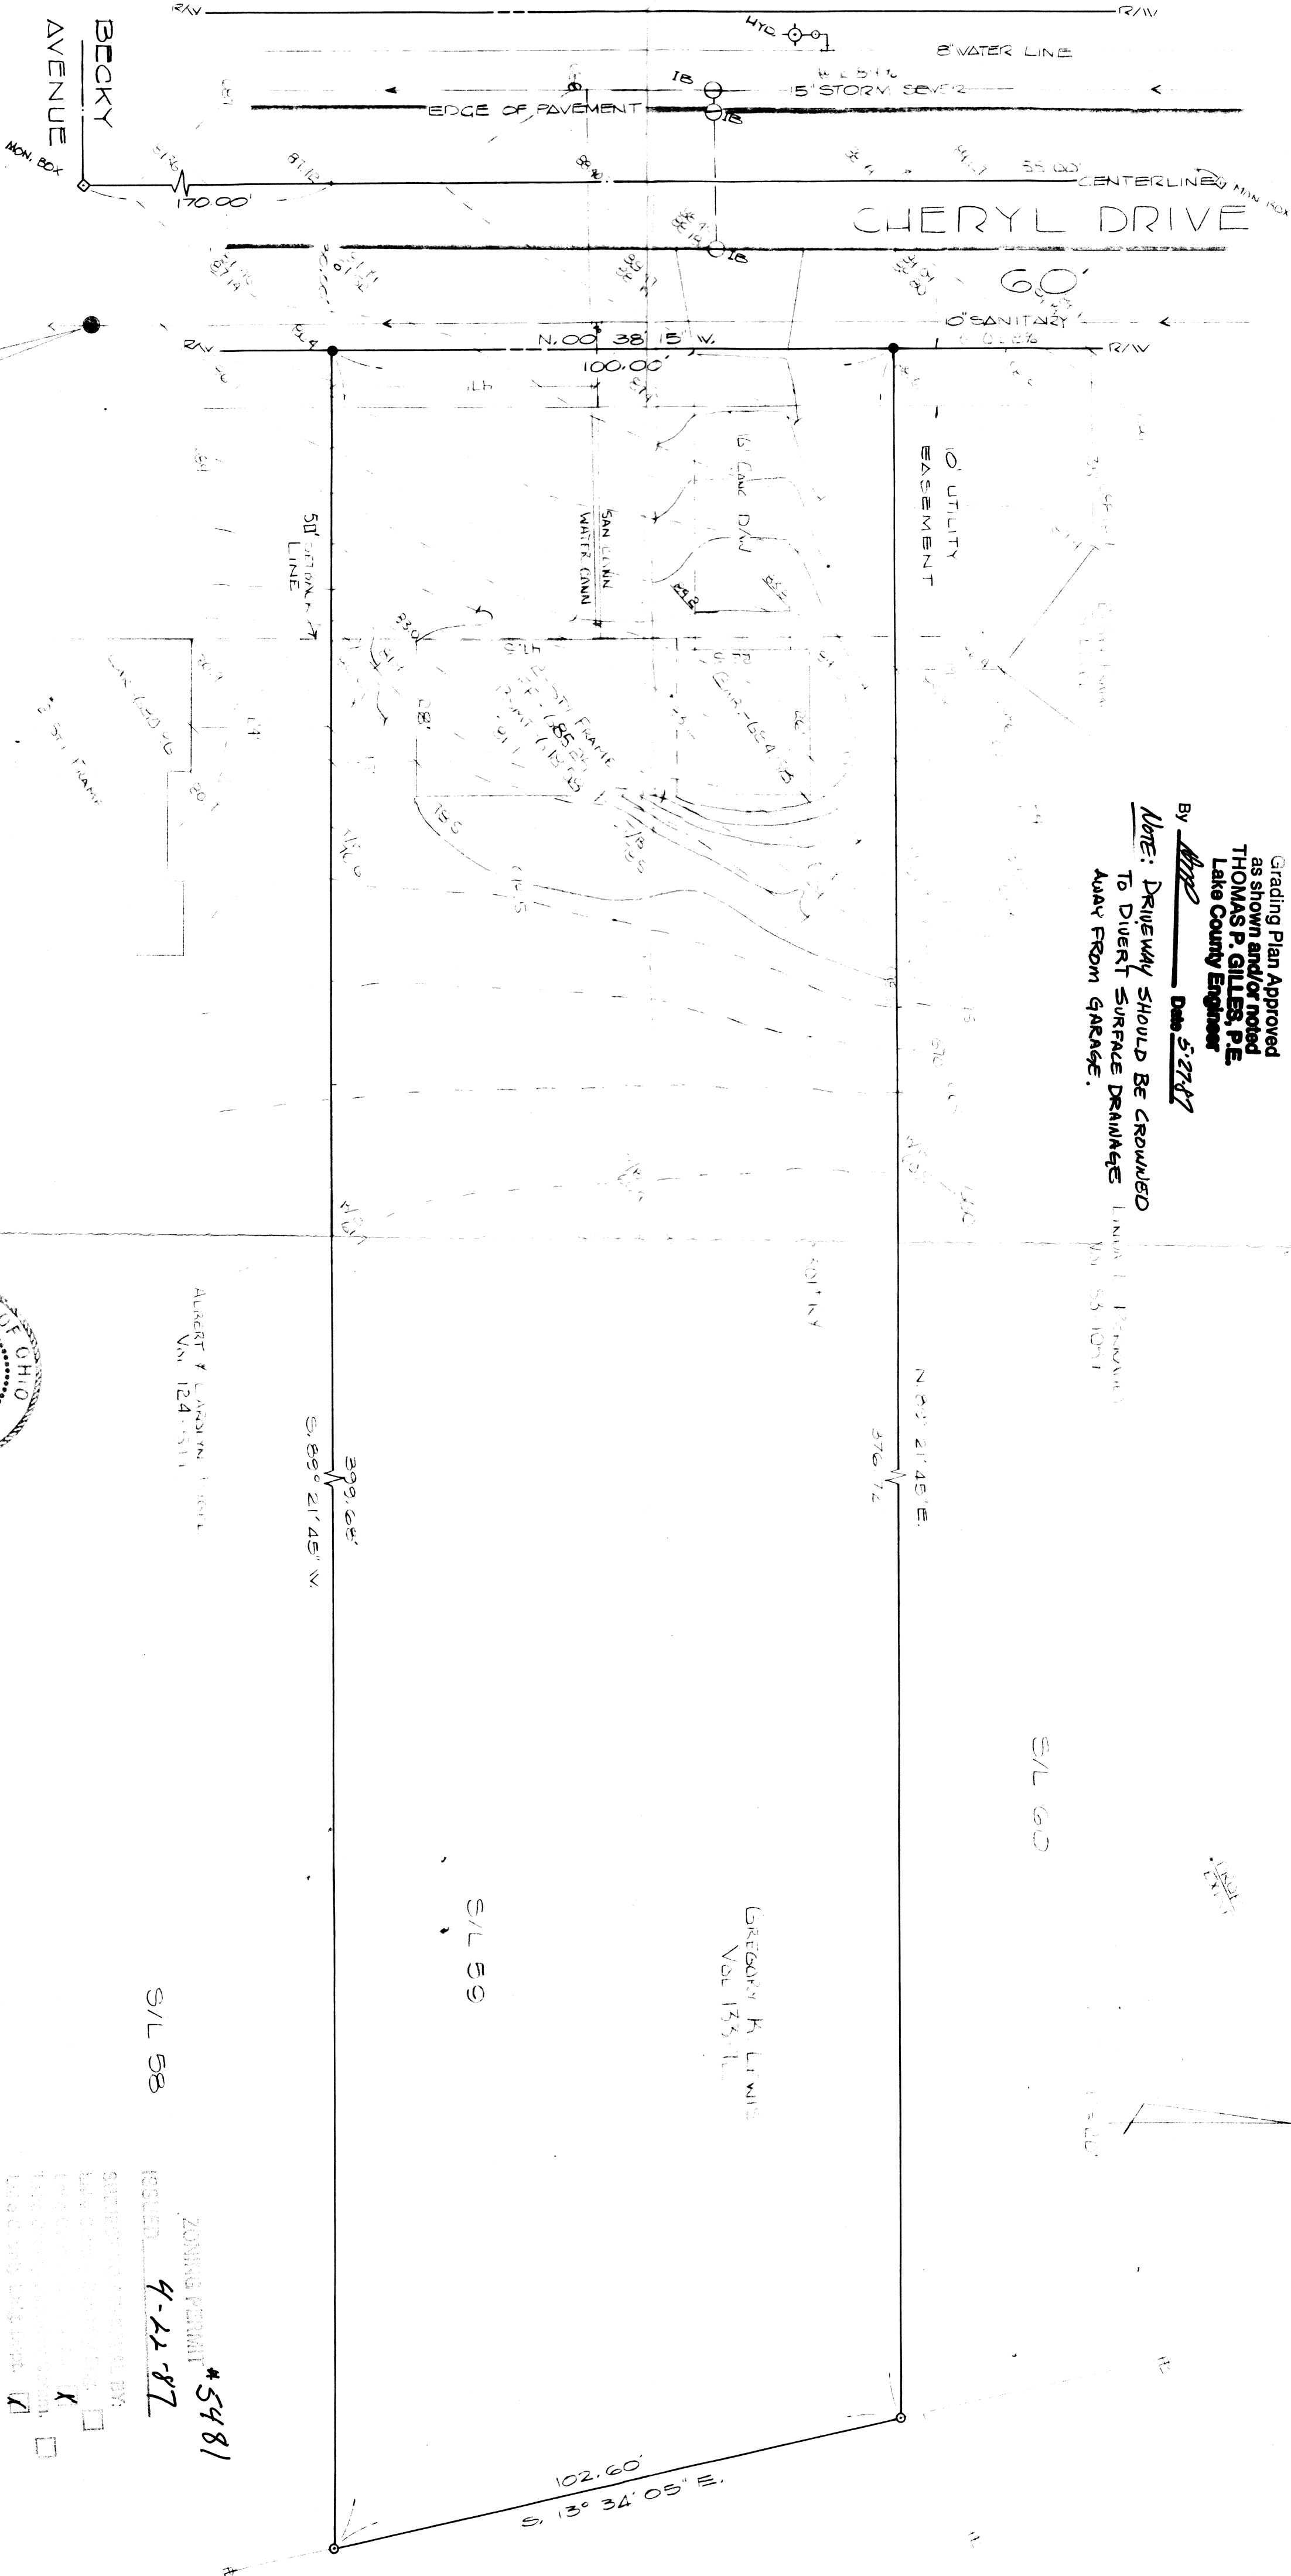

BENCHMARK - 686.02
N. RIM SAN M.H. IN 685.55

THIS PLAN WAS PREPARED BY ME
AND IS CORRECT AND ACCURATE TO
THE BEST OF MY KNOWLEDGE AND
BELIEF.

Thomas M. Coffman
THOMAS M. COFFMAN NO. 6857

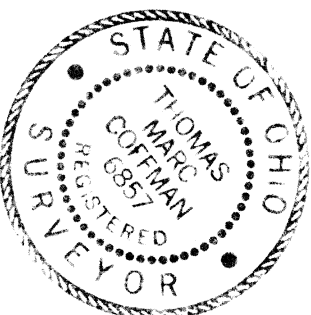

ALBERT A. LAMBERT
Vol. 124-1511

S/L 58

ZONING PERMIT #5481
ISSUED 4-22-87

SUBMITTED TO BOARD OF
LAW ENFORCEMENT BY: ☒
LAW ENFORCEMENT OFFICER: ☒
LAW ENFORCEMENT AGENCY: ☒
LAW ENFORCEMENT AGENCY: ☒
LAW ENFORCEMENT AGENCY: ☒
LAW ENFORCEMENT AGENCY: ☒

Tom P. Mariano

VILLAGE SURVEYING CO.
202 THIRD ST. FAIRPORT HARBOR, OHIO 44131
(216) 351-1354