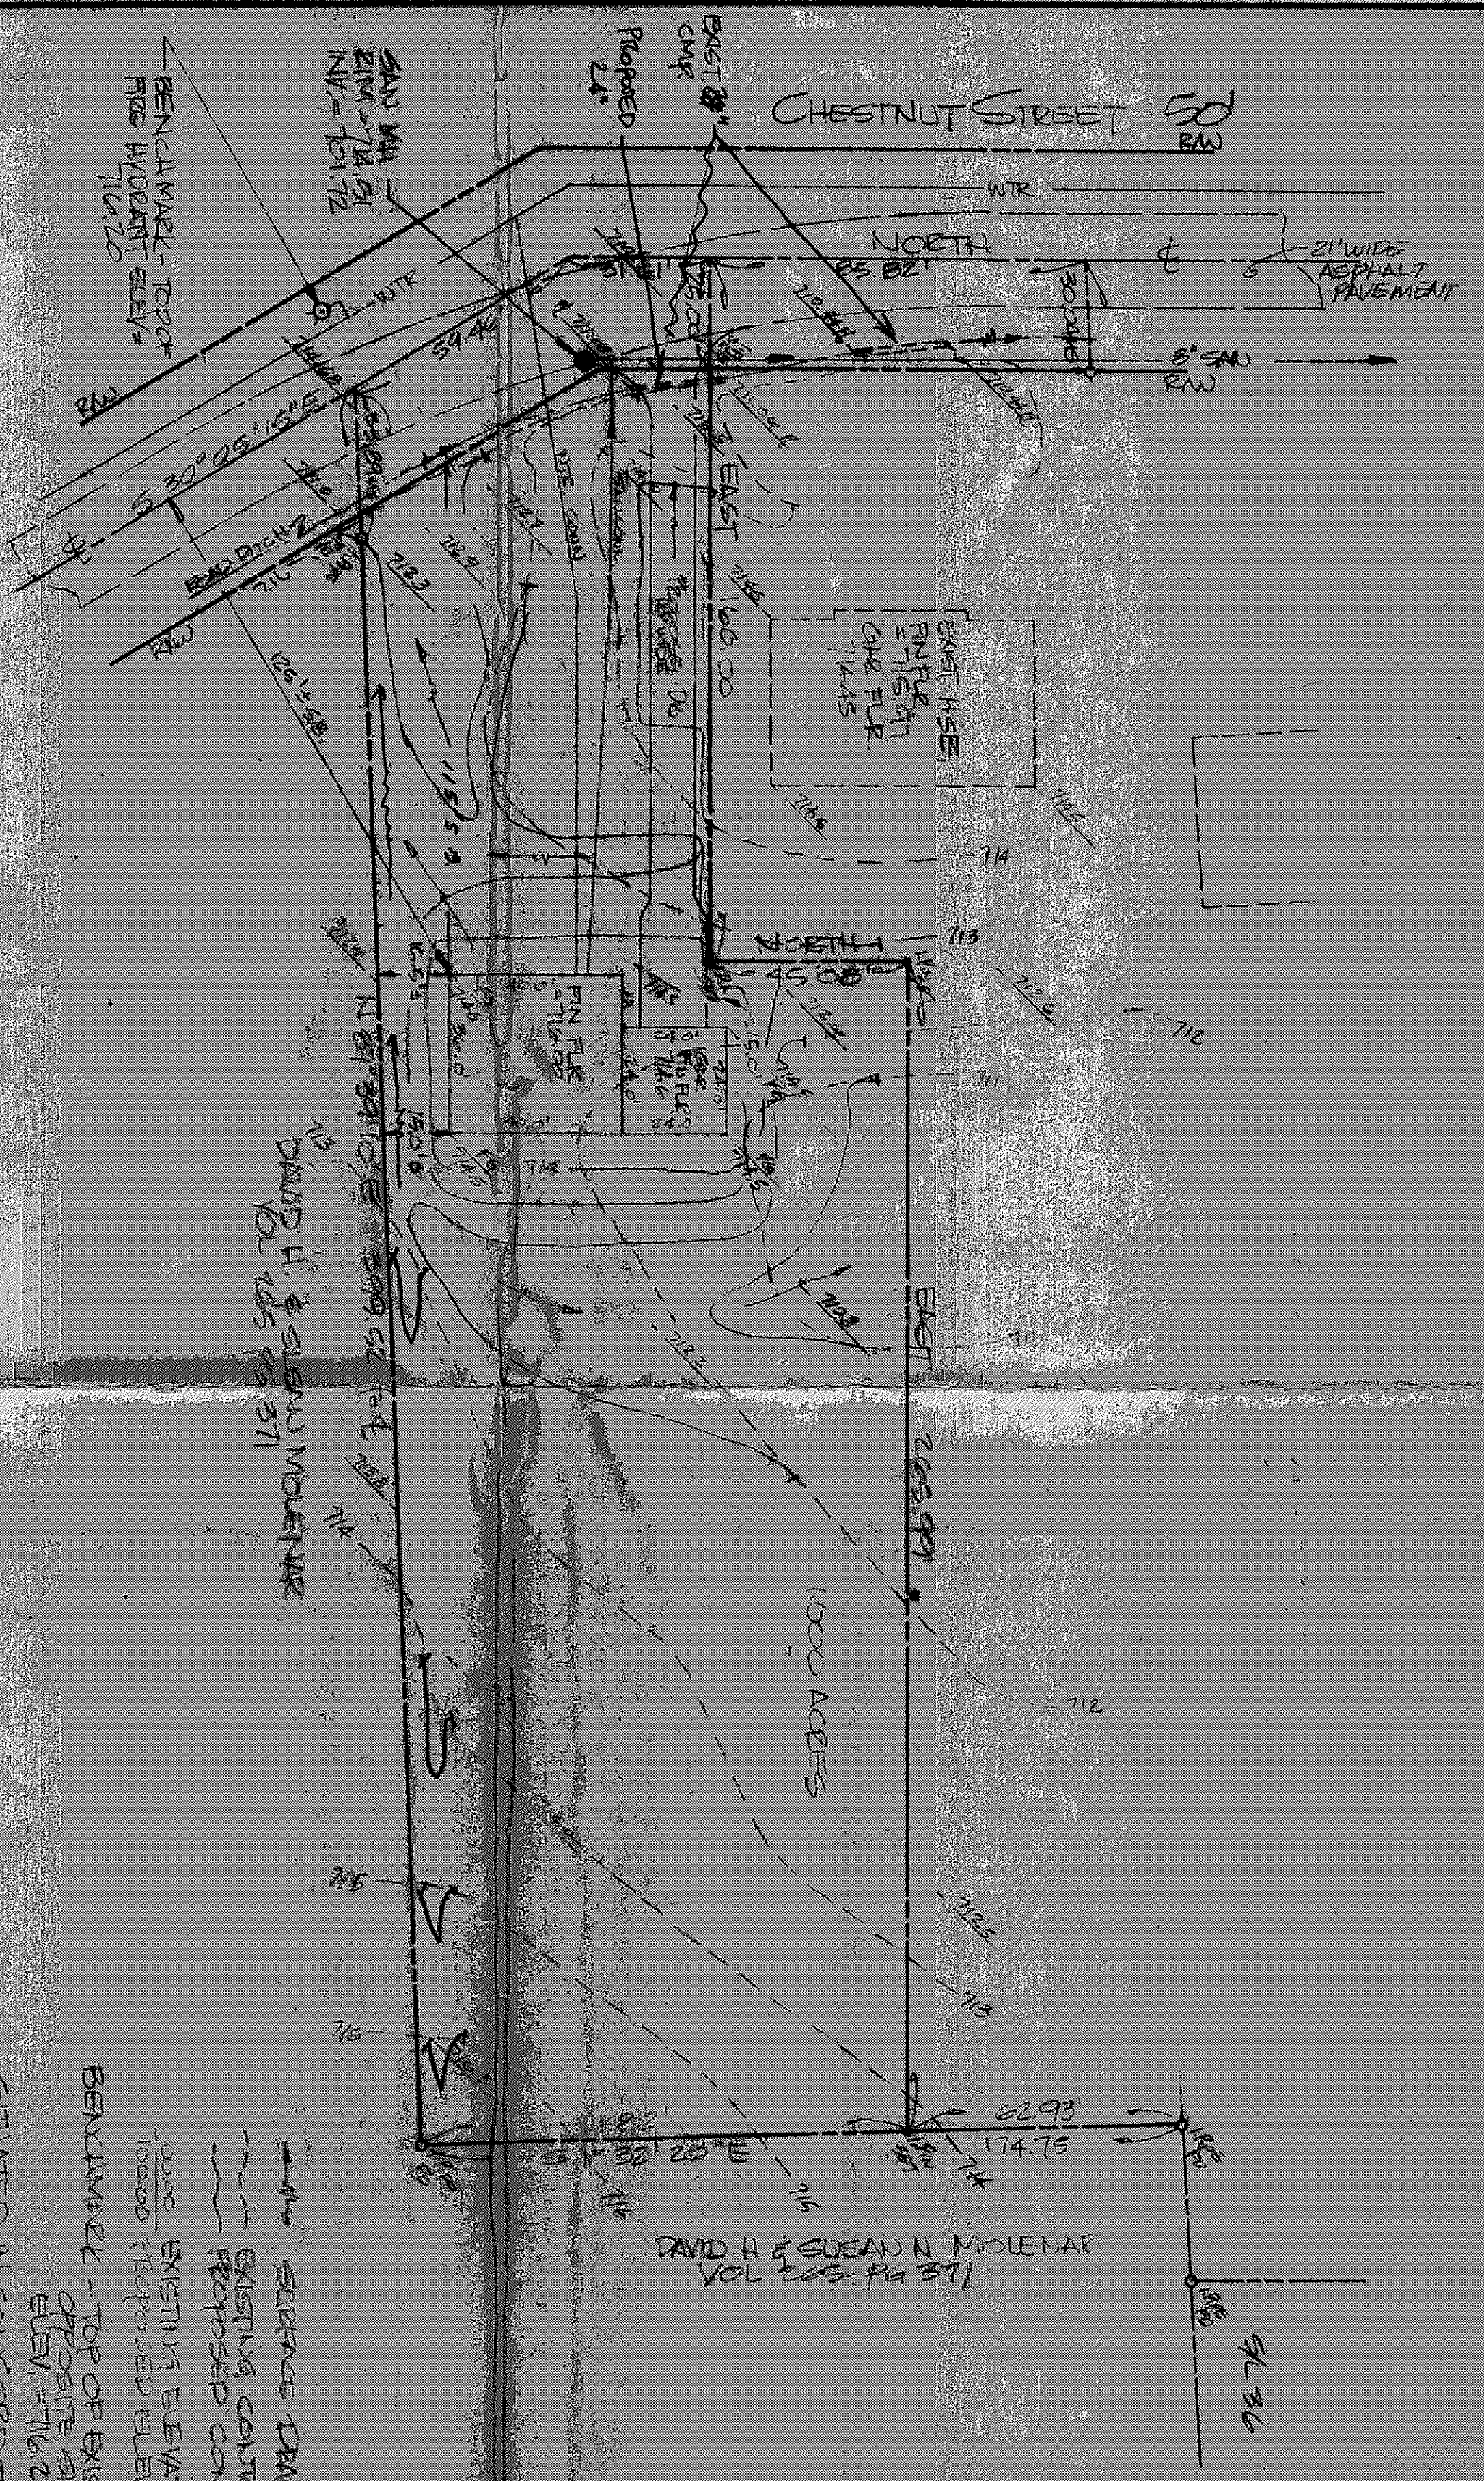



NORTH  
SCALE 1"=30'

ZONING PERMIT #6373  
ISSUED 3-7-90

SUBJECT TO APPROVAL BY:  
☐ Lake County Circuit Court  
☒ Lake County Engineer  
☐ Lake County Planning Comm  
☒ Lake County Eng. Dept

*Don J. Merano*

Grading Plan Approved  
as shown and/or noted  
THOMAS P. GILLES, P.E.  
Lake County Engineer  
Date 3/16/90

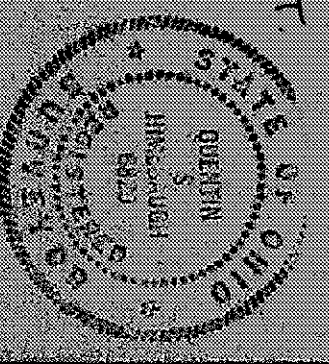

SITE PLAN FOR REHAB BED  
6257 CHESTNUT ST CONDOED TOP

|          |                 |                 |
|----------|-----------------|-----------------|
| DATE     | BY              | CHKD            |
| DEC 1989 | <i>Thompson</i> | <i>Thompson</i> |
| DEC 1989 | <i>Thompson</i> | <i>Thompson</i> |

89.074

THIS PLAN WAS PREPARED BY ME AND IS  
CORRECT TO THE BEST OF MY KNOWLEDGE  
*Don J. Merano* P.E. #1820

BENCHMARK - TOP OF EXISTING FIRE HYDRANT  
OPPOSITE SIDE OF ROAD  
ELEV. = 116.20

2000 EXISTING ELEVATION  
10000 PROPOSED ELEVATION

SURFACE DRAINAGE  
EXISTING CONTOUR  
PROPOSED CONTOUR

SITUATED IN CONVEYED TOWNSHIP PART  
OF LOT NO 54 TRACT 4