




ZONING PERMIT #4871
ISSUED 6-25-84

SUBJECT TO APPROVAL BY:

- ☐ Lake County Sanitary Eng.
☒ Lake County Eng. Dept.
☐ Lake County Planning Comm.
☒ Lake County Bldg. Dept.
Tom J. Mearns

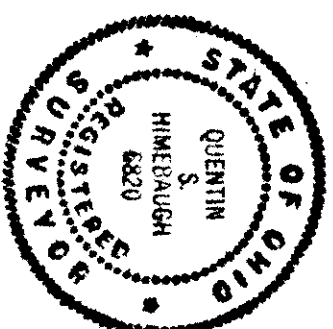

--- Existing Contours
--- Proposed Contours

100.00 Existing Elevation
100.00 Proposed Elevation

Indicates Direction of Surface Drainage

Benchmark - Top Existing Fire Hydrant

Front Proposed S/L =

□ = "As Built" Elevation

This plan was prepared by me and is correct to the best of my knowledge

Donald J. Himebaugh, P.E. #6830

I hereby certify that the above grades are existing finished grades checked in field

#

Grading Plan Approved
as shown and/or noted
by **QUENTIN S. HIMEBAUGH, P.E.**
Professional Engineer

720

25 JUL 84

Permit No. 12-13 Being Part of Lot No. 54
Cincinnati Township - Lake County, Ohio

Location Survey of construction unknown at
this time. City of Cincinnati also provides
this location at later date

Sanitary Sewer to be done in direction of inspection of
lot to Co. Sanitary Engineer name furnished in direction
and inspection of City of Cincinnati.

Site Plan. Permit No. 12-13 (Proposed S/L 415)

Chestnut Street - (Lancaster Township, Lake County, Ohio)

SCALE: 1" = 20' APPROVED BY: **QUENTIN S. HIMEBAUGH**
DATE: 6-18-84 DRAWN BY: **QUENTIN S. HIMEBAUGH**

Plan Prepared by **QUENTIN S. HIMEBAUGH**

WILMINGTON, OHIO 946-1761 DRAWING NUMBER 84-028

SOUTH - 90.00
CHESTNUT STREET - 60'

San. M.H.
Elev. = 711.88
R.B. (N.S.) - 699.81

Virginia B. Woodruff
Vol. 317 pg. 167

George L. & Margaret Henry
Vol. 543 pg. 595

Proposed S/L 7

Proposed S/L 6

Proposed S/L 4

Proposed S/L 3

Proposed S/L 2

S 88° 24' 00" W
269.38 to E

N 0° 01' 30" W
268.42 to E

SWALE

SWALE

Garage
Fin. floor
712.78

House

Pool

House
Garage
Fin. floor
712.67

Garage
Fin. floor
712.50

House

Pool

Garage
Fin. floor
712.50

House

Pool

Garage
Fin. floor
712.50

House

Pool