

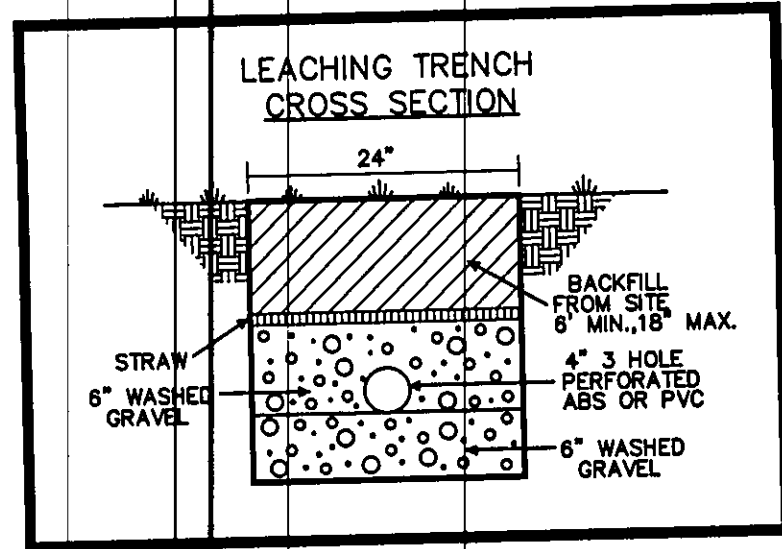


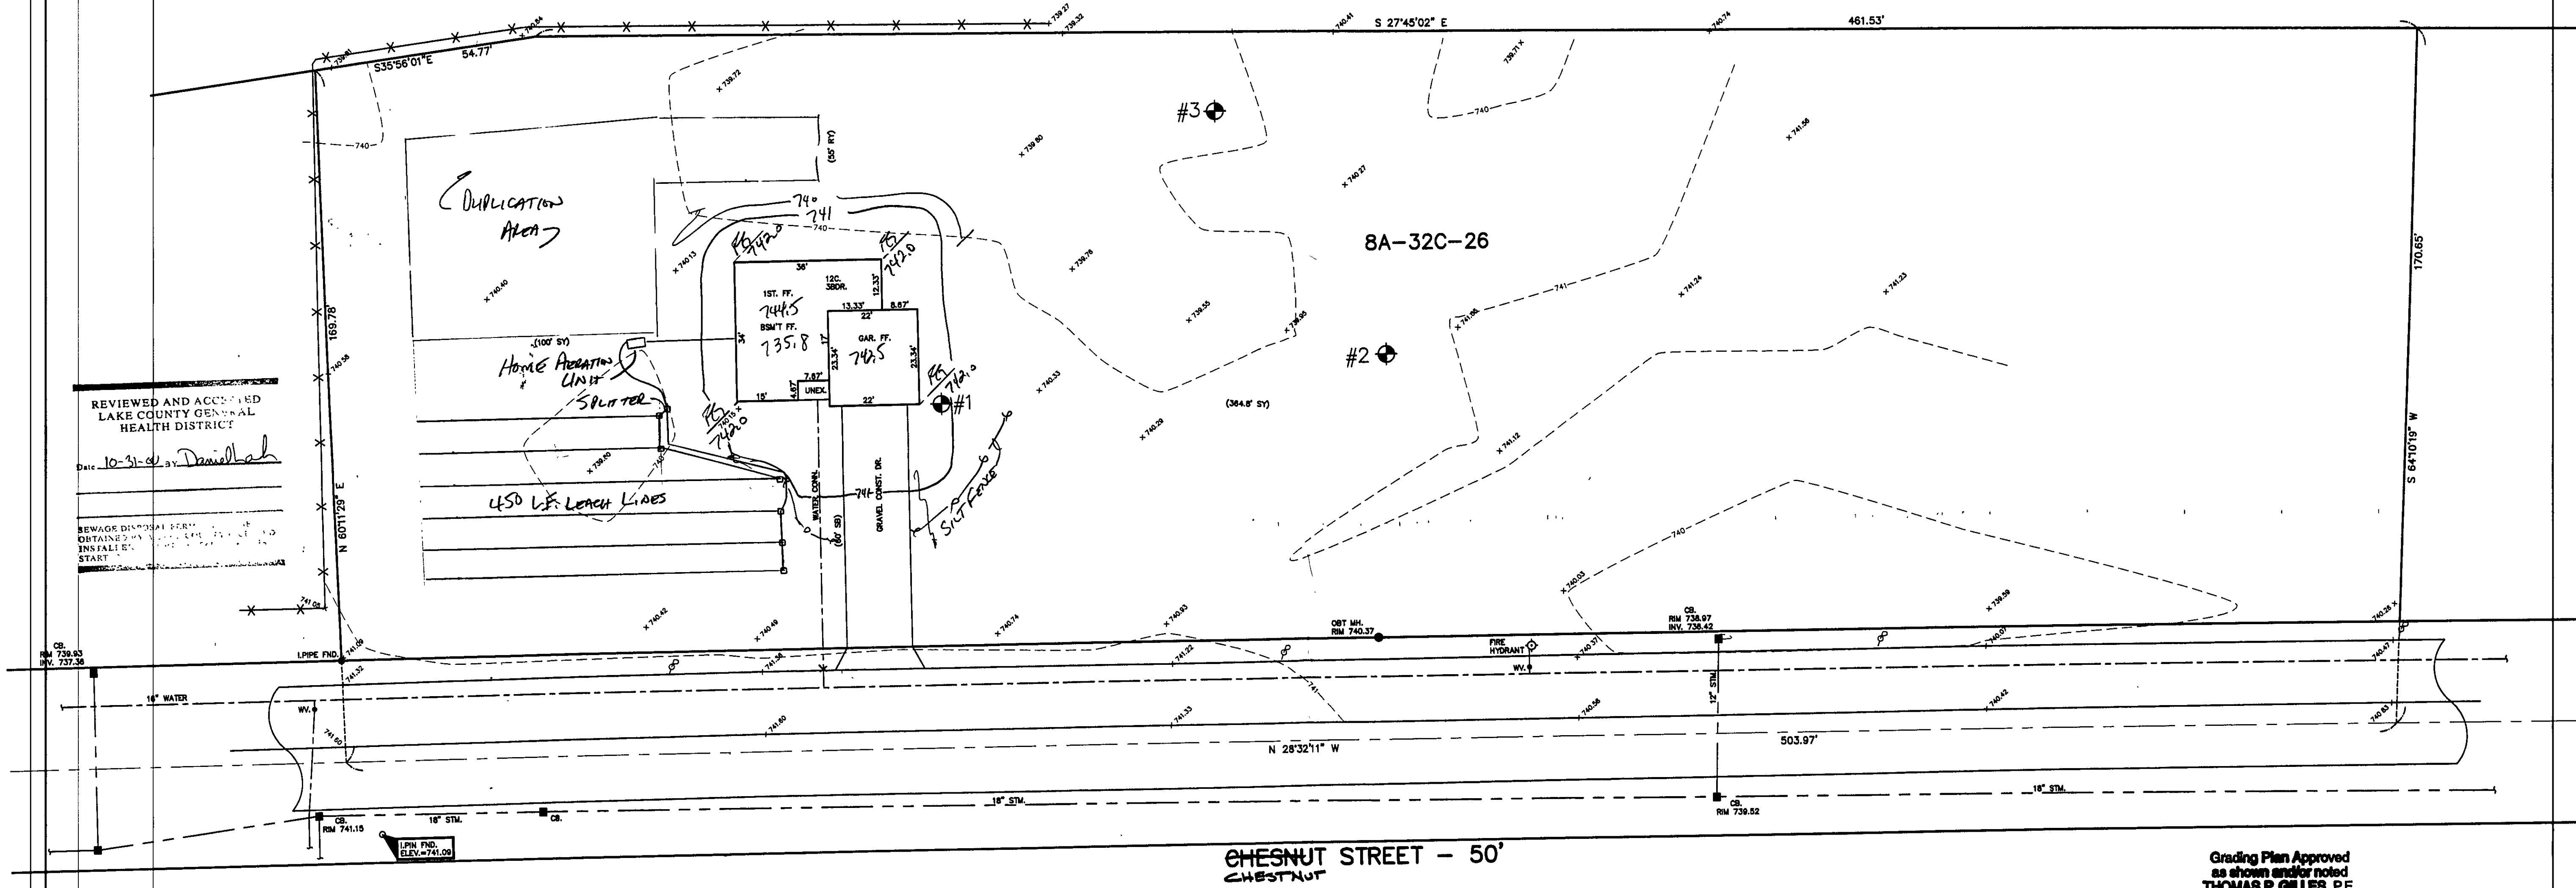


STATE ROUTE 44

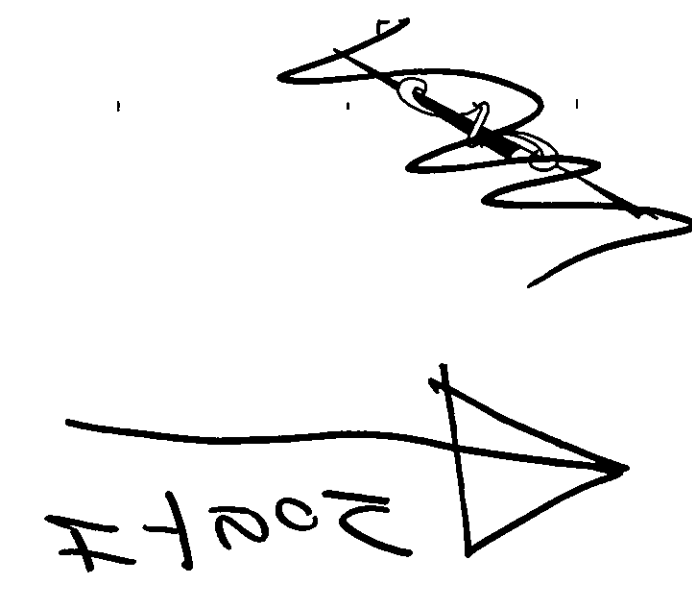

REVIEWED AND APPROVED
LAKE COUNTY GENERAL
HEALTH DISTRICT

Date: 10-31-00 by: *David L. ...*

SEWAGE DISPOSAL SYSTEM
OBTAINED BY ...
INSTALLATION ...
START ...

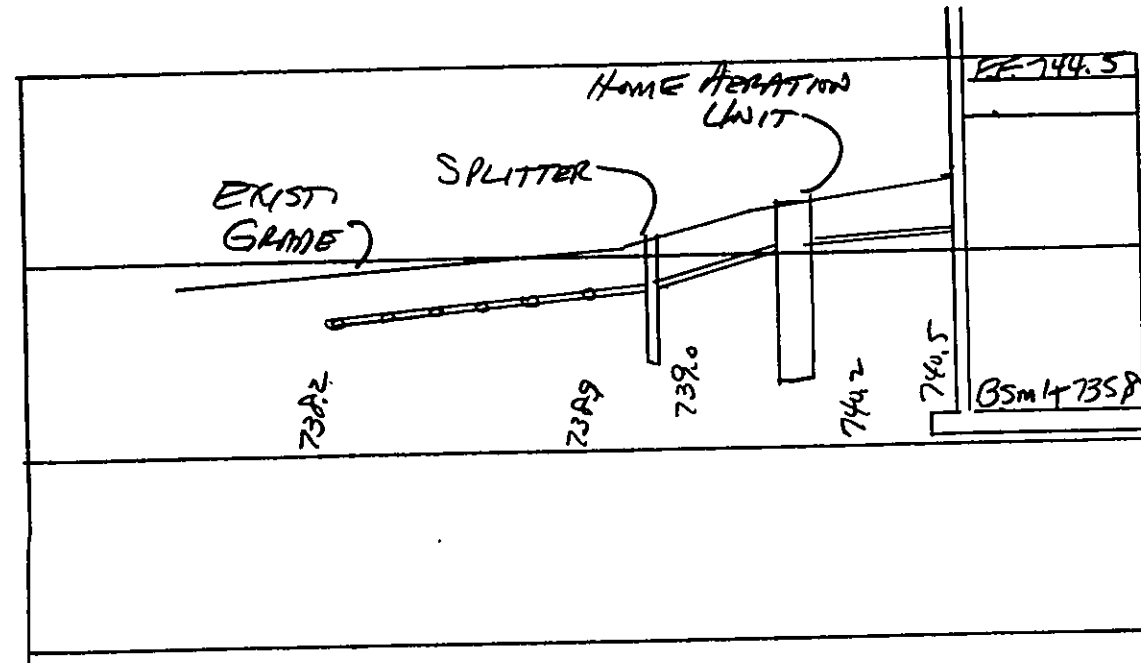

CONCORD TOWNSHIP ZONING OFFICE

ZONING PERMIT # 1000-9975

ISSUED 10/30/2000

SUBJECT TO APPROVAL BY:

- ☐ Lake Co. Sanitary Engineer
- ☒ Lake Co. Eng. Dept.
- ☐ Lake Co. Planning Comm.
- ☒ Lake Co. Building Dept.
- ☒ Lake Co. Soil & Water Cons. Dist.

"I, the undersigned hereby certify that this topography indicated by 6", 1", or 2' contours, and elevations shown hereon represent an actual field survey made by me on the 11th day of Oct, 2000 and that the elevations were taken at appropriate intervals and that as of that date they existed as indicated hereon."

Harry Jones #6343
Name Reg. No.

Grading Plan Approved
as shown and/or noted
THOMAS P. GILLES, P.E.
Lake County Engineer

By TAM Date 11/1/2000

1. A Road Opening will be required for utility work within R/W

2. ROOF DRAINS SHALL DISCHARGE TO SPLASH BLOCKS.

From the Lake County Engineer

REV NO.	DESCRIPTION	DATE	BY	CHK'D

bj BABCOCK, JONES AND ASSOCIATES, INC
CIVIL ENGINEERS - SURVEYORS - LAND PLANNERS
PAINESVILLE OHIO 44077

DATE 10/11/00
DESIGN BY H.J.
DRAWN BY T.R.
APPROVED BY H.J.

SITE PLAN
FOR
JOSEPH FARINA

CONCORD TOWNSHIP LAKE COUNTY

SCALE: 1"=20'

JOB NO 00-250

SHEET 1 OF 1

STATE OF OHIO
HARRY S. JONES, JR.
S-6543
PROFESSIONAL SURVEYOR