

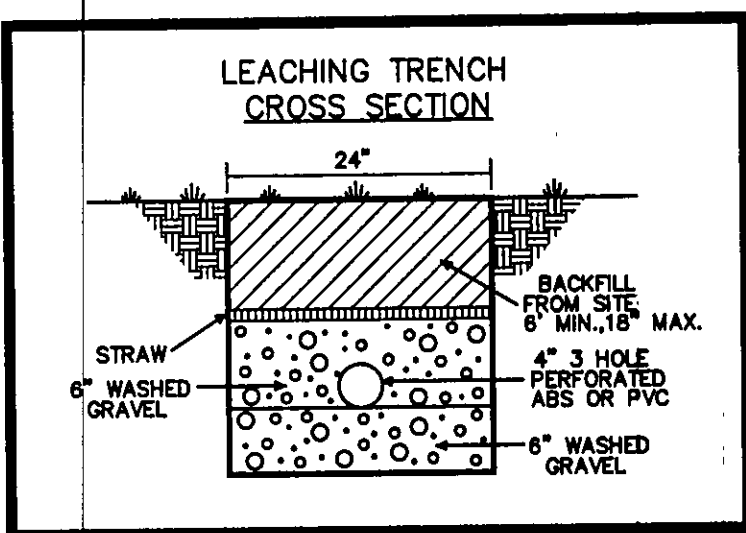
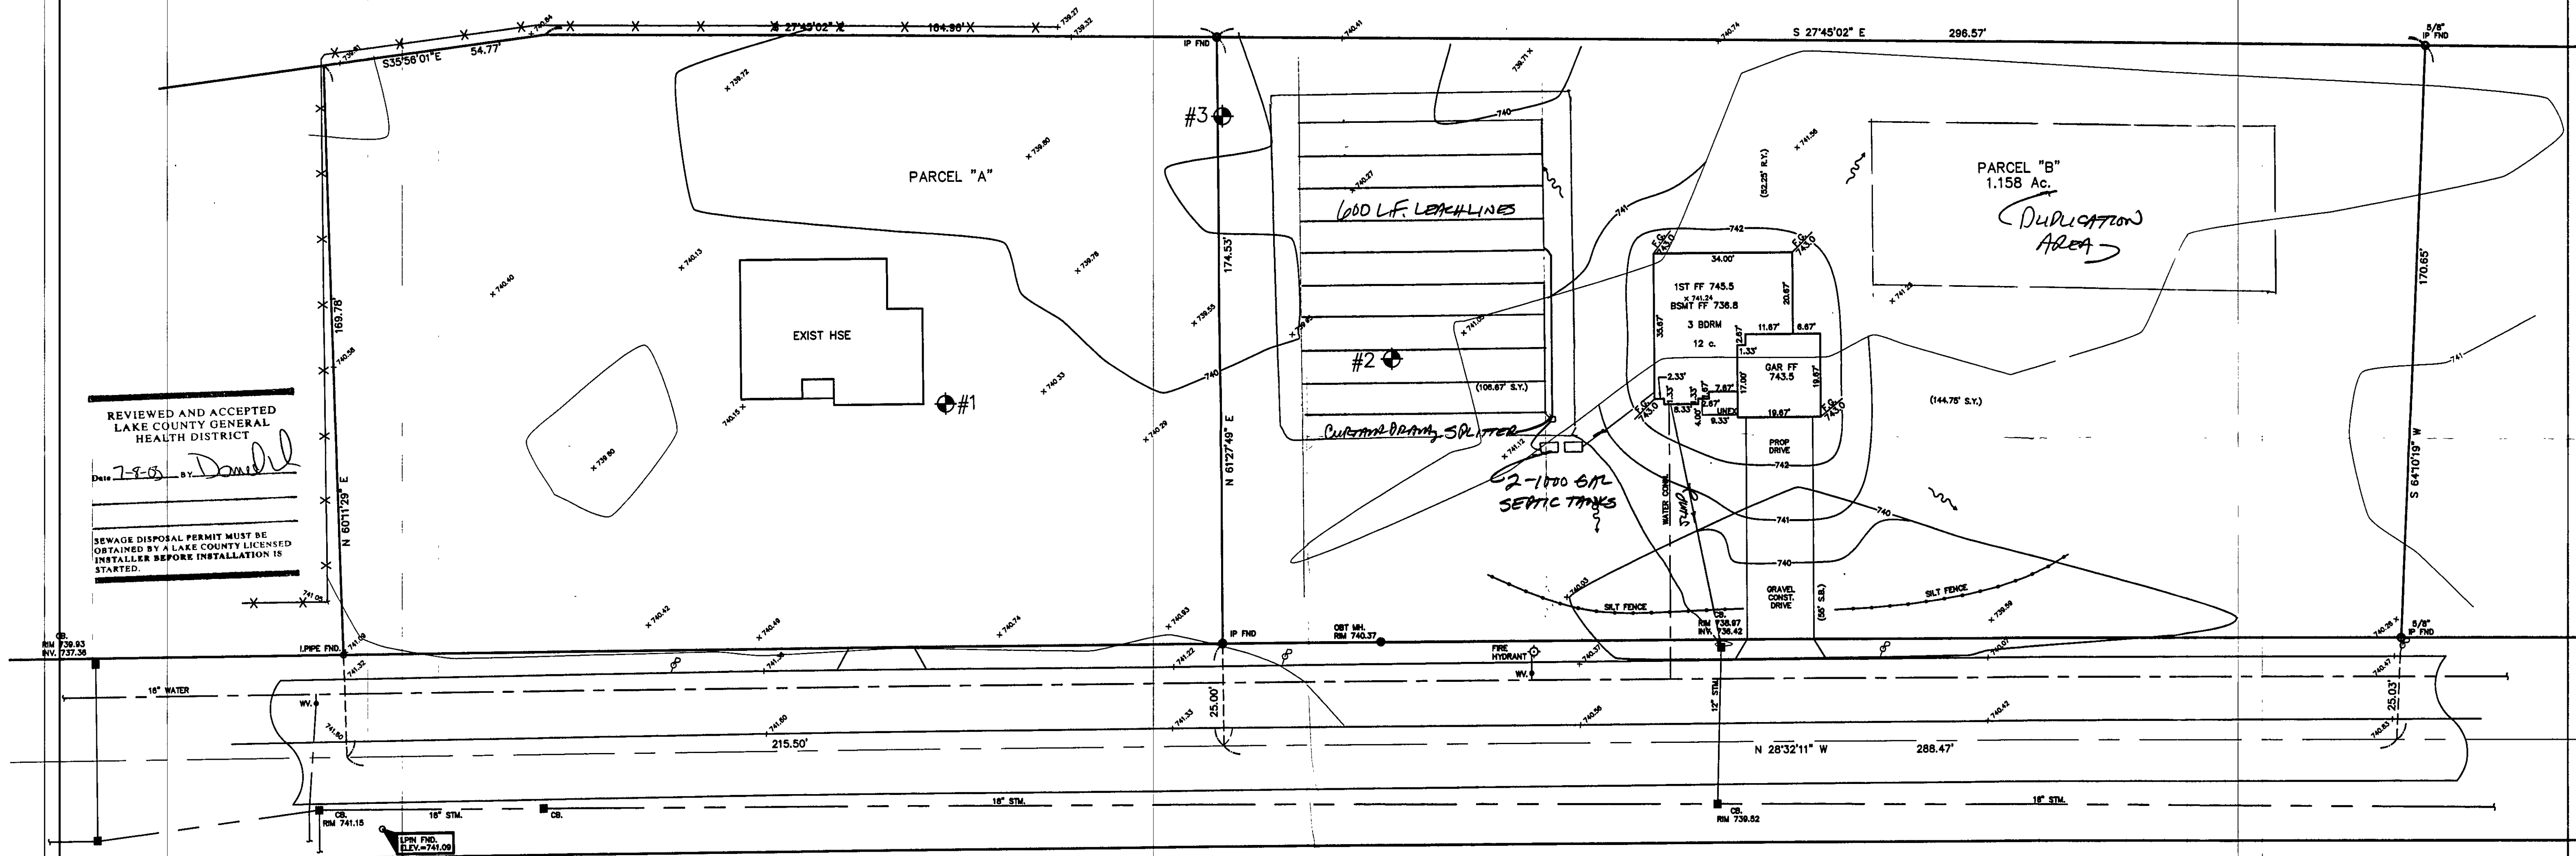


STATE ROUTE 44

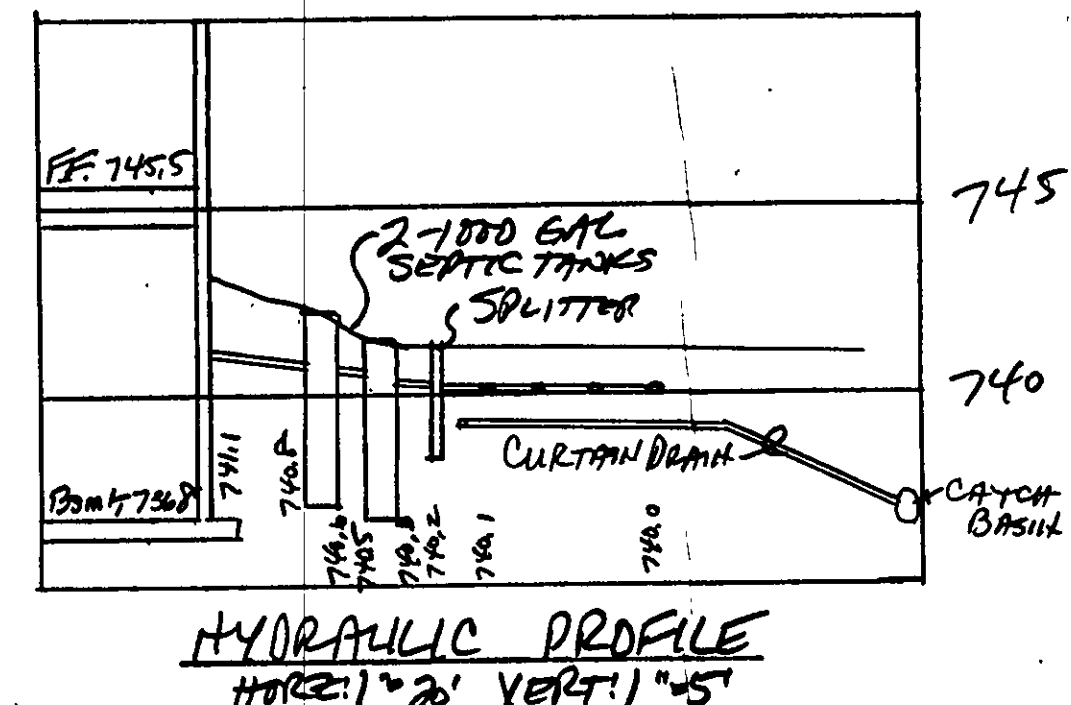

REVIEWED AND ACCEPTED
LAKE COUNTY GENERAL
HEALTH DISTRICT
Date 7-9-03 by [Signature]
SEWAGE DISPOSAL PERMIT MUST BE
OBTAINED BY A LAKE COUNTY LICENSED
INSTALLER BEFORE INSTALLATION IS
STARTED.

"I, the undersigned hereby certify that this topography indicated by 6", 1", or 2" contours, and elevations shown hereon represent an actual field survey made by me on the 18th day of Feb. 20 03 and that the elevations were taken at appropriate intervals and that as of that date they existed as indicated hereon."
Name [Signature] Reg. No. 6343

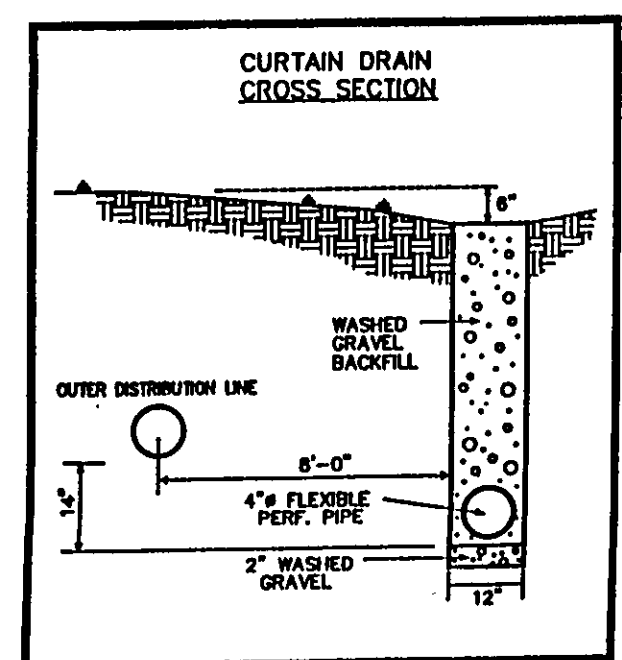

CHESTNUT STREET - 50'

Grading Plan Approved
as shown and/or noted
JAMES R. GILLS, P.E.
Lake County Engineer
By [Signature] Date 7/16/03

This project is exempt from
ESC Plan Review
Date 7-9-03
Lake SWCD [Signature]
TBM - IRON PIN
ELEV - 741.09

EXISTING UTILITIES NOTE:
THE SIZE AND LOCATION, BOTH HORIZONTAL AND VERTICAL
OF THE UNDERGROUND UTILITIES SHOWN HEREON, HAVE BEEN
OBTAINED BY A SEARCH OF AVAILABLE RECORDS.
VERIFICATION BY FIELD OBSERVATION HAS BEEN CONDUCTED
WHERE PRACTICAL. HOWEVER, BABCOCK, JONES AND ASSOCIATES
INC. DOES NOT GUARANTEE THE COMPLETENESS NOR ACCURACY
THEREOF.



REV NO.	DESCRIPTION	DATE	BY	CHK'D
1	REVISED HOUSE LOCATION	6/30/03	B.P.	H.J.
2	ADDED CURTAIN DRAIN	7/2/03	HJ	HJ

bj BABCOCK, JONES AND ASSOCIATES, INC
CIVIL ENGINEERS - SURVEYORS - LAND PLANNERS
PAINESVILLE OHIO 44077

DATE	6/26/03
DESIGN BY	H.J.
DRAWN BY	B.P.
APPROVED BY	H.J.

SITE PLAN
FOR
JOSEPH FARINA
LOT No. 48, TACT No. 4
LAKE COUNTY STATE OF OHIO
CONCORD TOWNSHIP

SCALE	1"=20'
SHEET NO.	00-250-B
OF	1