

SITE PLAN

COLUMBIA COUNTY, OHIO

for: KAY HEWES OWNER
HELBELLY DR. N. 1/2 1/4 4000
 ADDRESS: HELBELLY DR. N. 1/2 1/4 4000
 CITY: WILSON ZIP: 45390

Subdivision: 37 NAME: COLLEEN DR.
 LOT: 37 VOLUME: 0.505 AC. TRACT: 37
 SUBLOT NO.: 37 PERM. PARCEL NO.: 37 STREET: COLLEEN DR.

LEGEND	
SANITARY MANHOLE	WATER VALVE (GAS)
STORM MANHOLE	WATER METER (GAS)
INLET OR CATCH BASIN	AS BUILT ELEVATION
HYDRANT	INDICATES DIRECTION OF SURFACE DRAINAGE
EXISTING CONTOURS	
PROPOSED CONTOURS	
EXIST. ELEV. 100.0	
PROG. ELEV. 100.0	

REMARKS
 ALL BOUNDARY DATA SHOWN WAS OBTAINED FROM IDEOS, RECORDED
 SUBDIVISION PLAT ON OTHER PUBLIC RECORDS.
 LOCATIONS AS SHOWN OF ADJACENT WELLS AND SEPTIC TANKS OBTAINED FROM
 LAKE COUNTY HEALTH DEPARTMENT

DESIGN CERTIFICATION
 THIS PLAT WAS PREPARED BY ME, AND IS CORRECT
 TO THE BEST OF MY KNOWLEDGE AND BELIEF
 NAME: THOMAS P. GILLES SURVEYOR REGISTRATION NO. 6343

CHECK LIST	
NO. OF BEDROOMS	WATER MAIN SIZE, LOCATION
BATHS	SAN. SEWER SIZE, GR. LOC.
NO. OF NEAREST STREET	SAN. MH. CAST. ELEV. INV. ELEV.
SUBLOT NO. PARCEL NO.	SAN. CONN. SIZE, LOC. DEPTH
SURROUNDING OWNERS	STORM SEWER SIZE, GR. LOC.
BLDG. DIMENSIONS FIN. GR.	STORM MH. CAST. ELEV. INV. ELEV.
BLDG. TIES PL. N. GRADES	PAV. TYPE GRADE CURVES
APPROX. TYPE WIDTH THICKNESS	DAYLINE LOC. SIZE PRESSURE
SEPTIC TANK LOCATION, CAPACITY	SEPTIC TANK LOCATION, CAPACITY
WELL LOCATION	WELL LOCATION
ROCK OUTCROPPINGS	ISOLATION RADIUS FROM WELL


REVISIONS	
NO.	DATE BY
1	
2	
3	
4	
5	

PLAN PREPARED BY:
BABCOCK • JONES & ASSOCIATES, INC.
 PAINESVILLE, OHIO
 DRAWN BY: TH SCALE: 1" = 30' PHONE NO. 357-1811
 CHK'D. TH DATE: 12/13/83 DRAWING NO. 83-172
 CDR. TH APP'D. TH

"AS BUILT" CERTIFICATION
 I, HEREBY CERTIFY THAT THE CIRCLED GRADES ARE EXISTING
 FINISH GRADES CHECKED IN THE FIELD ON 19
 AND ARE CORRECT TO THE BEST OF MY KNOWLEDGE AND BELIEF.

REGISTERED SURVEYOR REG. NO. 720
 DATE: 12-5-83
 ZONING PERMIT # 4770
 ISSUED: 12-5-83

SUBJECT TO APPROVAL BY:
☒ Lake County Sanitary Eng.
☒ Lake County Eng. Dept.
☒ Lake County Planning Comm.
☒ Lake County Eng. Dept.
Tom & Marlene

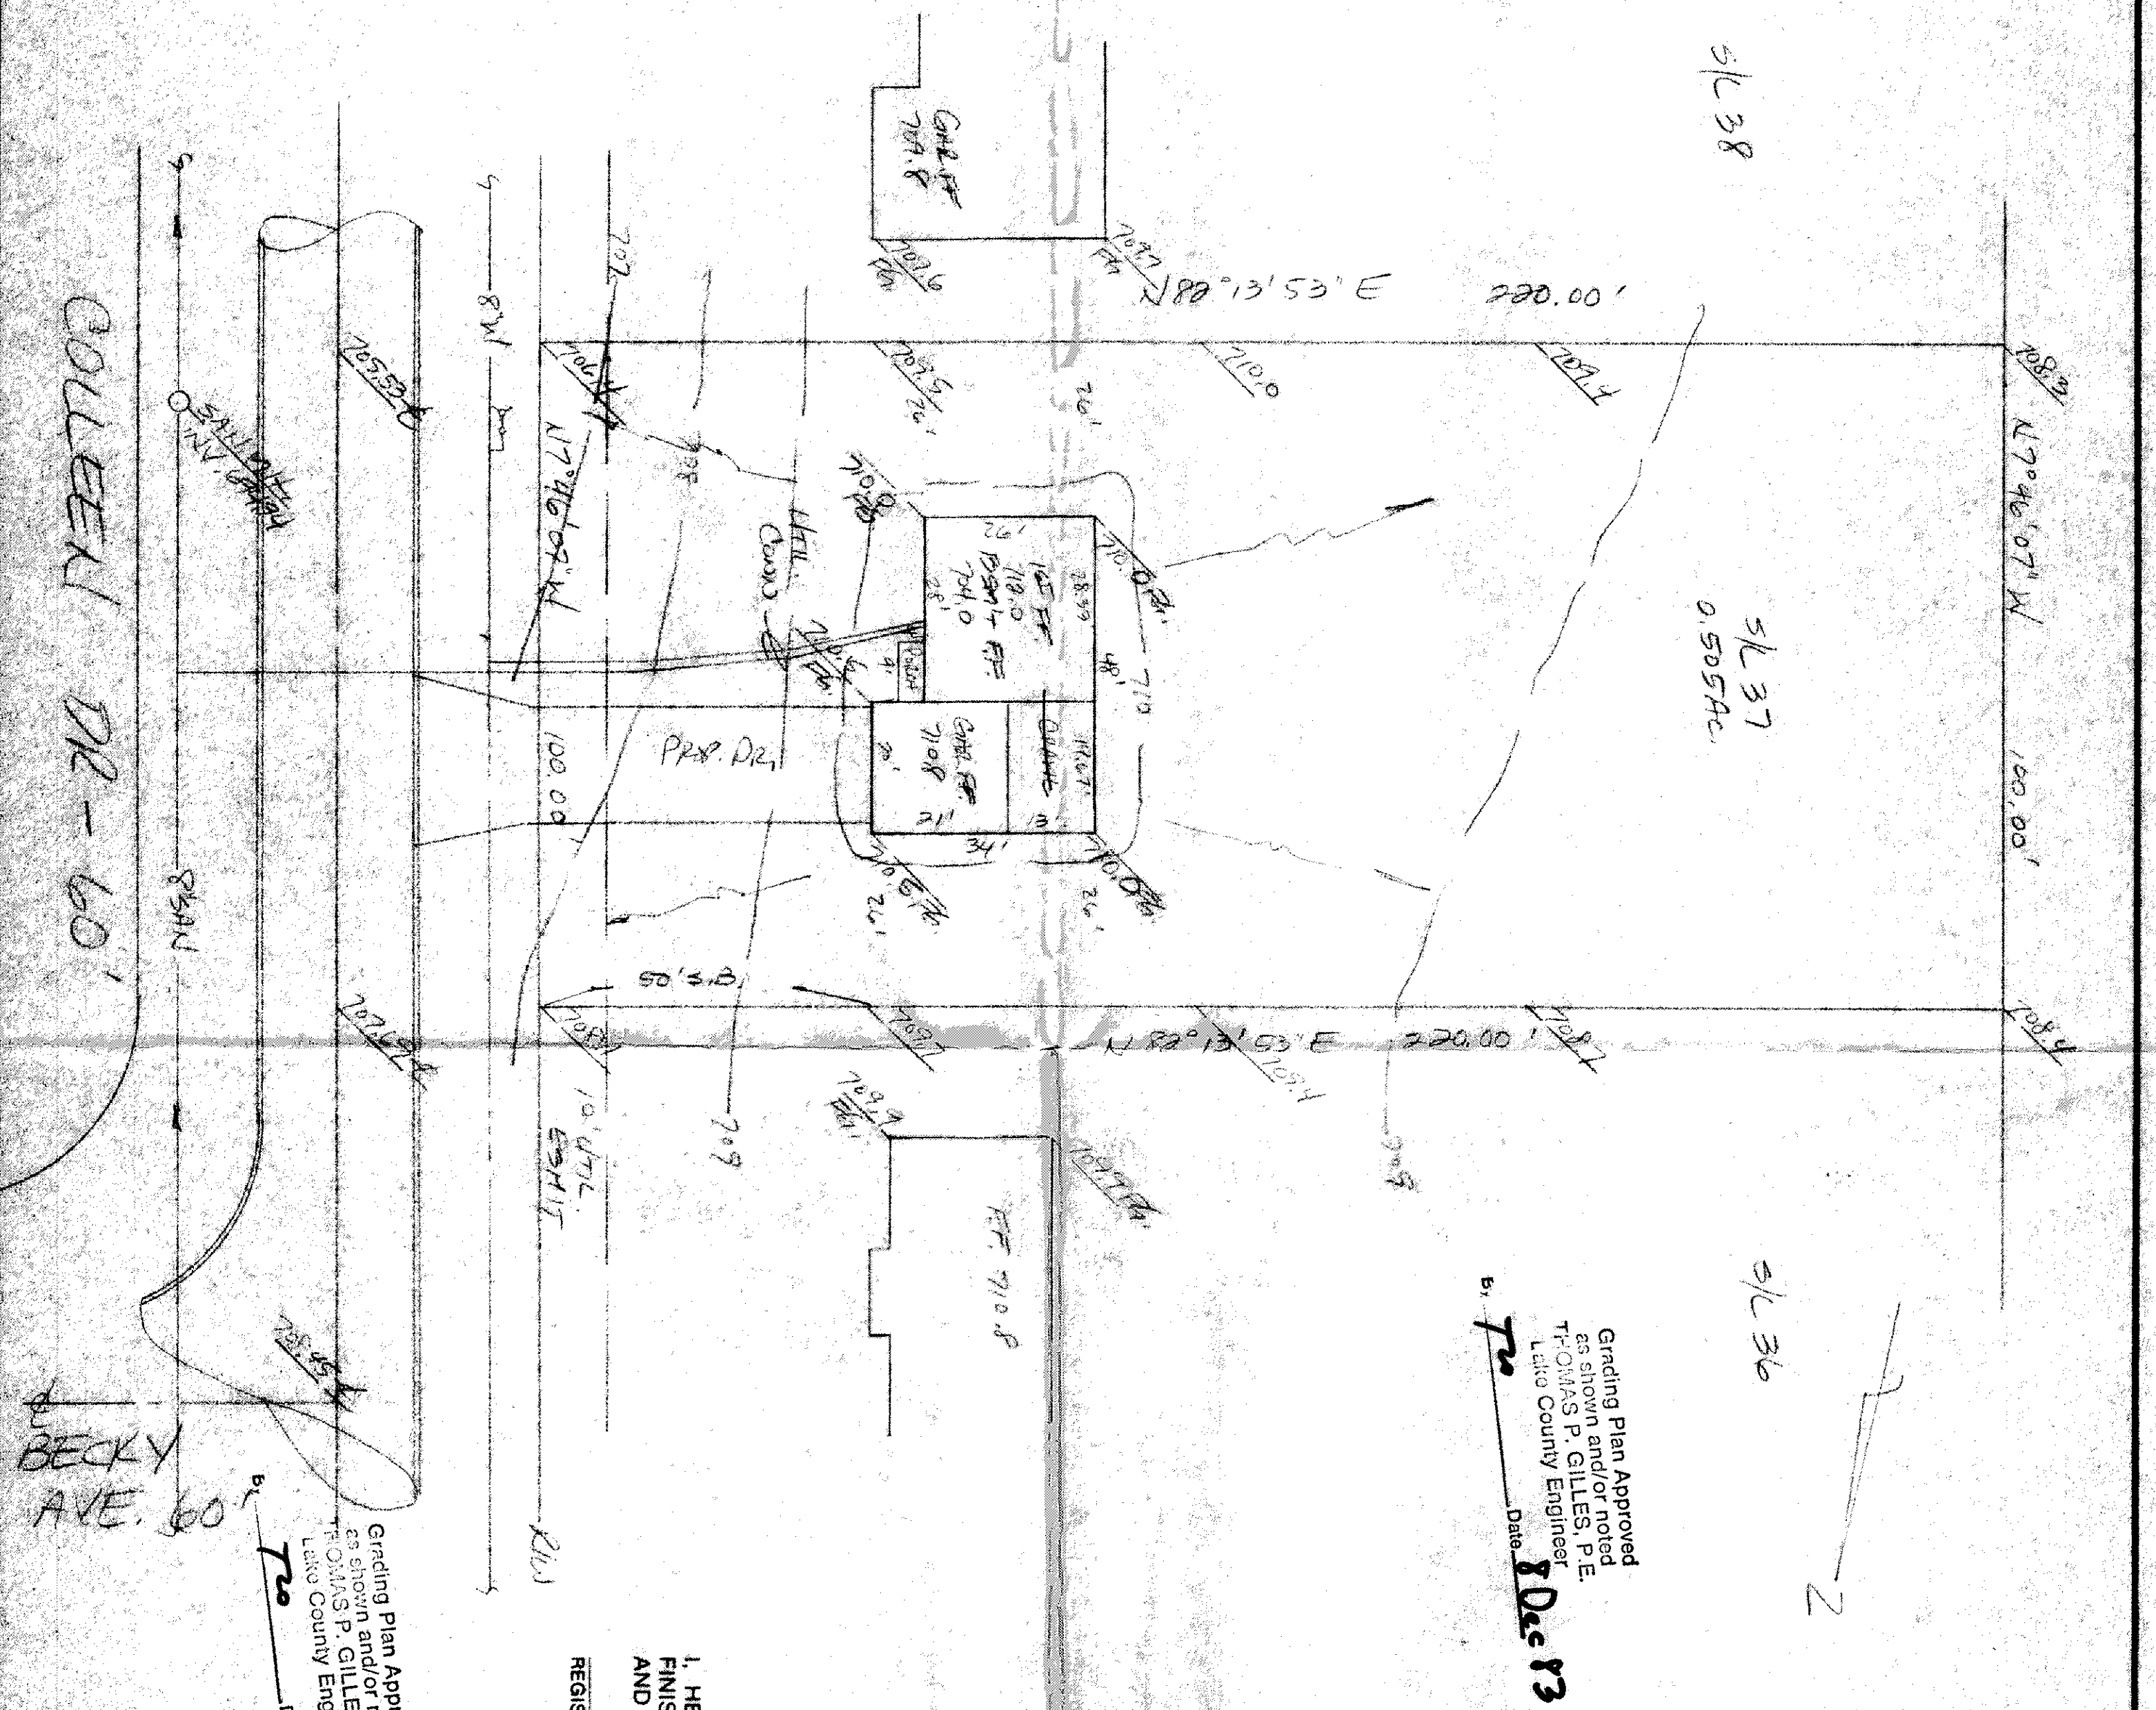

Grading Plan Approved
 as shown and/or noted
 THOMAS P. GILLES, P.E.
 Lake County Engineer
 Date: 12-5-83

Grading Plan Approved
 as shown and/or noted
 THOMAS P. GILLES, P.E.
 Lake County Engineer
 Date: 12-5-83

COLLEEN DR - 60'

BECKY AVE. 60'