



DRAWING NUMBER	
THIS PLAT WAS PREPARED BY ME AND IS ACCURATE TO THE BEST OF MY KNOWLEDGE AND BELIEF	
DATE: July 6, 1993	APPROVED BY: <i>M</i>
BEING S/L 38 CONCORD-KELOSSE EST., CONCORD TWP., OHIO	
CROOKSHANK SITE PLAN	

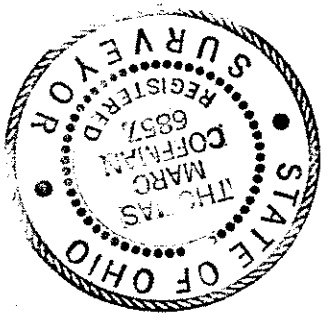

Grading Plan Approved as shown and/or noted
 THOMAS P. GILLES, P.E.
 Lake County Engineer
 Date: 12/1/93

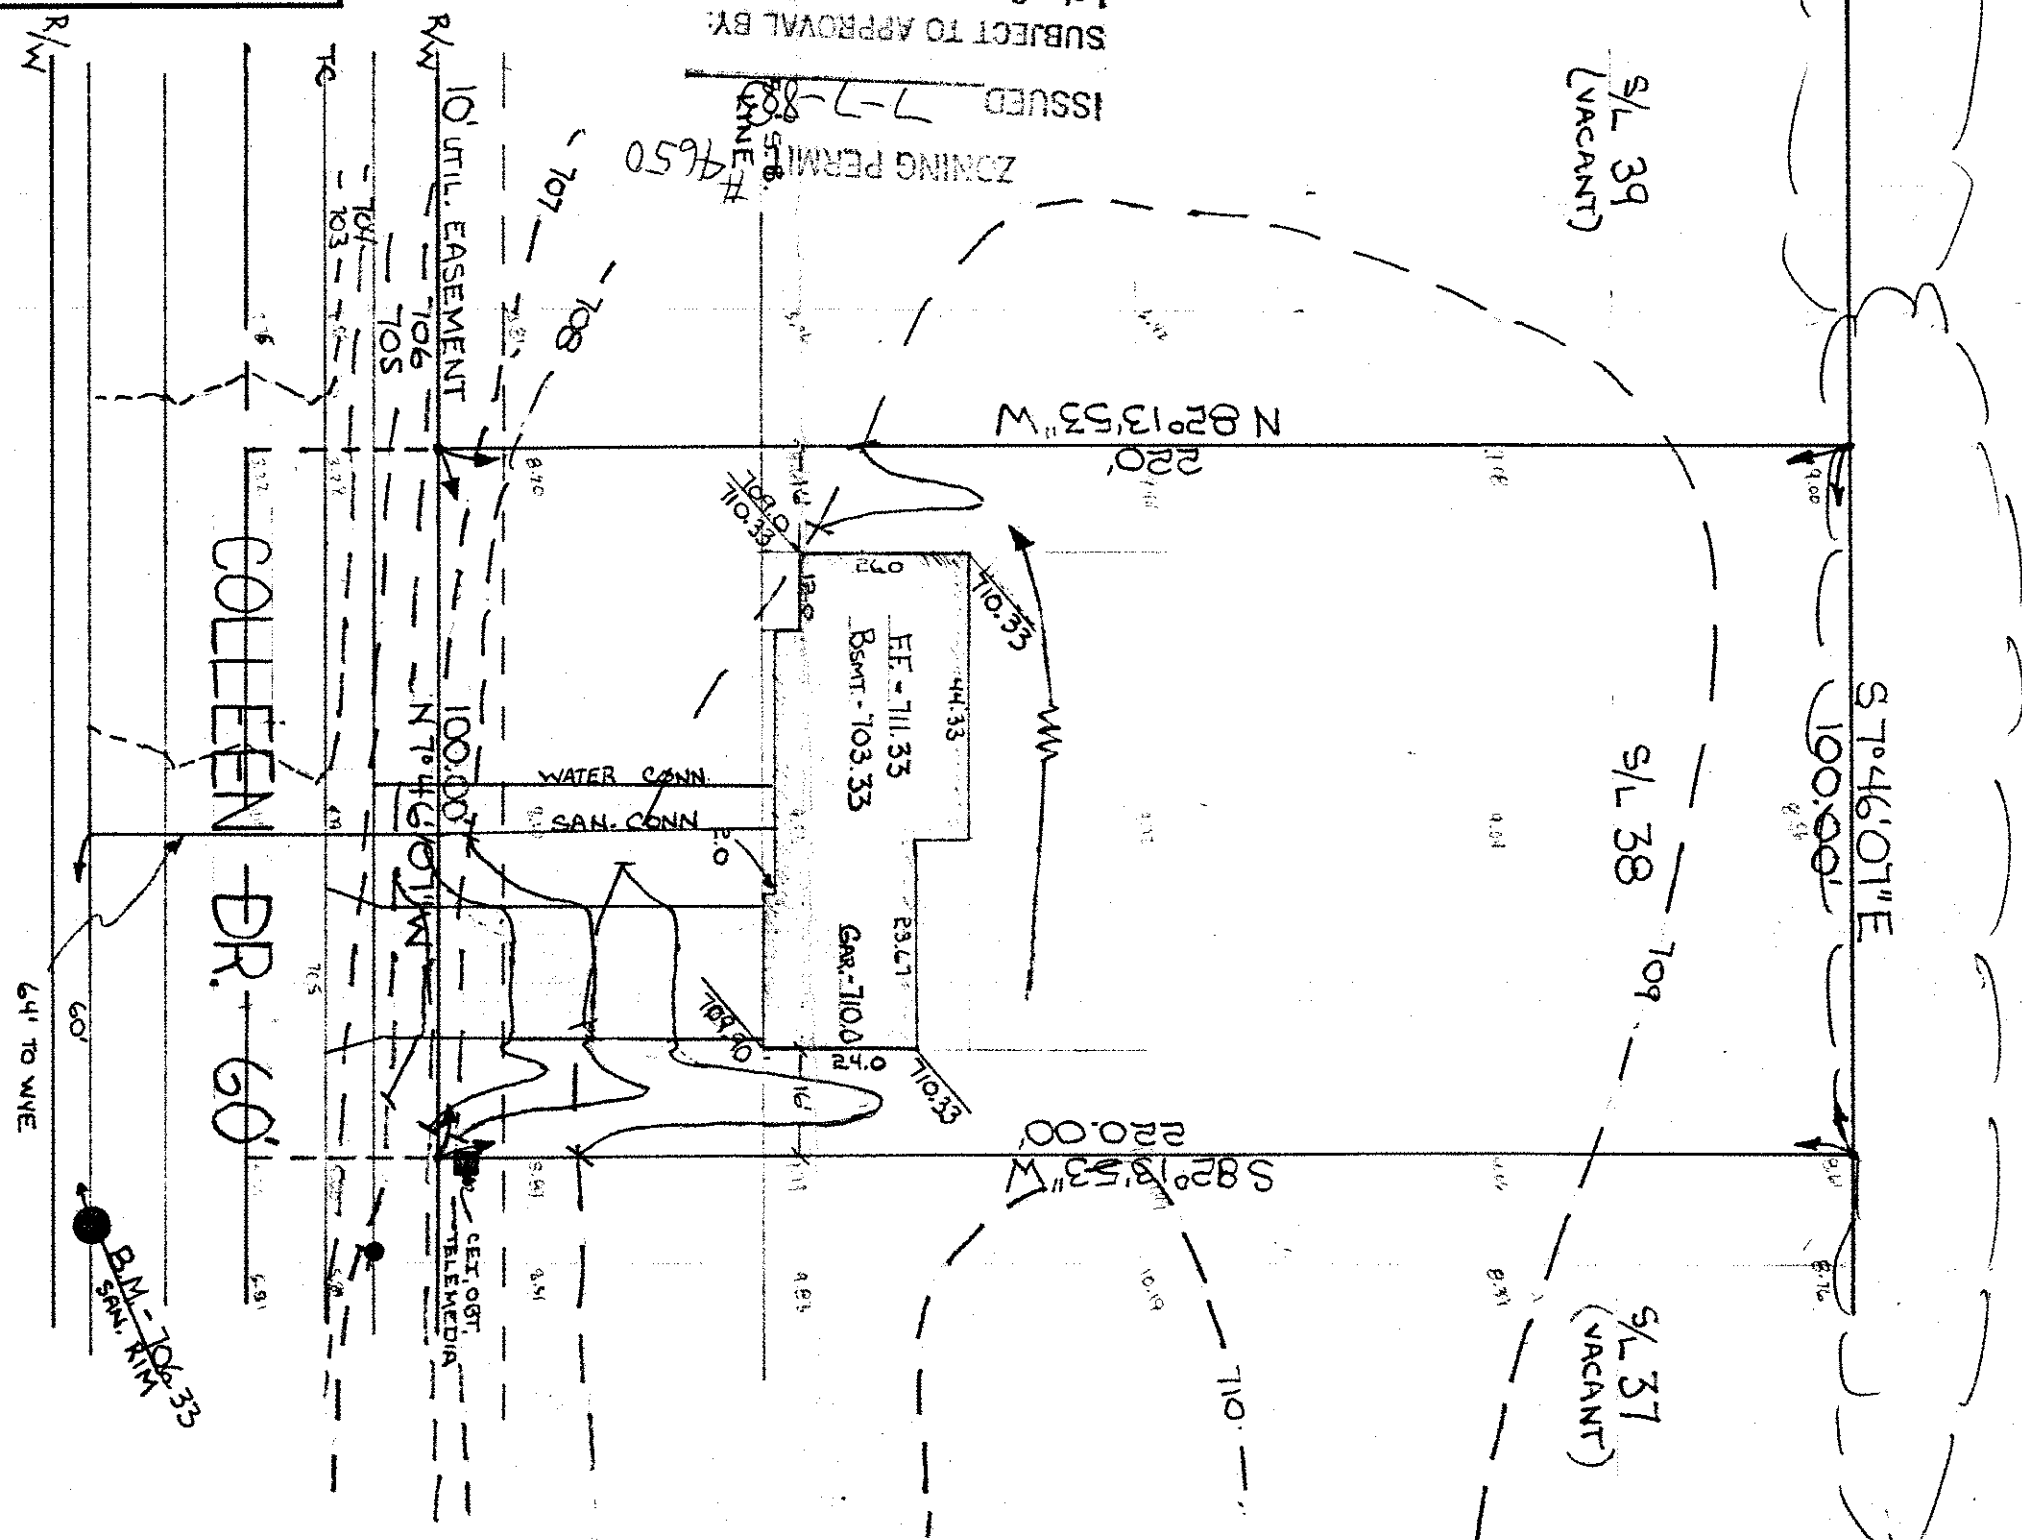

ISSUED 7-7-88
 ZONING PERMIT #4650
 SUBJECT TO APPROVAL BY:
☒ Lake County Sanitary Eng.
☒ Lake County Eng. Dept.
☒ Lake County Planning Comm.
☒ Lake County Bldg. Dept.
Tom & Marcia