

ZONING PERMIT #0

ISSUED 7-26-83

SUBJECT TO APPROVAL BY:
Lake County Sanitary Eng. ☐
Lake County Eng. Dept. ☒
Lake County Planning Comm. ☐
Lake County Bldg. Dept. ☒
Teno J Marano

CURVE DATA
R = 400.49
Δ = 3° 43' 19"
T = 14.96'
A = 29.91'
C = 29.90'
N 7° 46' 36" W



Grading Plan Approved
as shown and/or noted
THOMAS P. GILLES, P.E.
Lake County Engineer

By Tuo Date 1 Aug 83

CHERYL DRIVE 60'

NORTH
1" = 30'

TOM REED GENERAL CONTRACTING INC.
VOL. 832 Pgs 930
934
936

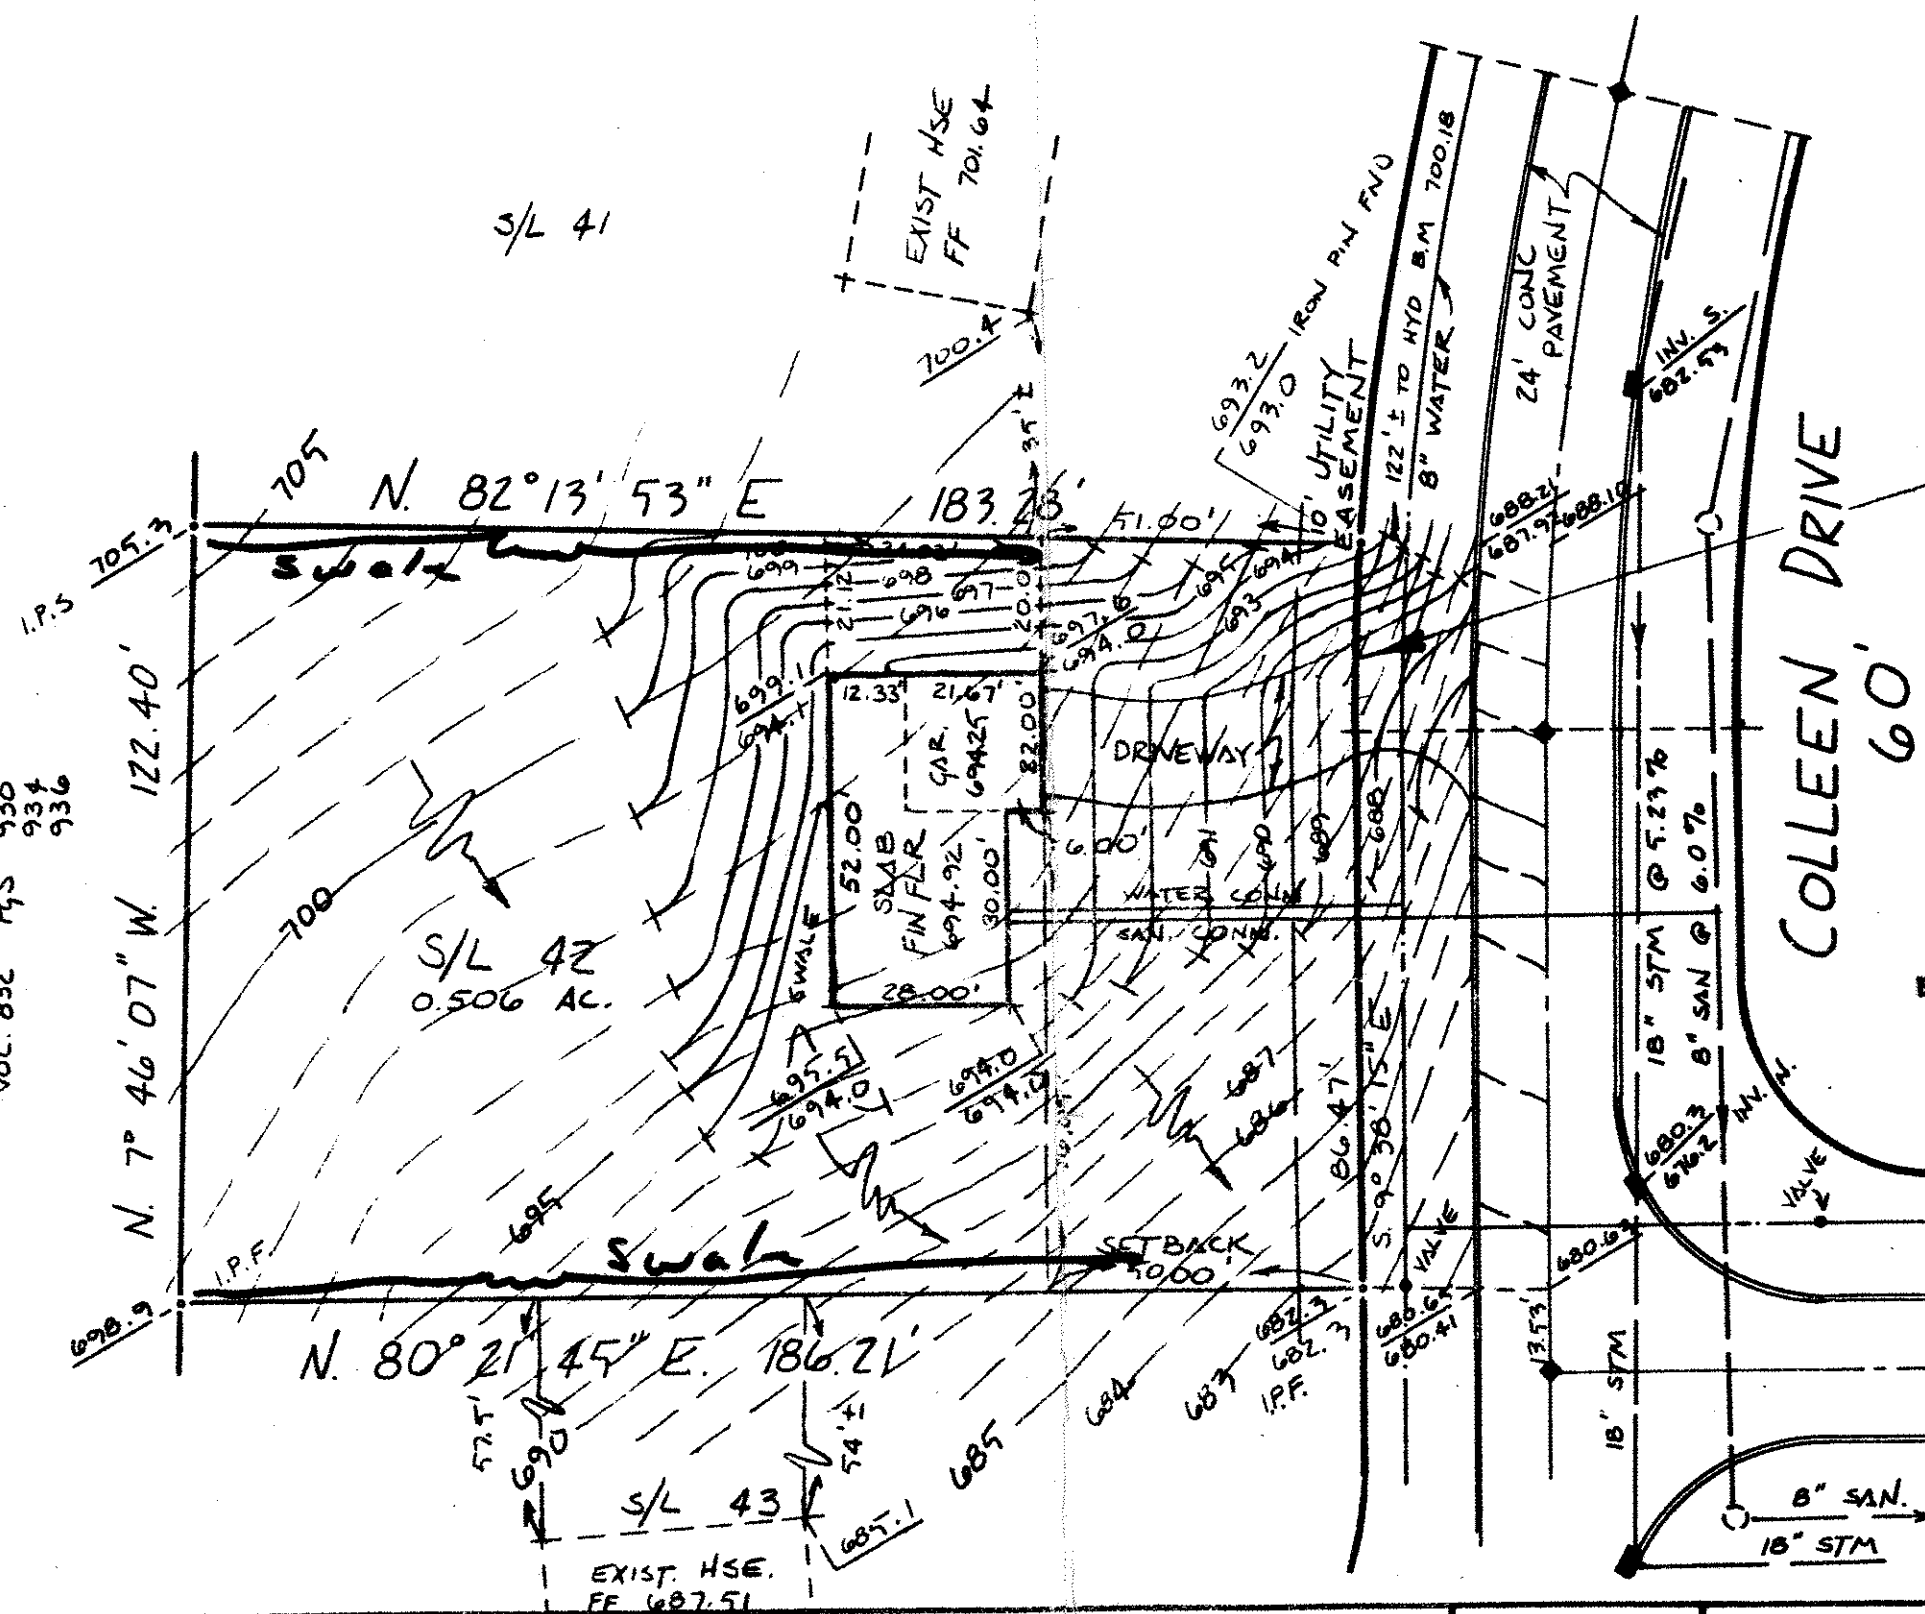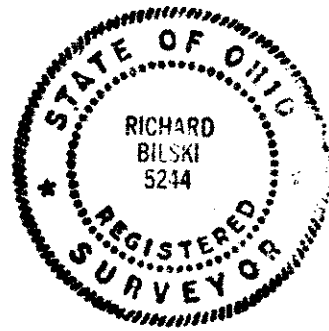

DESIGN CERTIFICATION

THIS PLAT WAS PREPARED BY ME, AND IS CORRECT TO THE BEST OF MY KNOWLEDGE AND BELIEF.

[Signature]
REG. SURVEYOR NO. PS# 5244

AS BUILT CERTIFICATION

I HEREBY CERTIFY THAT THE CIRCLED GRADES ARE EXISTING FINISH GRADES CHECKED IN THE FIELD ON _____ AND THAT SURVEY IS CORRECT TO THE BEST OF MY KNOWLEDGE AND BELIEF.

REG. SURVEYOR NO. _____



COLPETZER · WOODS
CONSULTANTS, INC.

9470 MENTOR AVENUE • MENTOR, OHIO 44060 • (216) 357-7569

DATE 7/25/83

SCALE 1" = 30'

DRWN BY B.M.M.

CHKD BY _____

JOB NO. 83-219

FS 470 PG 103

SITE PLAN

for JIM KOLLISTER
S/L 42 CONCORD · KELLOGG PARK ESTATES
SUBDIVISION VOL. X P. 13
PART OF LOTS 3 & 4, TRACT 3
CONCORD TWP. LAKE COUNTY, OHIO