

STONE HOLLOW
VOL. 15 Pg. 30

5/4 1

for : CARLA POLEMCHAK
CLIENT

9968 HOOSE RD MENTOR
ADDRESS STREET CITY

STATION NO.	SUBDIVISION NAME	VOL.	PAGE
18	CARRIAGE HILLS SUB. #2		
SUBLOT NO.			

LOT, TRACT	CONCORD 1 W.R.	OHIO
------------	----------------	------

LOT, TRACT

100



LAND DESIGN consultants
Civil Engineers and Surveyors
2005 EAST AVE. • BOSTON, MA 02108
TELEPHONE 360-6443 341-8120 661-1440


DESIGN CERTIFICATION

THIS PLAT WAS PREPARED BY ME, AND IS CORRECT TO THE
BEST OF MY KNOWLEDGE AND BELIEF.

NAME _____
K. J. Sullivan
4-15-83

CHECK LIST

LOT DIMENSIONS & BEARINGS -
 NE TO NEAREST STREET
 PLUMBLOT NW (PARCEL NO.)
 SURROUNDING OWNERS
 BUILDING DIMENSIONS
 DISTANCE TO NEAREST HIGHWAY -
 THUSSED GRADES
 SLOPE - 4 PERSON - TYPE, WD TH - THICKNESS
 SIDEWALK TYPE, WD TH, THICKNESS
 C/O VENT, TYPE, DIAH, LENGTH
 WATER MAIN SIZE, LOCATION
 SAN SEWER SIZE & GRADE, LOC.
 SAN MAIN, CAST IRON, IN, ELEV.
 SAN MAIN, CAST IRON, IN, ELEV.
 STORM SEWER SIZE & GRADE, LOC.
 STORM MAIN, CAST IRON, IN, ELEV.
 PAYT. TYPE, SIZE
 GAS LINE LOC., SIZE
 SEPT. SYSTEM & INSTALLATION
 WELL LOCATION & INSTALLATION -

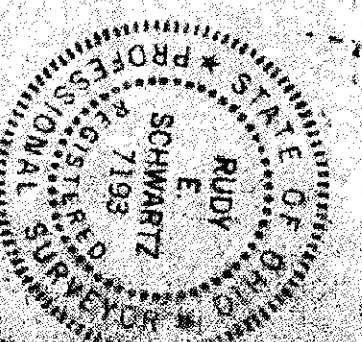

"AS BUILT" CERTIFICATION

I HEREBY CERTIFY THAT THE CIRCLED INFORMATION IS EXISTING AS OBTAINED ON THE SITE 10 AND IS CORRECT TO THE BEST OF MY KNOWLEDGE AND BELIEF.

Grading Plan Approved
as shown and/or noted
THOMAS P. GILLES, P.E.
Lake County Engineer

By Call Date 4/20/12

LEGEND

SAS

1:30

STORM MANHOLE
SANITARY MANHOLE
EXISTING CONCRETE

CHECK BY

DATE

**DIRECTION OF
SURFACE DRAINAGE**

2	

100

ACCEPTED :

CLIENT

DATE _____

BENCHMARK: R/M OF SAT. N.H. NO. 14, ELEV. 795.11

#0493-7420 ZONING PERMIT.

ISSUED 4-16-93

SUBJECT TO APPROVAL BY:

Lake County Sanitary Eng. 1

☒ Lake County Eng. Dept.

Lake County Planning Comm

Lake County Planning Comm.
Lake County Bldg. Dept. ☒

93-018
PLAYING NO. 2
HIT