


REV.	DESCRIPTION	DATE	BY	CHK'D.


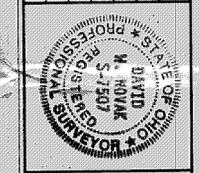


Himebaugh and Novak
 Surveyors and Site Consultants
 8663 Tyler Boulevard
 Mentor, Ohio 44060-4346
 (216) 974-7670, (216) 255-5900 FAX.

SOWL DEVELOPMENT GROUP
 7474 AUBURN ROAD, PAINESVILLE, OH 44077

DATE: AUG. 16, 1994
 DRAWN BY: D. W. NOVAK
 CHECKED BY: DWN
 APPROVED BY: [Signature]

SCALE: HORIZ.: 1"=30', VERT.: 1"=5'
 SHEET NO. 94-081-31 OF 3

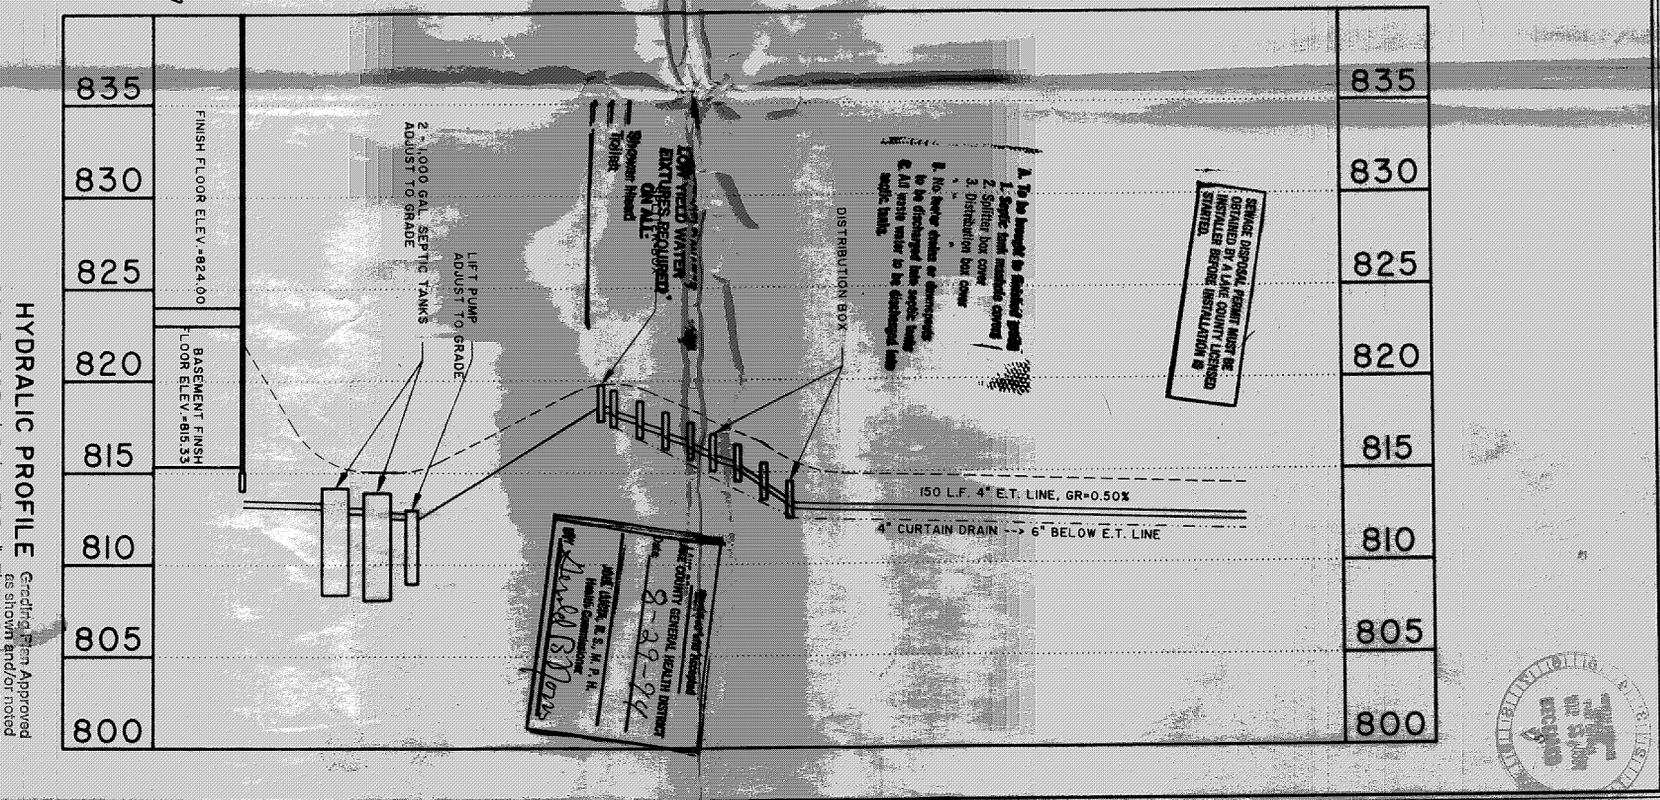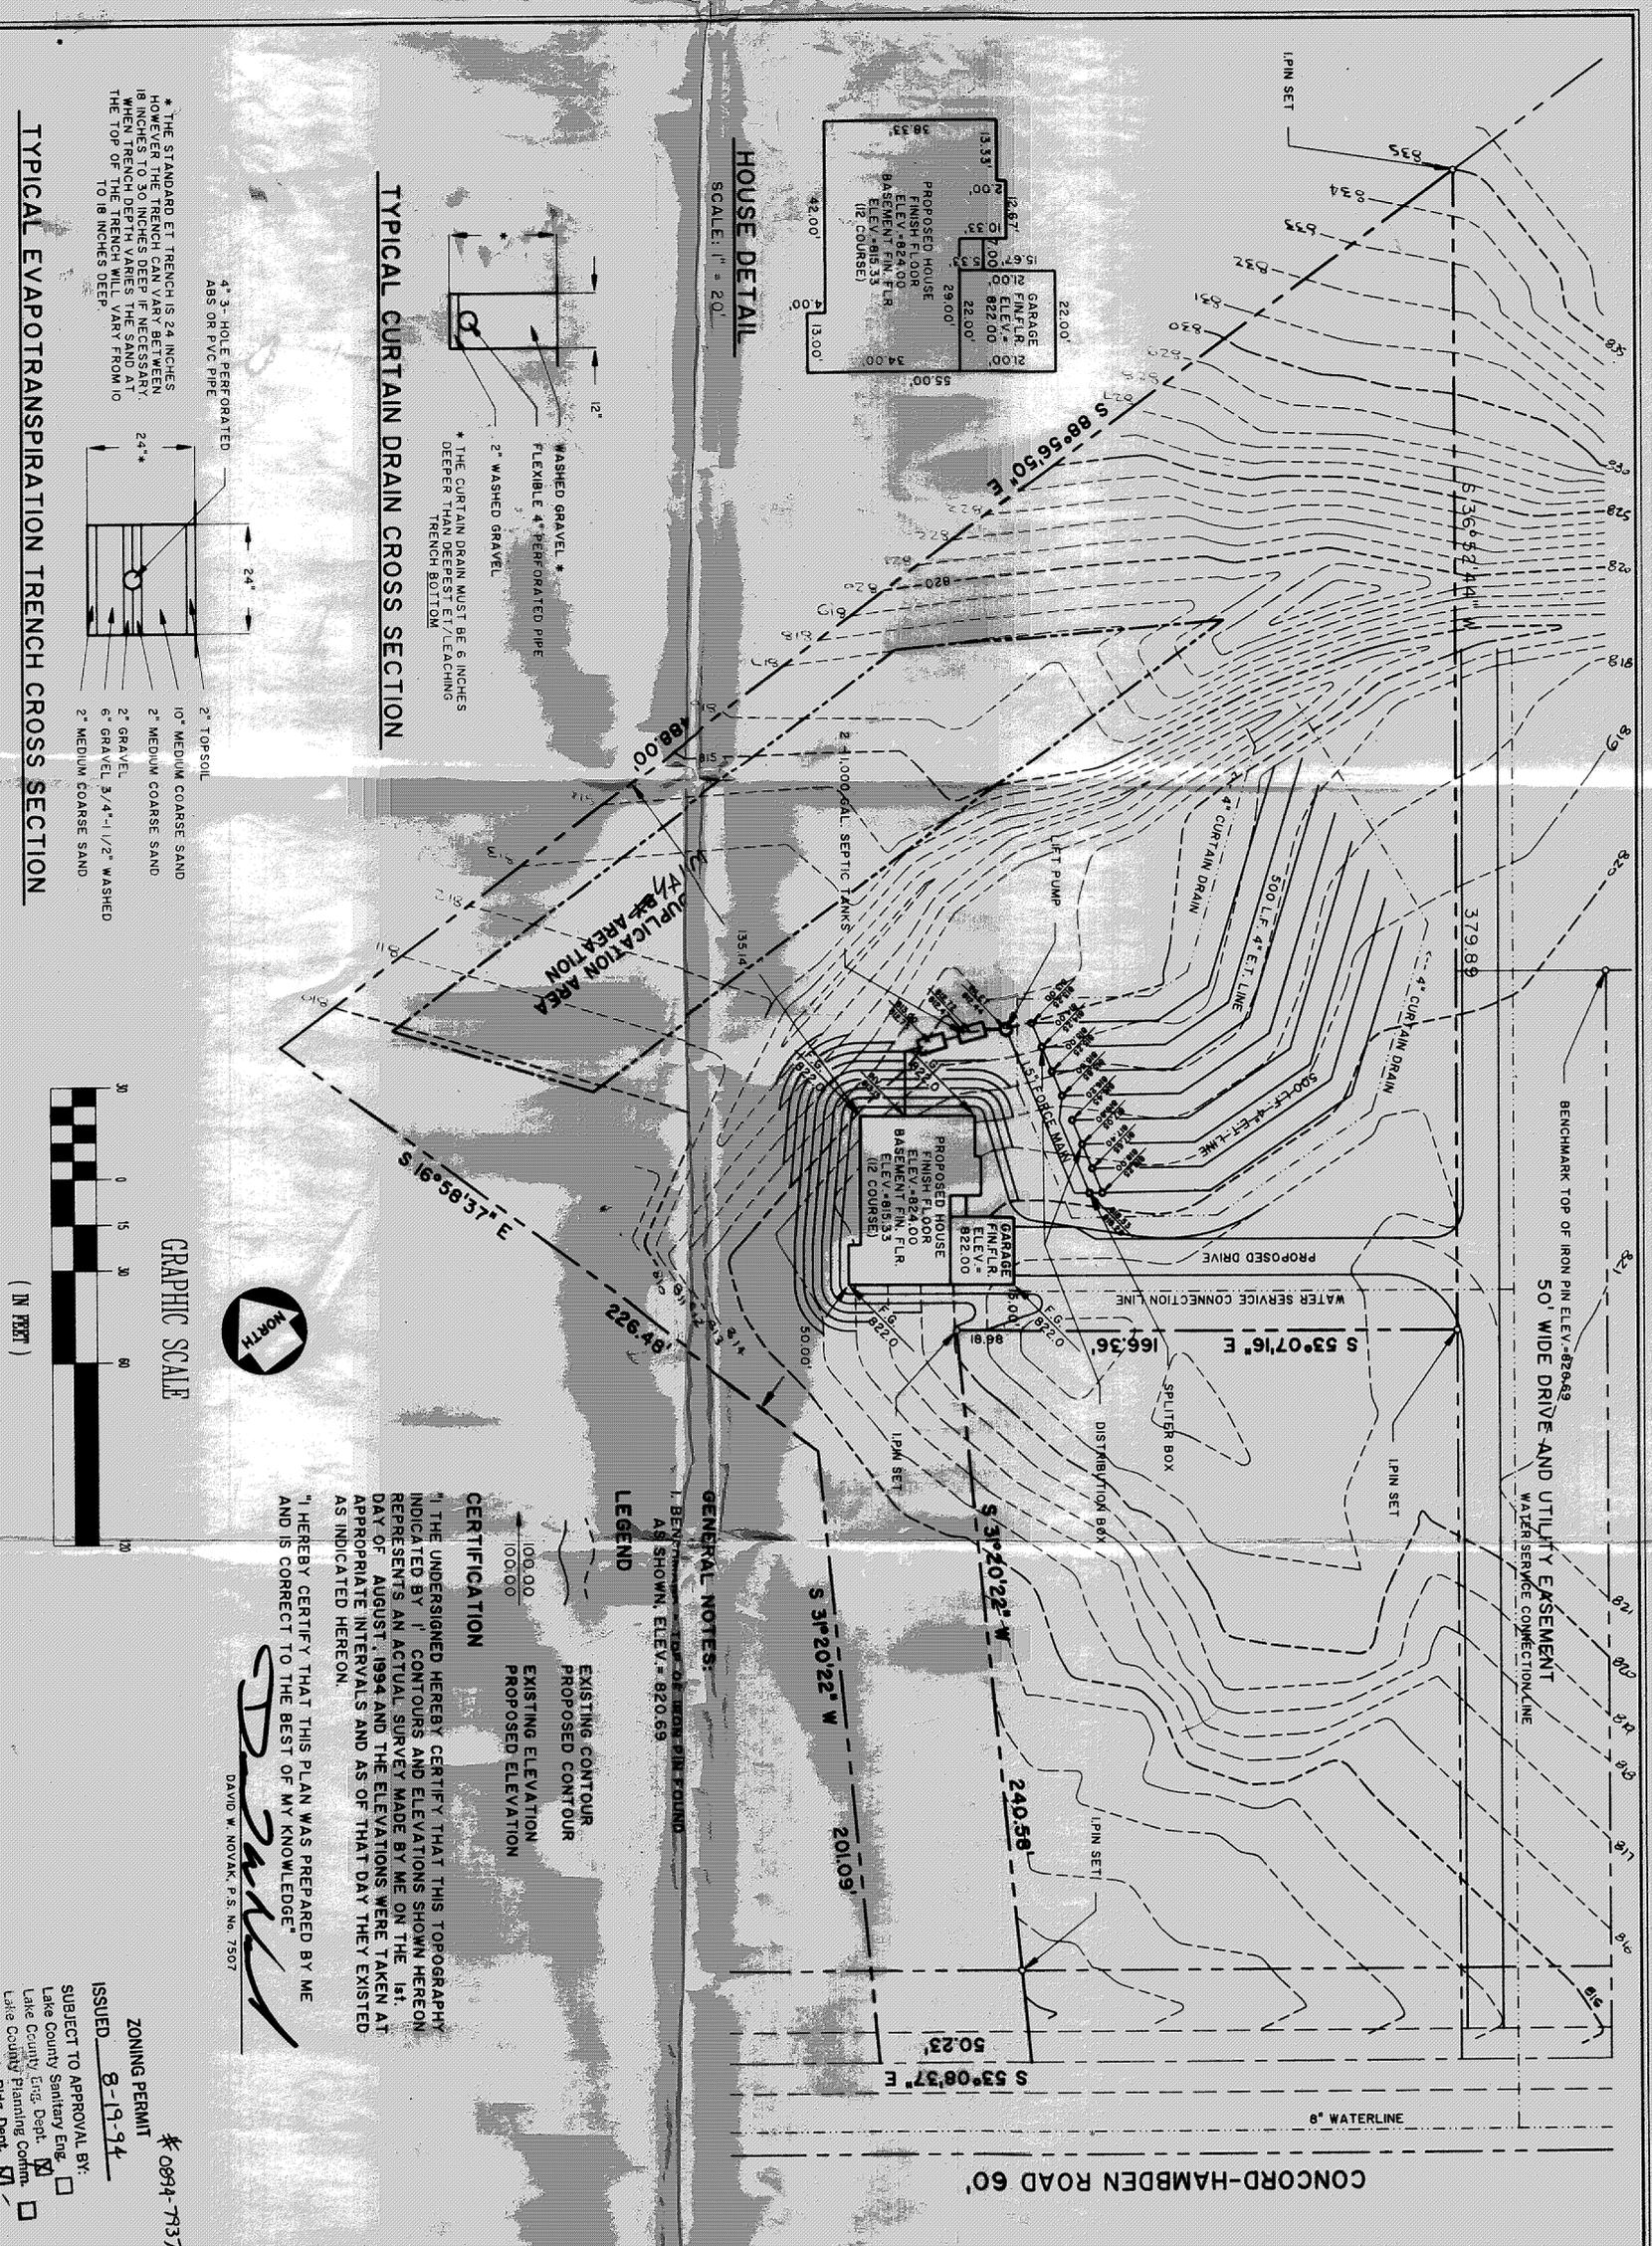

DATE: 10/3/94