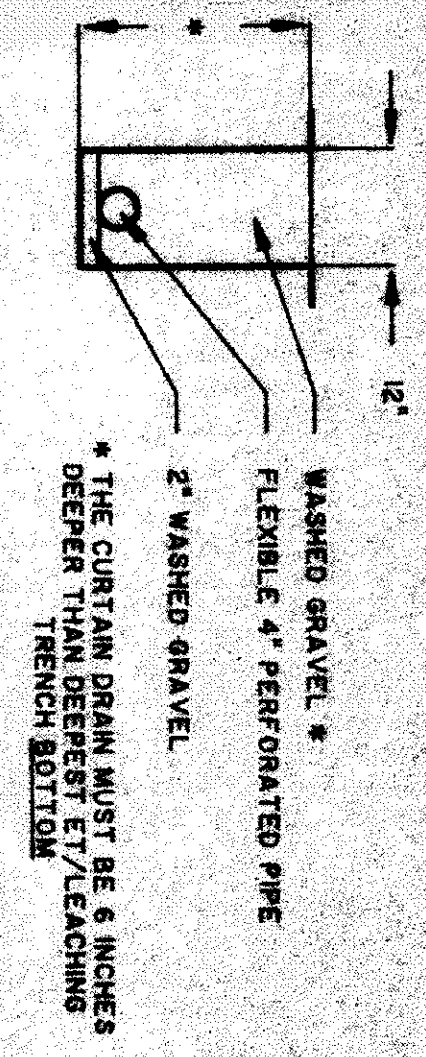
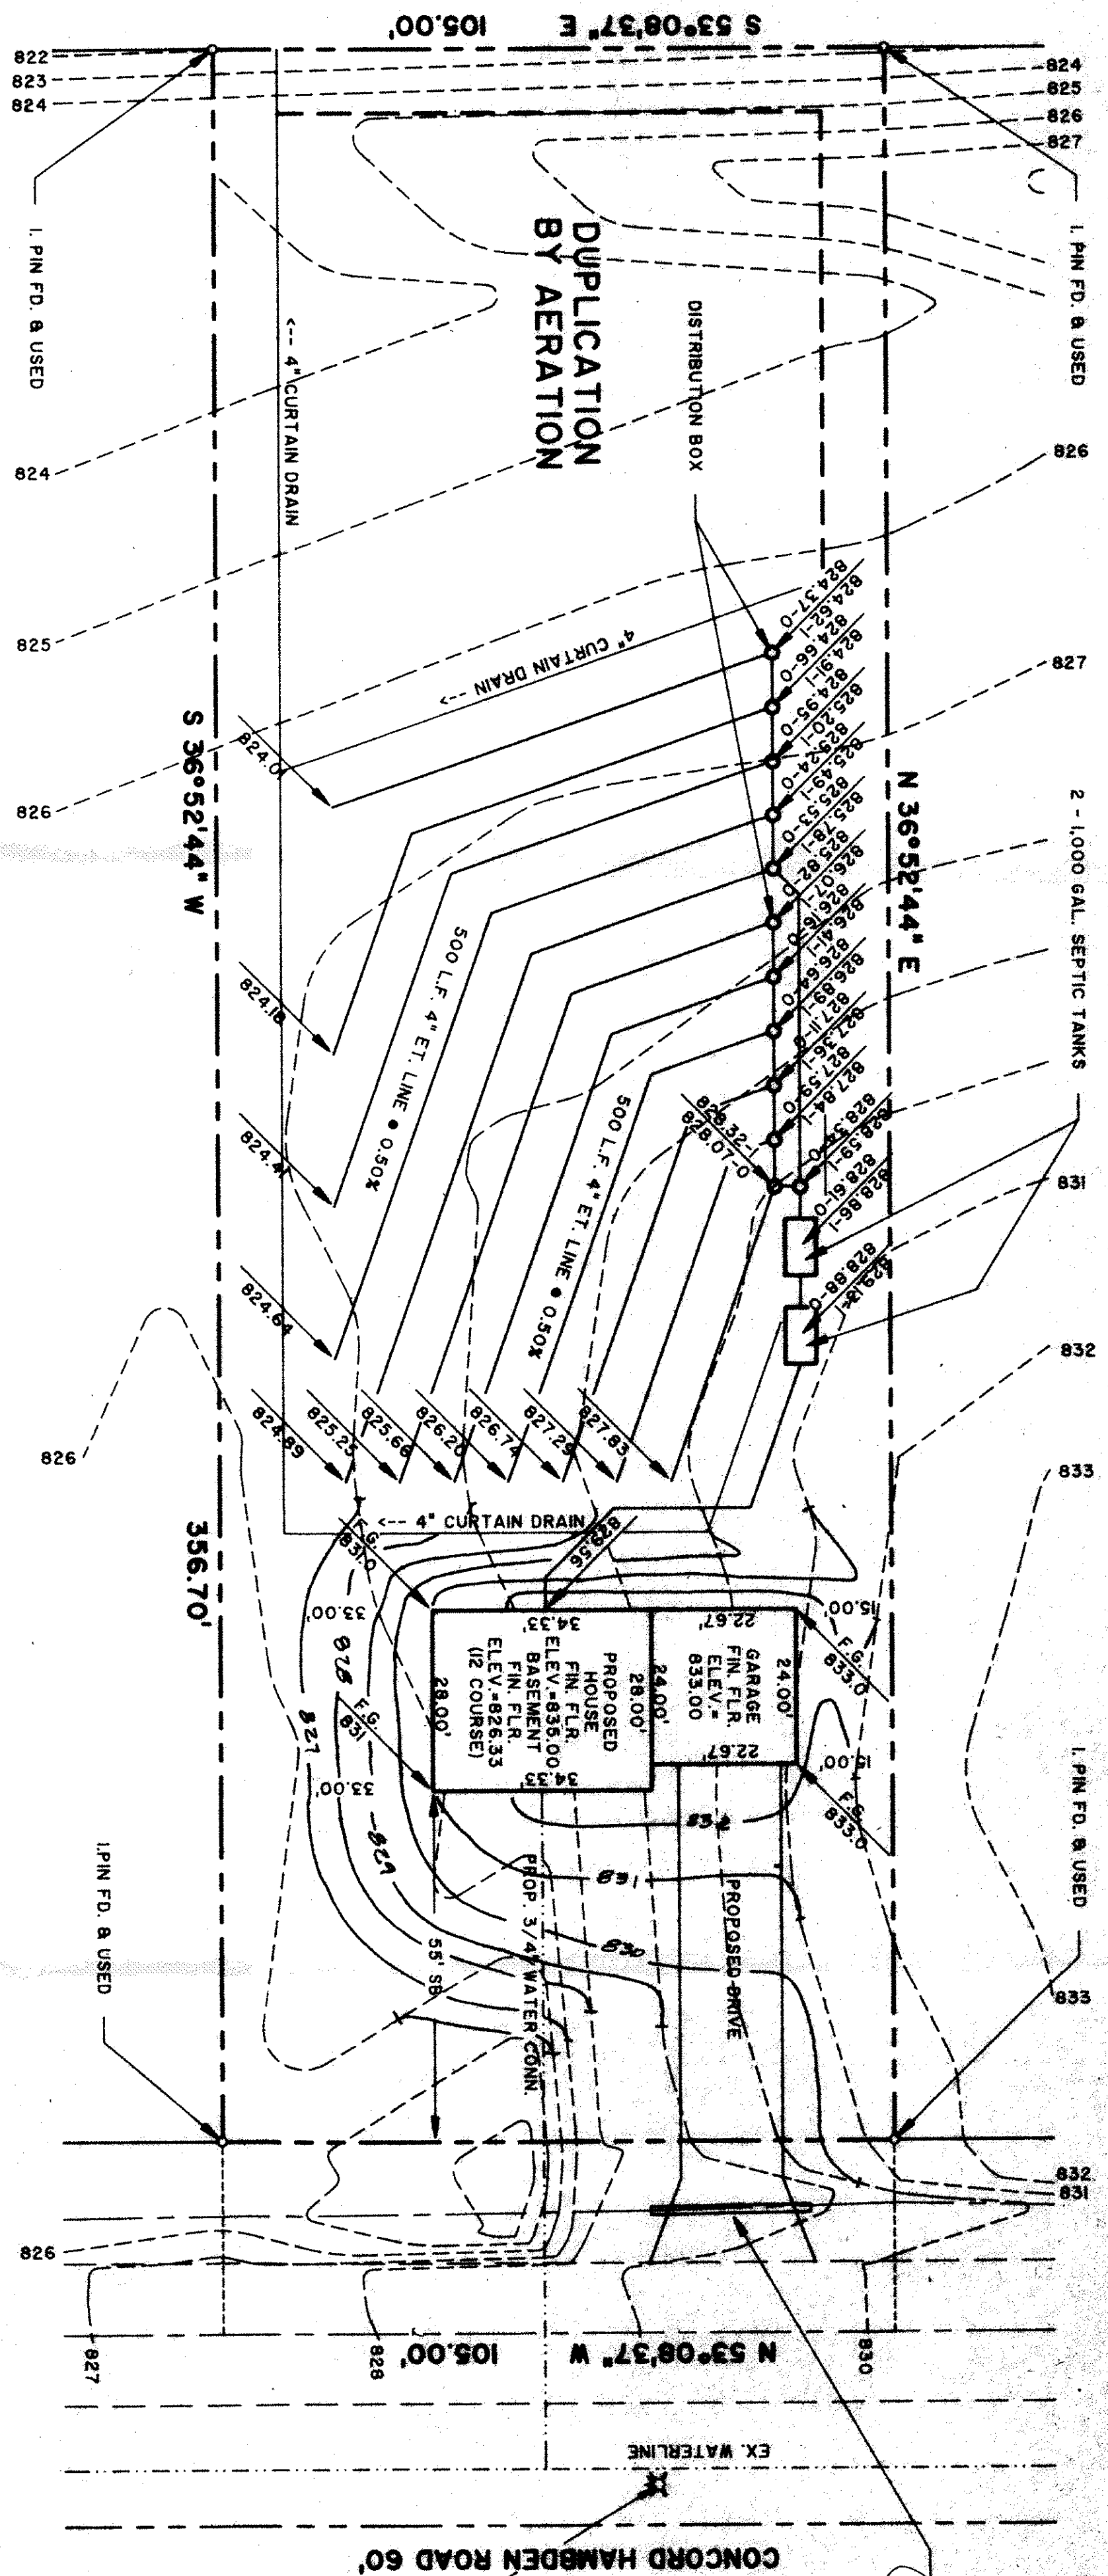


GENERAL NOTES:

1. DRIVEWAY APRON TO BE 6\"/>
2. BENCHMARK - TOP STEM OF FIRE HYDRANT LOCATED ACROSS FROM SUBLT NO. 35, ELEV.=831.16

LEGEND

- EXISTING CONTOUR
- PROPOSED CONTOUR
- EXISTING ELEVATION
- PROPOSED ELEVATION

CERTIFICATION

I, THE UNDERSIGNED HEREBY CERTIFY THAT THIS TOPOGRAPHY INDICATED BY THE CONTOURS AND ELEVATIONS SHOWN HEREON REPRESENTS AN ACTUAL SURVEY MADE BY ME ON THE 29TH DAY OF MARCH, 1994 AND THE ELEVATIONS WERE TAKEN AT APPROPRIATE INTERVALS AND AS OF THAT DAY THEY EXISTED AS INDICATED HEREON.



I HEREBY CERTIFY THAT THIS PLAN WAS PREPARED BY ME AND IS CORRECT TO THE BEST OF MY KNOWLEDGE.

DAVID W. NOVAK, P.S. No. 7507

ZONING PERMIT

ISSUED 4-14-94

- SUBJECT TO APPROVAL BY:
- ☐ Lake County Sanitary Eng.
 - ☒ Lake County Eng. Dept.
 - ☐ Lake County Planning Comm.
 - ☒ Lake County Bldg. Dept.

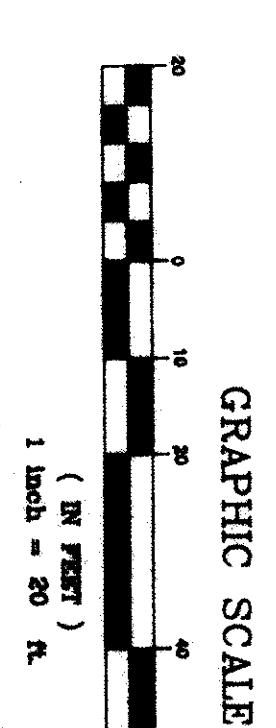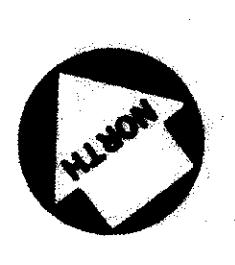

Grading Plan Approved as shown and/or noted THOMAS P. GILLES, P.E. Lake County Engineer

ROOF DRAINS SHALL DISCHARGE TO SPLASH BLOCKS.

REV. No.	DESCRIPTION	DATE	BY	CHK'D
A	REVISED DUPLICATION AREA TO AERATION	04/12/94	DWN	

DAVID W. NOVAK
P.S. No. 7507
MECHANICAL ENGINEERING
STATE OF OHIO

Himebaugh and Novak
Surveyors and Site Consultants
8663 Tyler Boulevard
Mentor, Ohio 44060-4346
(216) 974-7670, (216) 255-6900 FAX.

LITTLE MOUNTAIN HOMES, INC.
1447 NORTH RIDGE ROAD, PAINESVILLE, OH 44077

DATE	APR. 06, 1993
DESIGNED BY	D. W. NOVAK
CHECKED BY	DWN
APPROVED BY	
P.B. No.	P.B.

SCALE	1\"/>
VERT. 1\"/>	
CONTRACT No.	
SHEET No.	OF

94-027-35