


LOT 5
LOT 16

N 08° 46' 39" E

546.55'

LOT 16
LOT 15



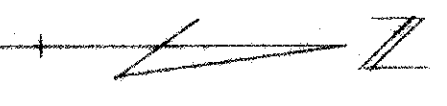


- A. To be brought to finished grade
1. Septic tank, manhole covers
 2. Siphon box cover
 3. Distribution box cover
- B. No toilet, shower or lavatory
to be discharged into septic tanks
- C. All waste water to be discharged into
septic tanks

LOW YIELD WATER
FIXTURES REQUIRED
ON ALL:
— Shower Head
— Toilet

SEWAGE DISPOSAL PERMIT MUST BE
OBTAINED BY A LAKE COUNTY LICENSED
INSTALLER BEFORE INSTALLATION IS
STARTED.


Reviewed and Accepted
LAKE COUNTY GENERAL HEALTH DISTRICT
Date 8-6-91
JOEL LUBAN, R. E., R. P. E.
Health Commissioner
JLub857 p005

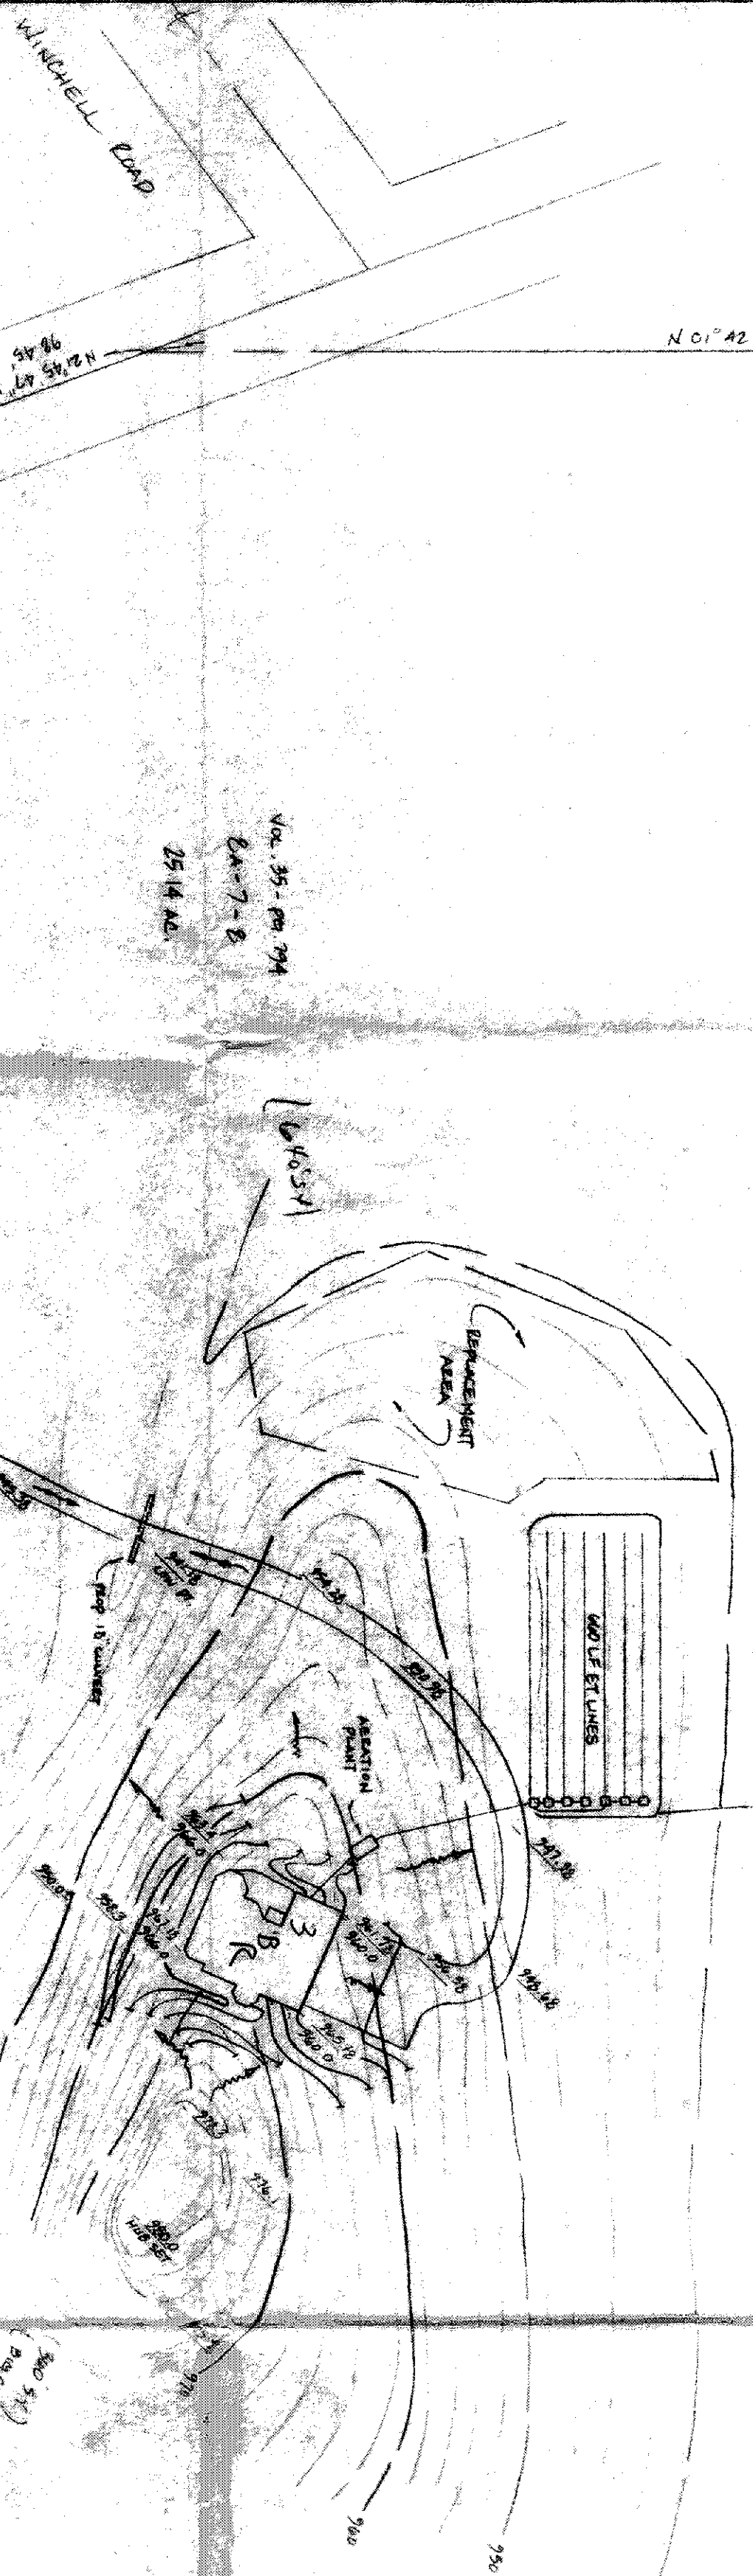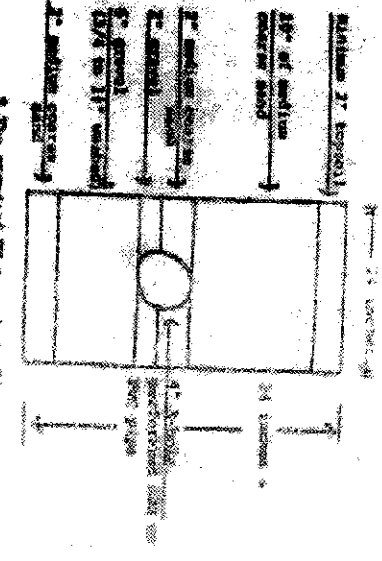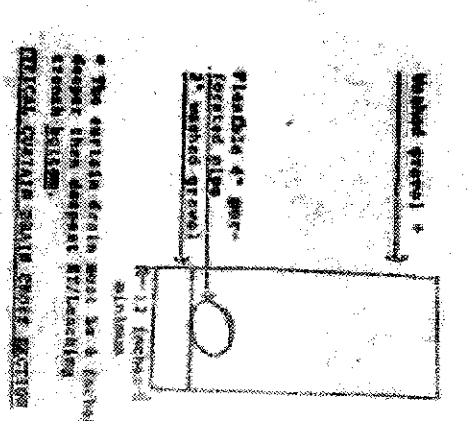


LAKE COUNTY
ID # P.S.V.
plus local
permits and building

C. Grading and/or approved
as approved/for noted
THOMAS B. JONES, P.E.
Landscape Engineer
Date 8/10/91


NOT PERMIT REQUIRED
- PORTION OF PROPERTY IS WITHIN
A FLOOD ZONE.

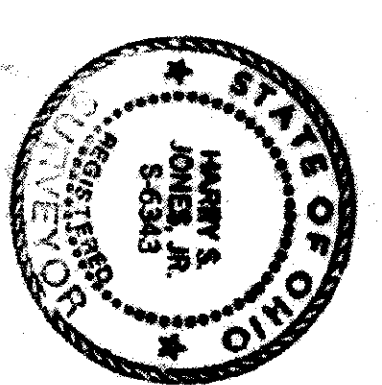

Paul J. Warner

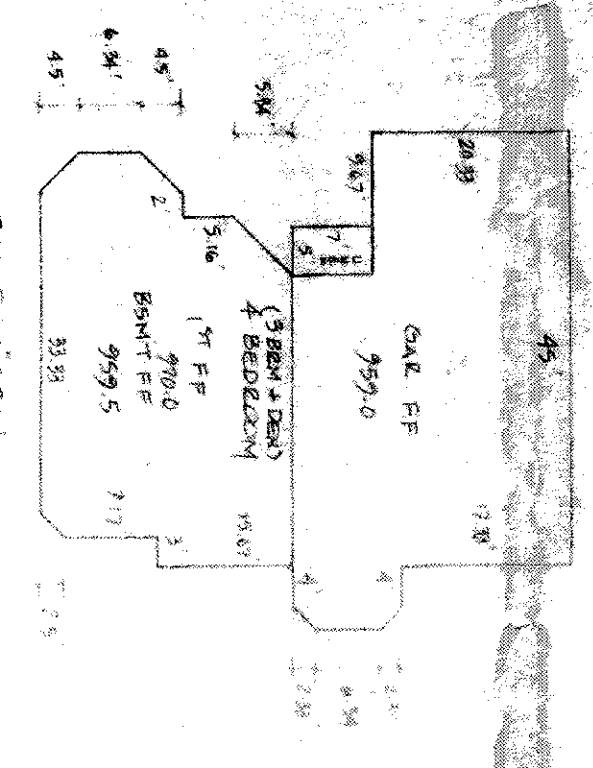

APPROXIMATE LOCATION OF PROPOSED NO. 2
SCALE: 1" = 20'

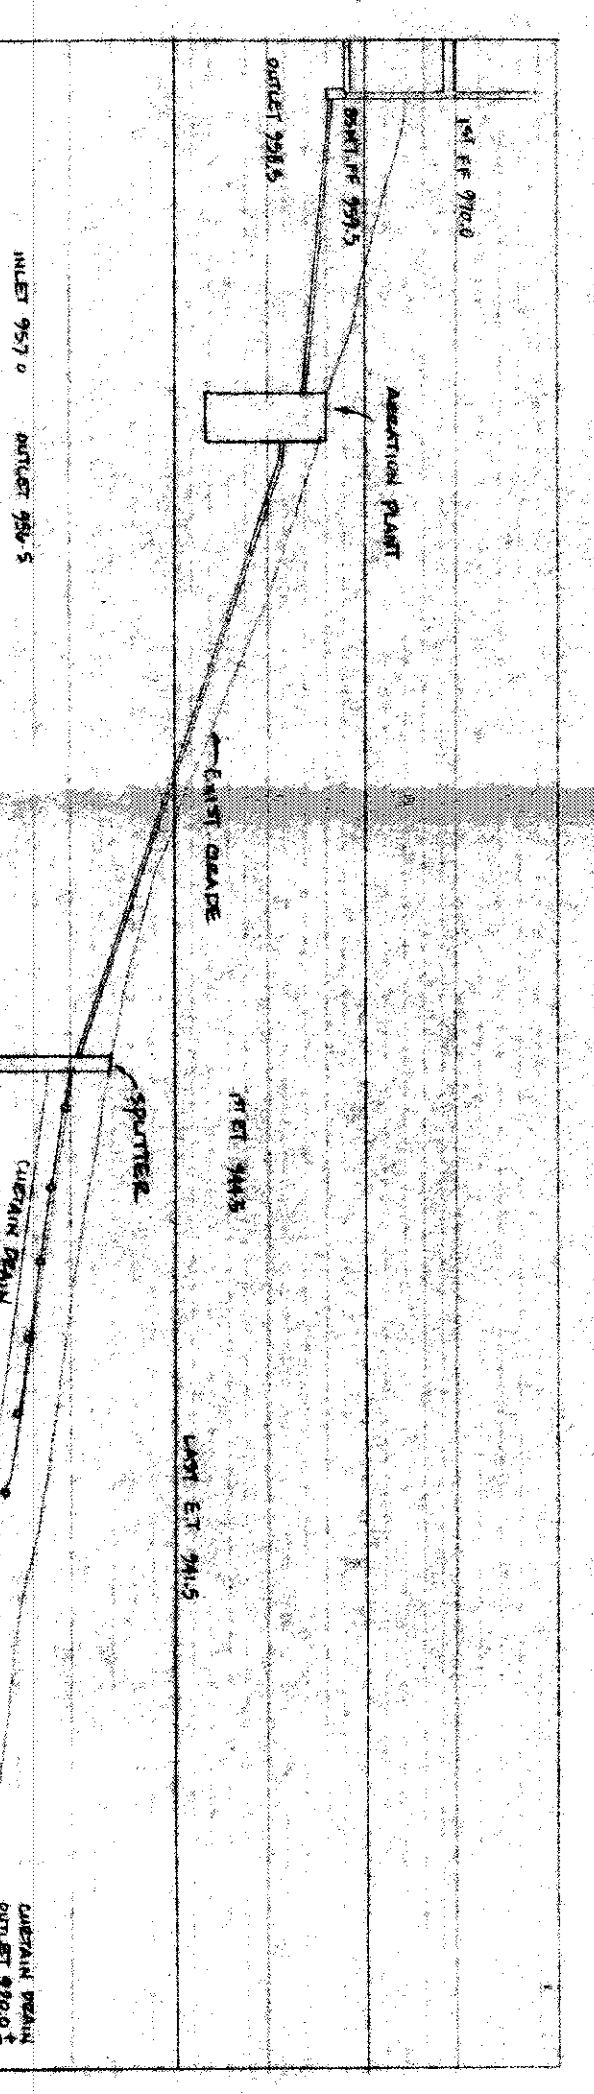

REV. NO.	DESCRIPTION	DATE	BY	CHK'D
1	CHANGE TO HEARTON W/ 600 LB ET UNITS	8-5-91	JB	

SITE PLAN FOR SHAMROCK CONSTRUCTION

B. BABCOCK, JONES AND ASSOCIATES, INC.
CIVIL ENGINEERS - SURVEYORS - LAND PLANNERS
PAINESVILLE OHIO 44077

DATE	8/2/91
DESIGN BY	
DRAWN BY	JB
APPROVED BY	

SITUATED IN THE TOWNSHIP OF CONCORD, COUNTY OF LAKE + STATE OF OHIO
TRACT NO. 1, LOT NO. 16, REEL # 8A-7-8
VOL. 84-1, PG. 106 OF LAKE COUNTY DEED RECORDS +
CONTAINING 75.14 ACRES