

As shown and/or noted
THOMAS P. GILLES, P.E.
Lake County Engineer

By DAVID W. NOVAK Date 7/1/99
Scale as shown
min 12" drive culvert

SUBLOT NO 6
0.5207 AC

GENERAL NOTES:

1. DRIVEWAY APRON TO BE 6" THICK
2. BENCHMARK - TOP STEM OF FIRE HYDRANT LOCATED IN FRONT OF SUBLOT No. 9 ELEV. = 785.89

LEGEND




EXISTING CONTOUR
PROPOSED CONTOUR
EXISTING ELEVATION
PROPOSED ELEVATION

CERTIFICATION

"I THE UNDERSIGNED HEREBY CERTIFY THAT THIS TOPOGRAPHY INDICATED BY 1" CONTOURS AND ELEVATIONS SHOWN HEREON REPRESENTS AN ACTUAL SURVEY MADE BY ME ON THE 25th DAY OF MAY, 1999 AND THE ELEVATIONS WERE TAKEN AT APPROPRIATE INTERVALS AND AS OF THAT DAY THEY EXISTED AS INDICATED HEREON.

"I HEREBY CERTIFY THAT THIS PLAN WAS PREPARED BY ME AND IS CORRECT TO THE BEST OF MY KNOWLEDGE"

David W. Novak
DAVID W. NOVAK, P.S. No. 7507

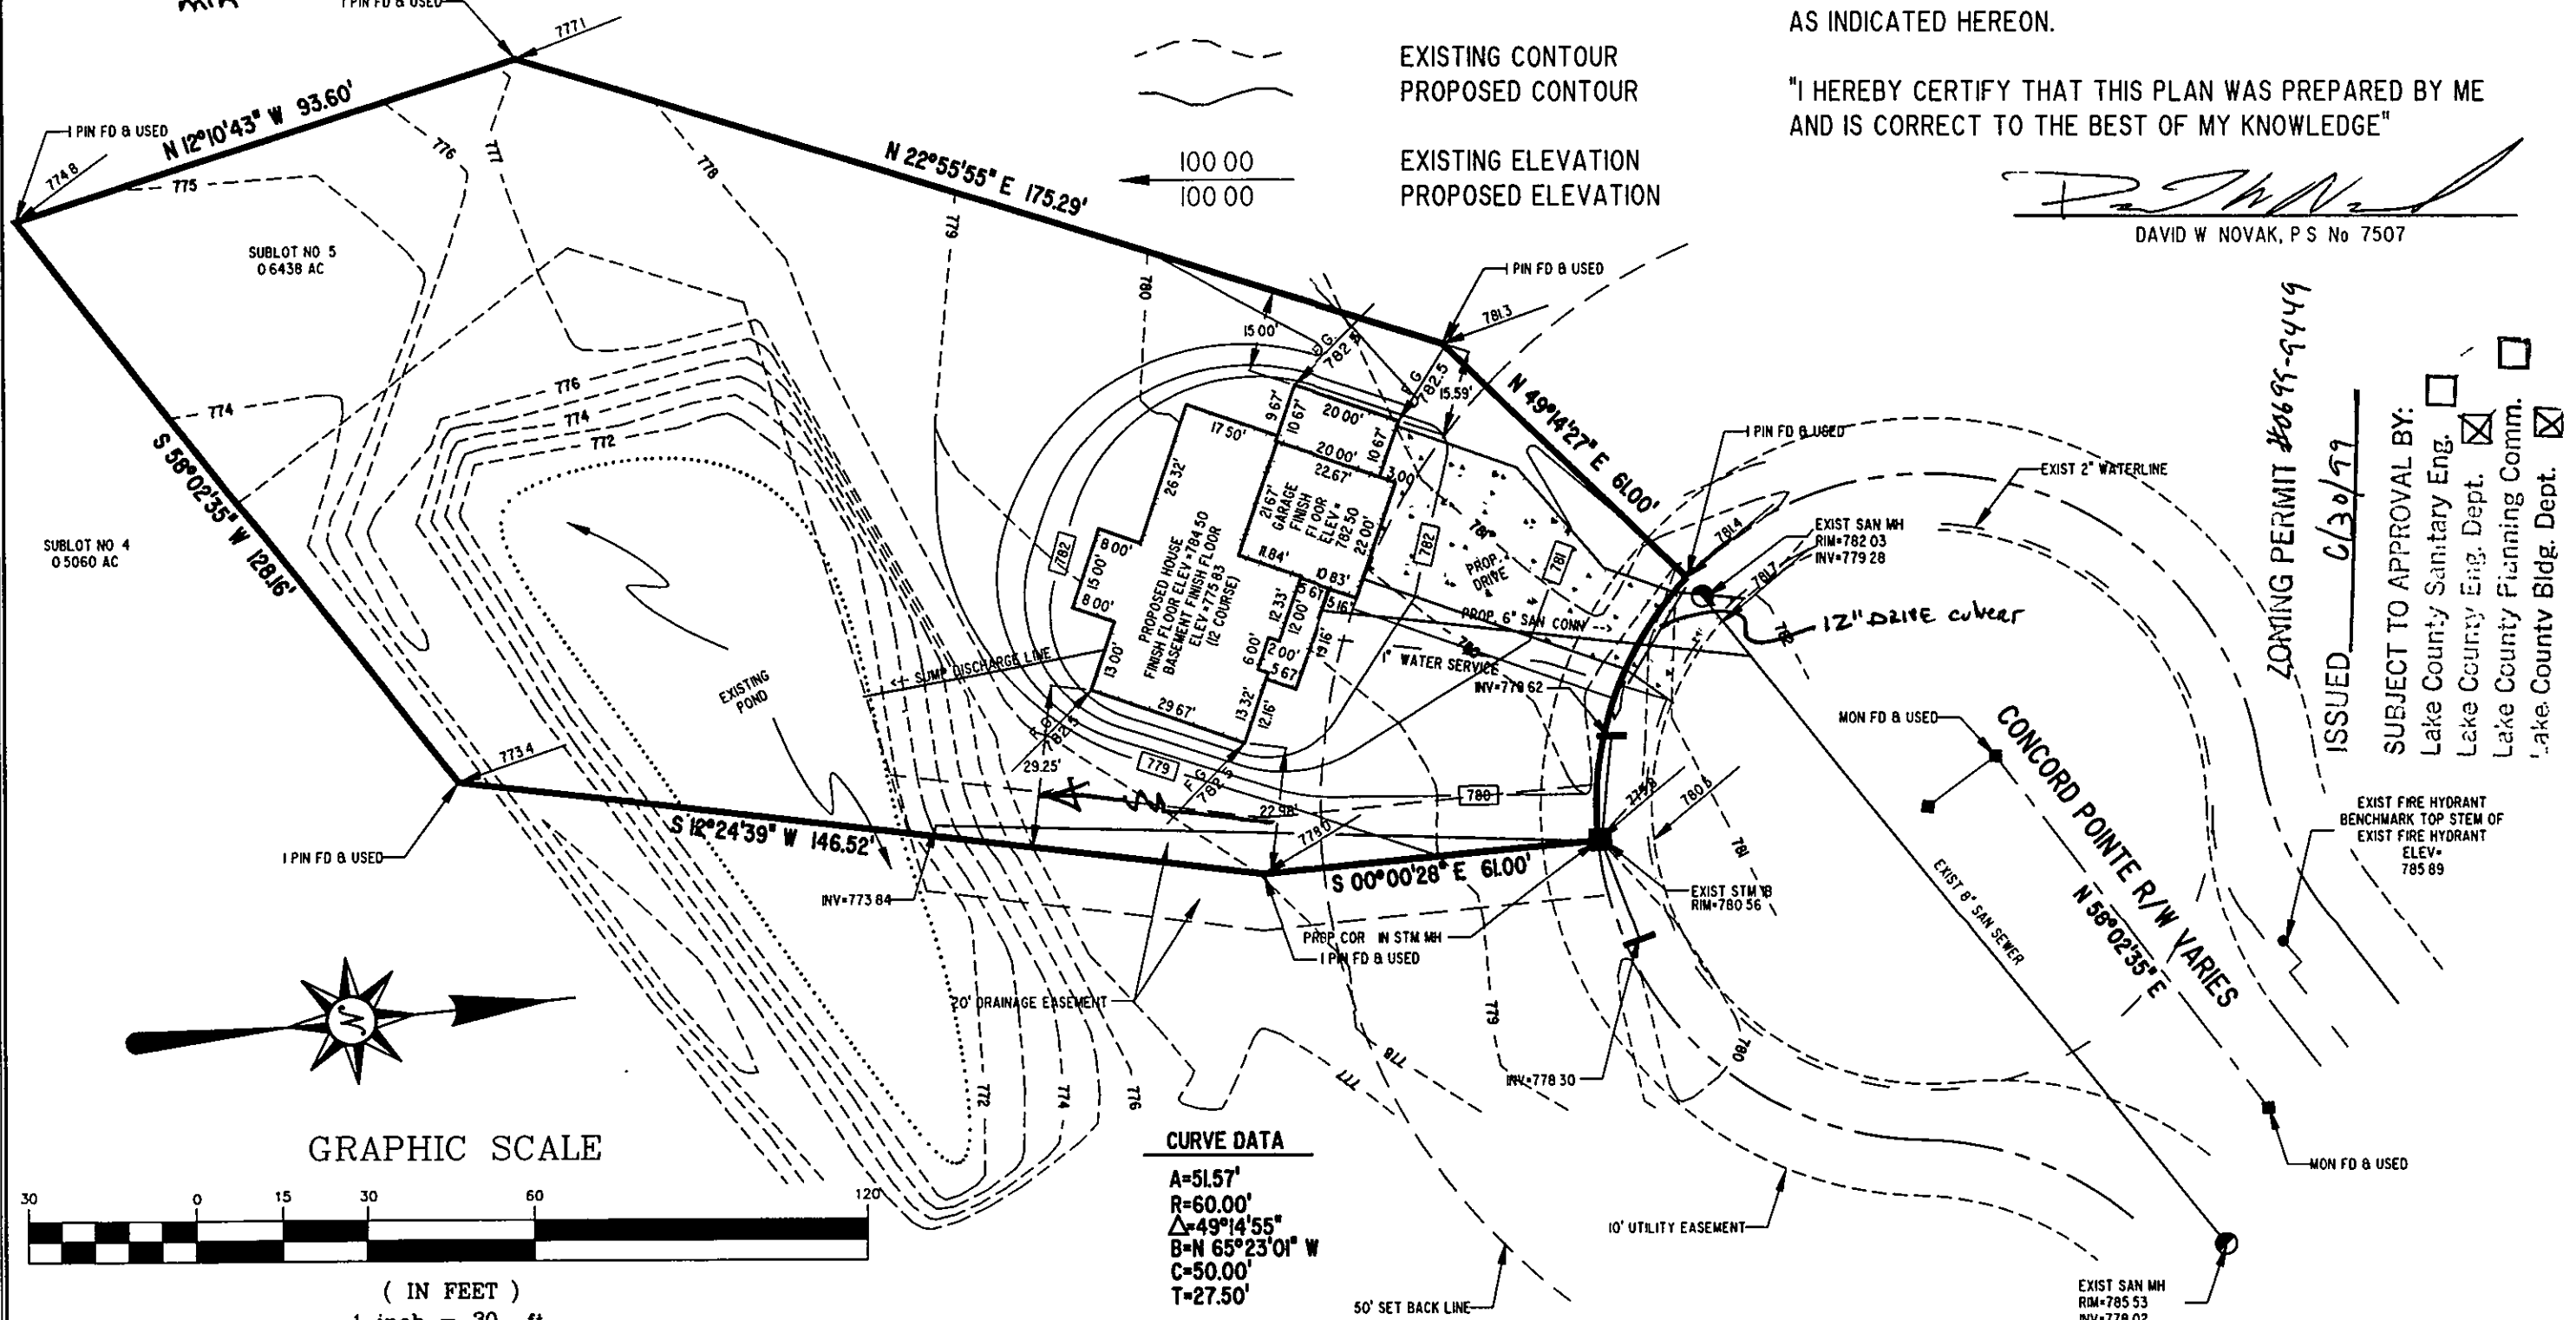

GRAPHIC SCALE




(IN FEET)
1 inch = 30 ft.

CURVE DATA

A=51.57'
R=60.00'
Δ=49°14'55"
B=N 65°23'01" W
C=50.00'
T=27.50'

REV	DESCRIPTION	DATE	BY	CHECKED

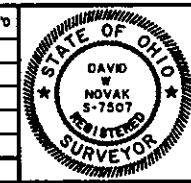

Himebaugh and Novak
Surveyors and Site Consultants
38342 Western Parkway, Unit 10
Willoughby, Ohio 44094
(440) 946-1761, (440) 918-0486 Fax.

LITTLE MOUNTAIN HOMES, INC.
1447 NORTH RIDGE ROAD, PAINESVILLE, OH. 44077

DATE: MAY 20, 1999
DRAWN BY: C.R. KRAFT
CHECKED BY: DWN
APPROVED BY:

SITE PLAN
SUBLOT NO. 5 CONCORD POINTE CT., CONCORD, OH. 44077
CONCORD POINTE SUBDIVISION, CONCORD

SCALES	
HORIZ: 1" = 30'	
VERT: NONE	
CONTRACT NO.	
99058-5	
SHEET NO.	OF
1	1